
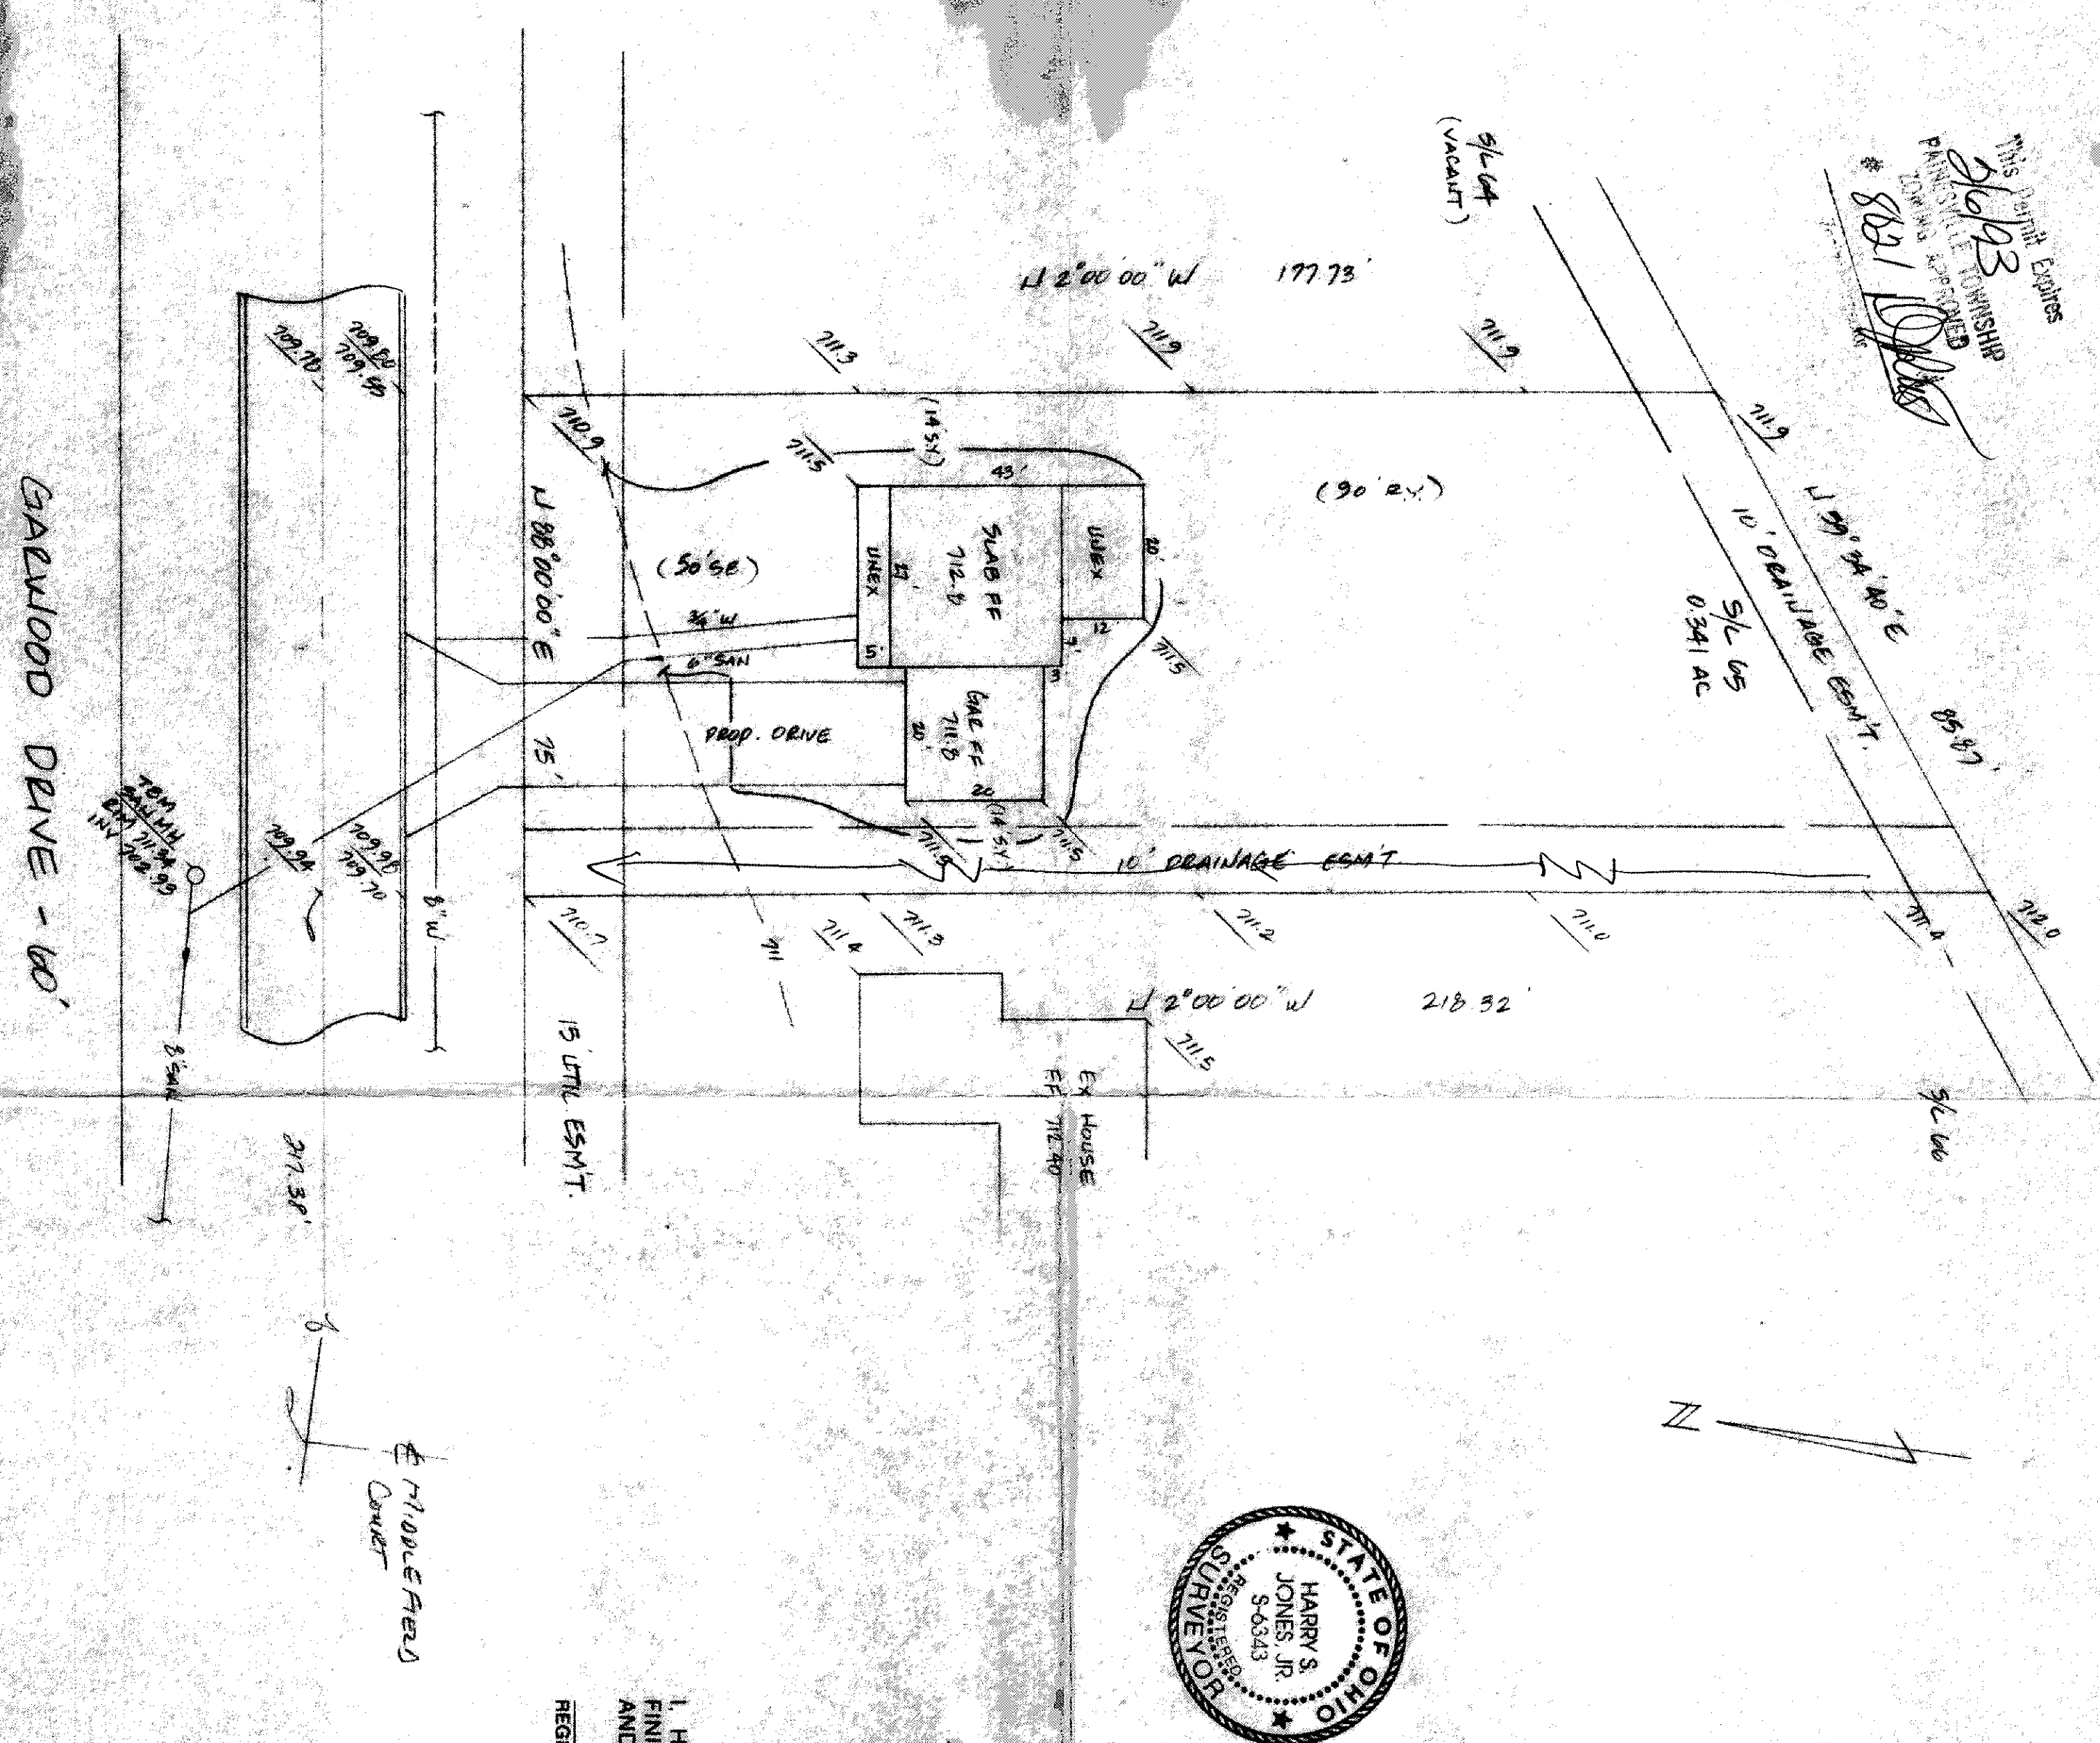


This Plat Expires
3/6/93
PAINESVILLE, OHIO
JULY 10, 1993
8821

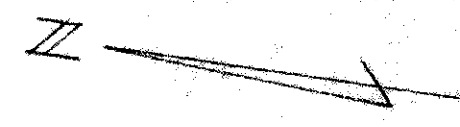

SITE PLAN

PAINESVILLE TWP, LAKE COUNTY, OHIO

for: STEVE FETTERER


ADDRESS	STREET	CITY	ZIP
HEATHERSTON SUB			
SUBDIVISION	NAME	LOT	TRACT
15	15	15	15
SUBLOT NO.	STREET	VOLUME	PAGE
15	15	15	15
PERM. PARCEL NO.	STREET		

LEGEND	INDICATES
SANITARY MANHOLE	WATER VALVE (GAS)
STORM MANHOLE	WATER METER (GAS)
INLET OR CATCH BASIN	AS BUILT ELEVATION
HYDRANT	INDICATES
EXISTING CONTOURS	DIRECTION OF
PROPOSED CONTOURS	SURFACE DRAINAGE
EXIST. ELEV.	
PROP. ELEV.	

REMARKS

ALL BOUNDARY DATA SHOWN WAS OBTAINED FROM DEEDS, RECORDED SUBDIVISION PLAT OR OTHER PUBLIC RECORDS.

LOCATIONS AS SHOWN OF ADJACENT WELLS AND SEPTIC TANKS OBTAINED FROM LAKE COUNTY HEALTH DEPARTMENT

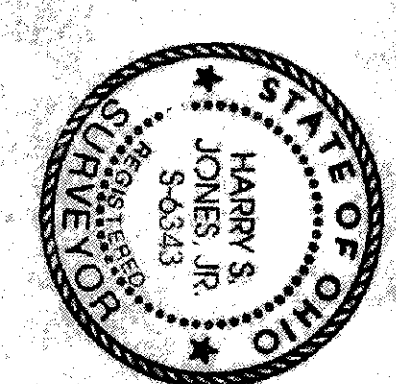

DESIGN CERTIFICATION

THIS PLAN WAS PREPARED BY ME, AND IS CORRECT TO THE BEST OF MY KNOWLEDGE AND BELIEF.

NAME: HARRY S. JONES, JR.
SURVEYOR REGISTRATION NO. 54343

CHECK LIST

NO. OF REVISIONS	DATE	BY
1		
2		
3		
4		
5		

REVISIONS

NO.	DATE	BY	DESCRIPTION
1			
2			
3			
4			
5			

"AS BUILT" CERTIFICATION

I, HEREBY CERTIFY THAT THE CIRCLED GRADES ARE EXISTING FINISH GRADES CHECKED IN THE FIELD ON 19__

AND ARE CORRECT TO THE BEST OF MY KNOWLEDGE AND BELIEF.

REGISTERED SURVEYOR

REG. NO.

TBM: BIRMINGHAM, ELEV. - 711.54

Grading Plan Approved
as shown and/or noted
THOMAS P. GILLES, P.E.
Lake County Engineer

By: [Signature]
Date: 2/11/92

Provide Swale within West Drainage ESMIT to Roadway.