


GREEN STREET, 60' ROW


# SITE PLAN

ALL THAT CERTAIN LANDS SITUATE IN LOTS 54 & 55, VILLAGE OF PERRY, TOWNSHIP NO. 11 NORTH, RANGE VII WEST, IN THE CONNECTICUT WESTERN RESERVE SURVEY, COUNTY OF LAKE, STATE OF OHIO. A RESURVEY OF LANDS TO SCOTT P. SCHAFER AS RECORDED IN DEED VOLUME 882, PAGE 949 IN THE OFFICE OF THE COUNTY RECORDER.

REVIEWED AND ACCEPTED  
LAKE COUNTY GENERAL  
HEALTH DISTRICT  
5-4-00  
David B. Davis  
SEWAGE DISPOSAL PERMIT MUST BE  
OBTAINED BY A LAKE COUNTY LICENSED  
INSTALLER BEFORE INSTALLATION IS  
STARTED

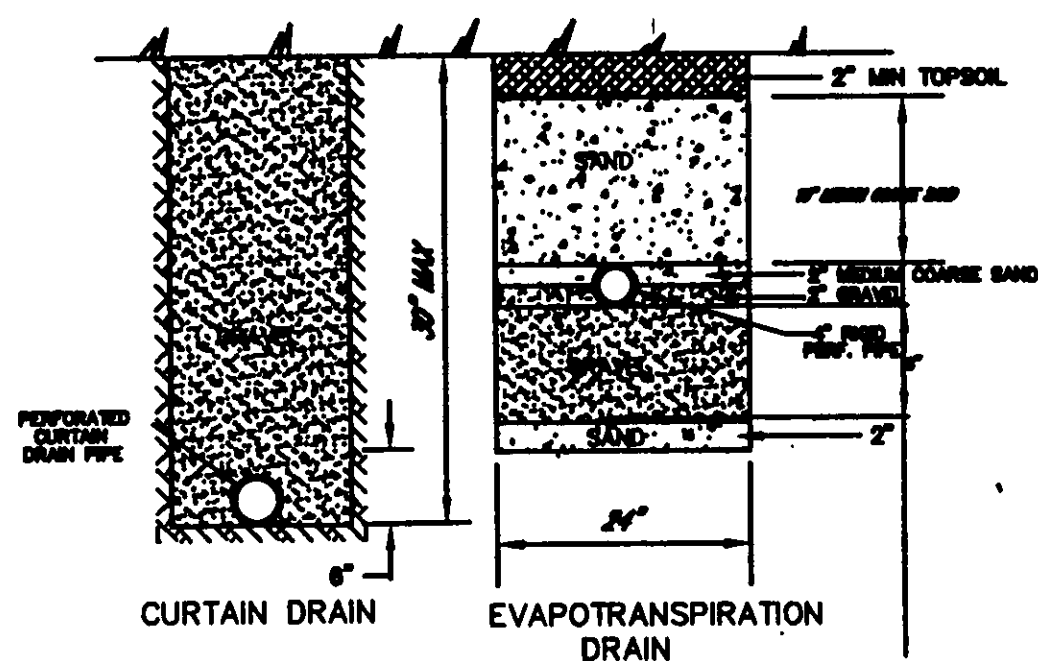


BASIS OF BEARINGS ARE TO AN  
ASSUMED MERIDIAN ALONG THE  
CENTERLINE OF GREEN STREET  
NORTH 01°30'25" EAST

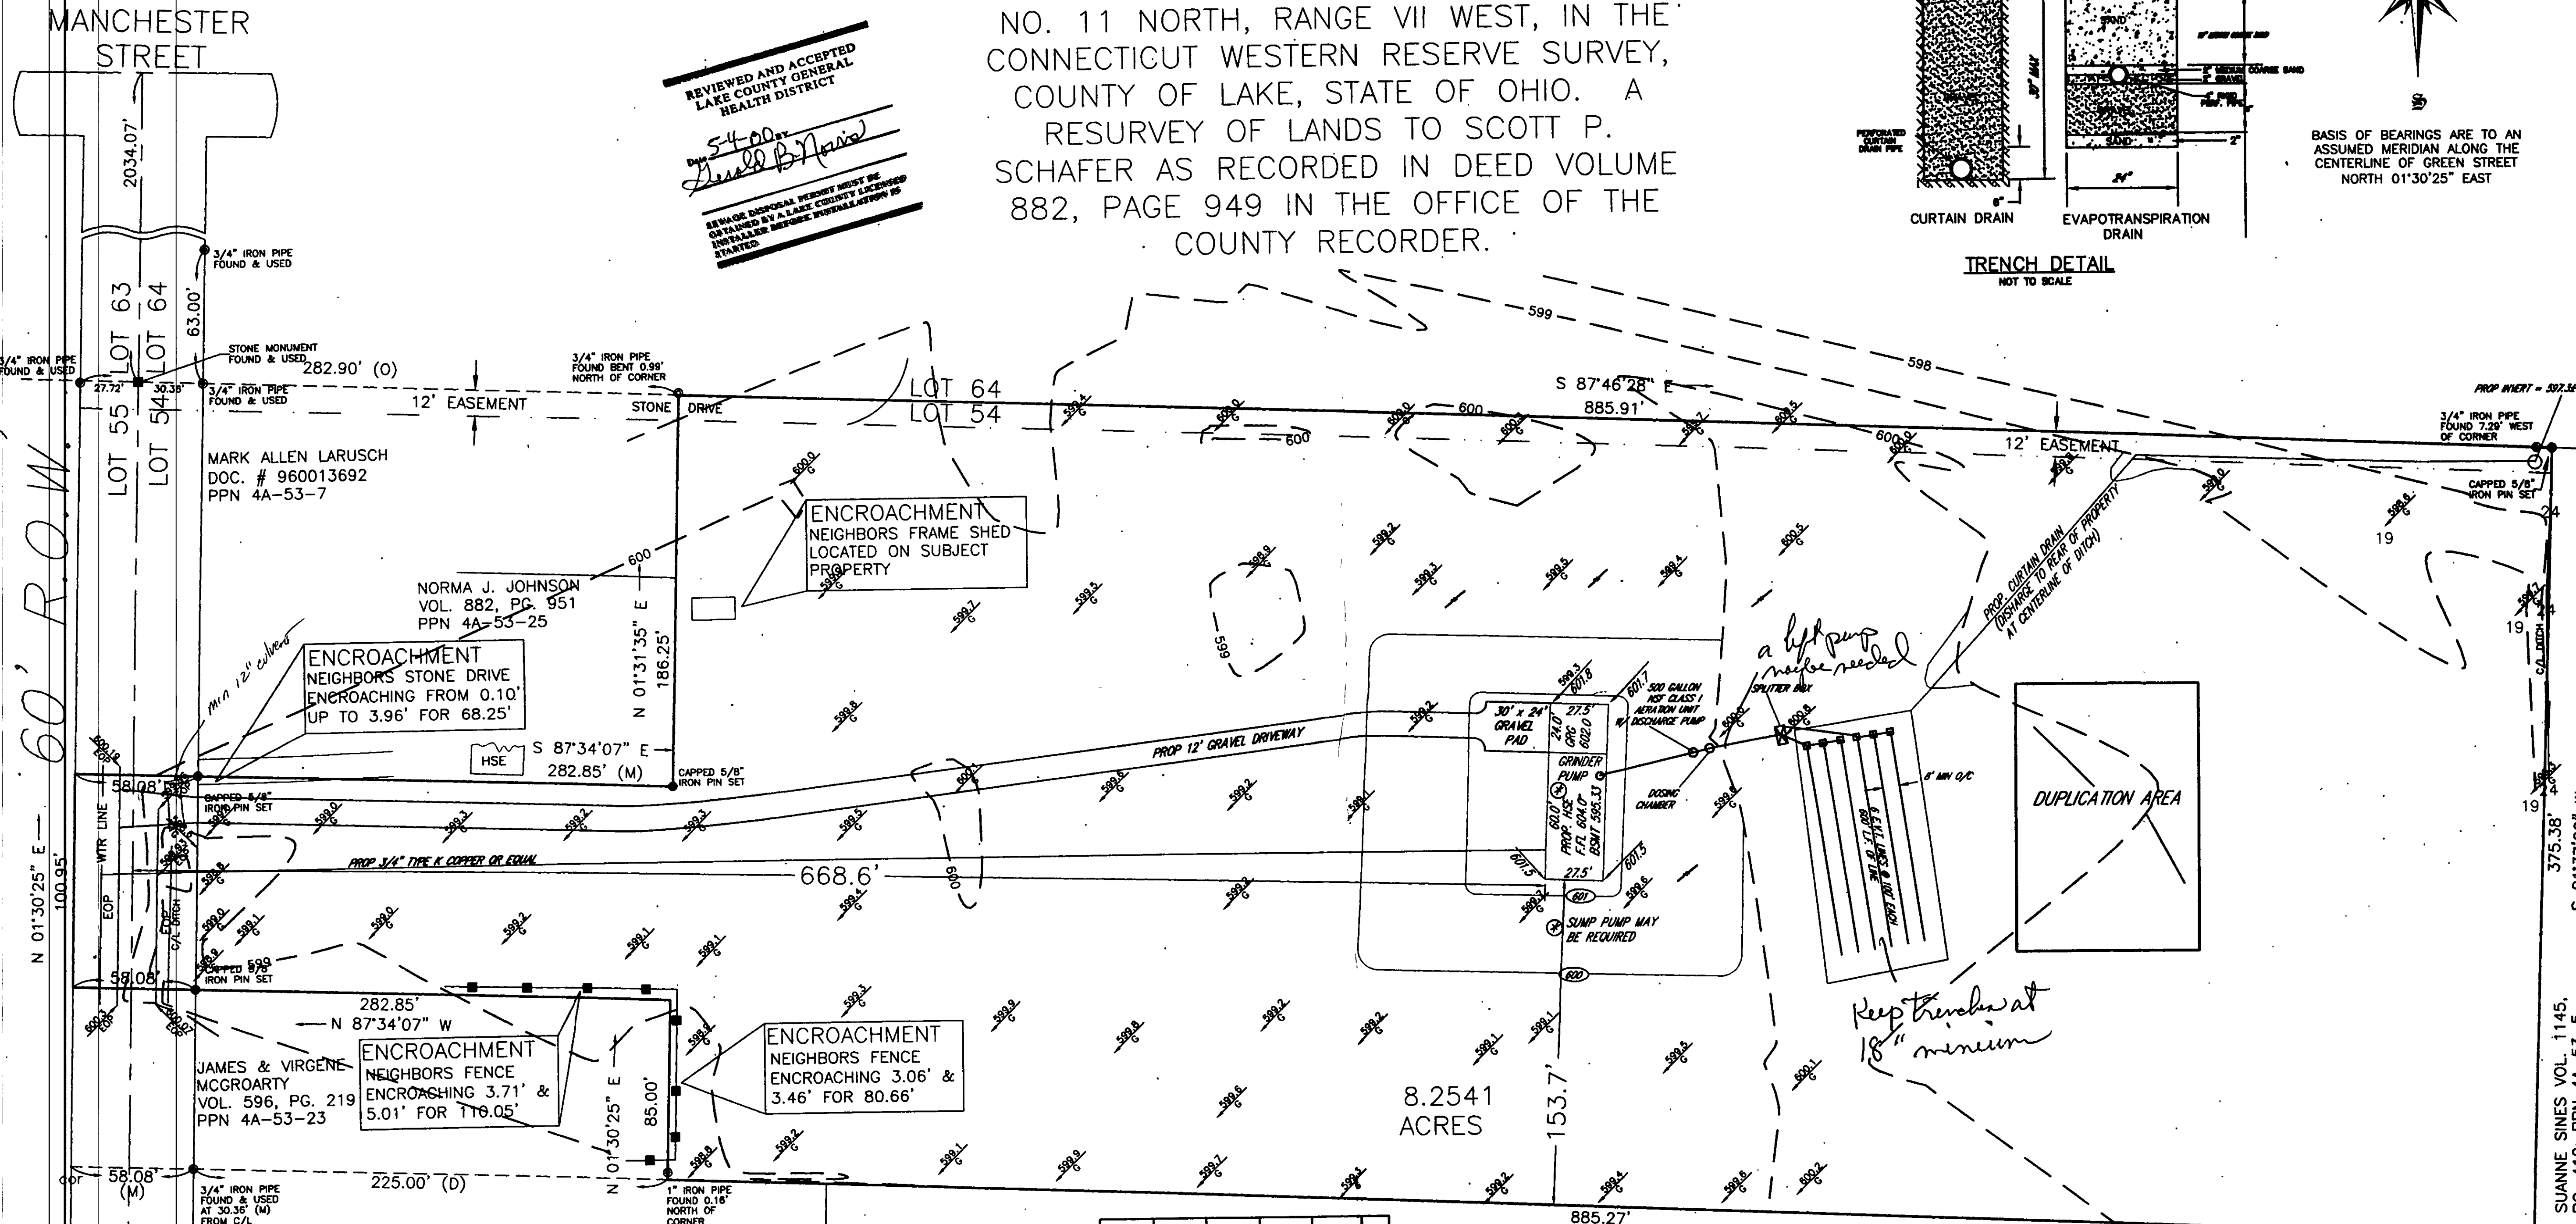

SCALE: 1" = 40'

|                   |       |      |
|-------------------|-------|------|
| DATE OF ORIGINAL: | MARCH | 2000 |
| REVISION:         | DATE: | 2000 |
| REVISION:         | DATE: | 2000 |
- LEGEND
- IRON PIPE FOUND
  - STONE MONUMENT
  - IRON PIN FOUND/SET
  - (C) CALCULATED
  - (M) MEASURED
  - (O) OBSERVED
  - (D) DEED RECITED
  - (P) PLAT RECITED

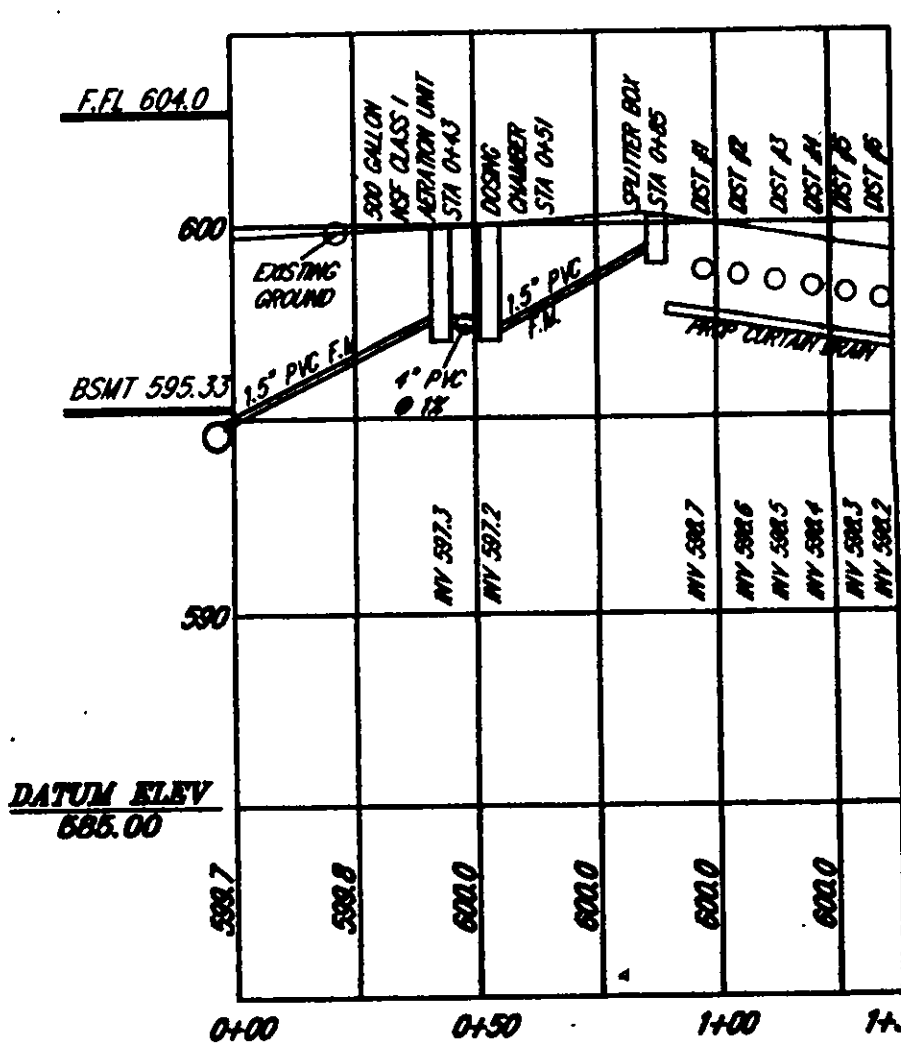

SEPTIC PROFILE:  
HORIZONTAL SCALE: 1" = 40'  
VERTICAL SCALE: 1" = 5'

" I THE UNDERSIGNED HEREBY CERTIFY THAT THE TOPOGRAPHY SHOWN HEREON INDICATED BY 1' CONTOURS AND ELEVATIONS REPRESENTS AN ACTUAL FIELD SURVEY MADE BY ME ON THE 12TH DAY OF MARCH, 2000 AND THAT THE ELEVATIONS WERE TAKEN AT APPROPRIATE INTERVALS AND THAT AS OF THAT DATE THE EXISTED AS INDICATED HEREON.

DATE: April 25, 2000  
TIMOTHY E. STOCKER P.S. 7245

STATE OF OHIO  
No. 7245  
T.E.S.  
REGISTERED  
PROFESSIONAL SURVEYOR

|                                                                                                                                                                            |                |      |             |
|----------------------------------------------------------------------------------------------------------------------------------------------------------------------------|----------------|------|-------------|
| CHK: T. STOCKER                                                                                                                                                            | DRN: S. LOWERY | REV: | PAGE 1 OF 1 |
| PROJECT ADDRESS:<br>V/L GREEN STREET<br>PERRY VILLAGE                                                                                                                      |                |      |             |
| JOB NUMBER: 2386                                                                                                                                                           |                |      |             |
| PROJECT NAME:<br>SITE PLAN                                                                                                                                                 |                |      |             |
| PROJECT LOCATION:<br>LAKE COUNTY, OHIO                                                                                                                                     |                |      |             |
| PREPARED FOR:<br>SCOTT SCHAFER                                                                                                                                             |                |      |             |
| FOR INQUIRIES CONCERNING THIS SURVEY CONTACT:<br>U.S. SURVEYOR<br>CRADDOCK'S SURVEYING SERVICE<br>10 WEST ABBEY STREET, SUITE 101<br>PALMISTON, OH 44074<br>1-800-488-3968 |                |      |             |