


Grading Plan Approved  
as shown and/or noted  
by **THOMAS P. GILLES, P.E.**  
Late County Engineer  
Date 4/20/93

ROOF DRAINS  
SHALL DISCHARGE  
TO SPLASH BLOCKS.

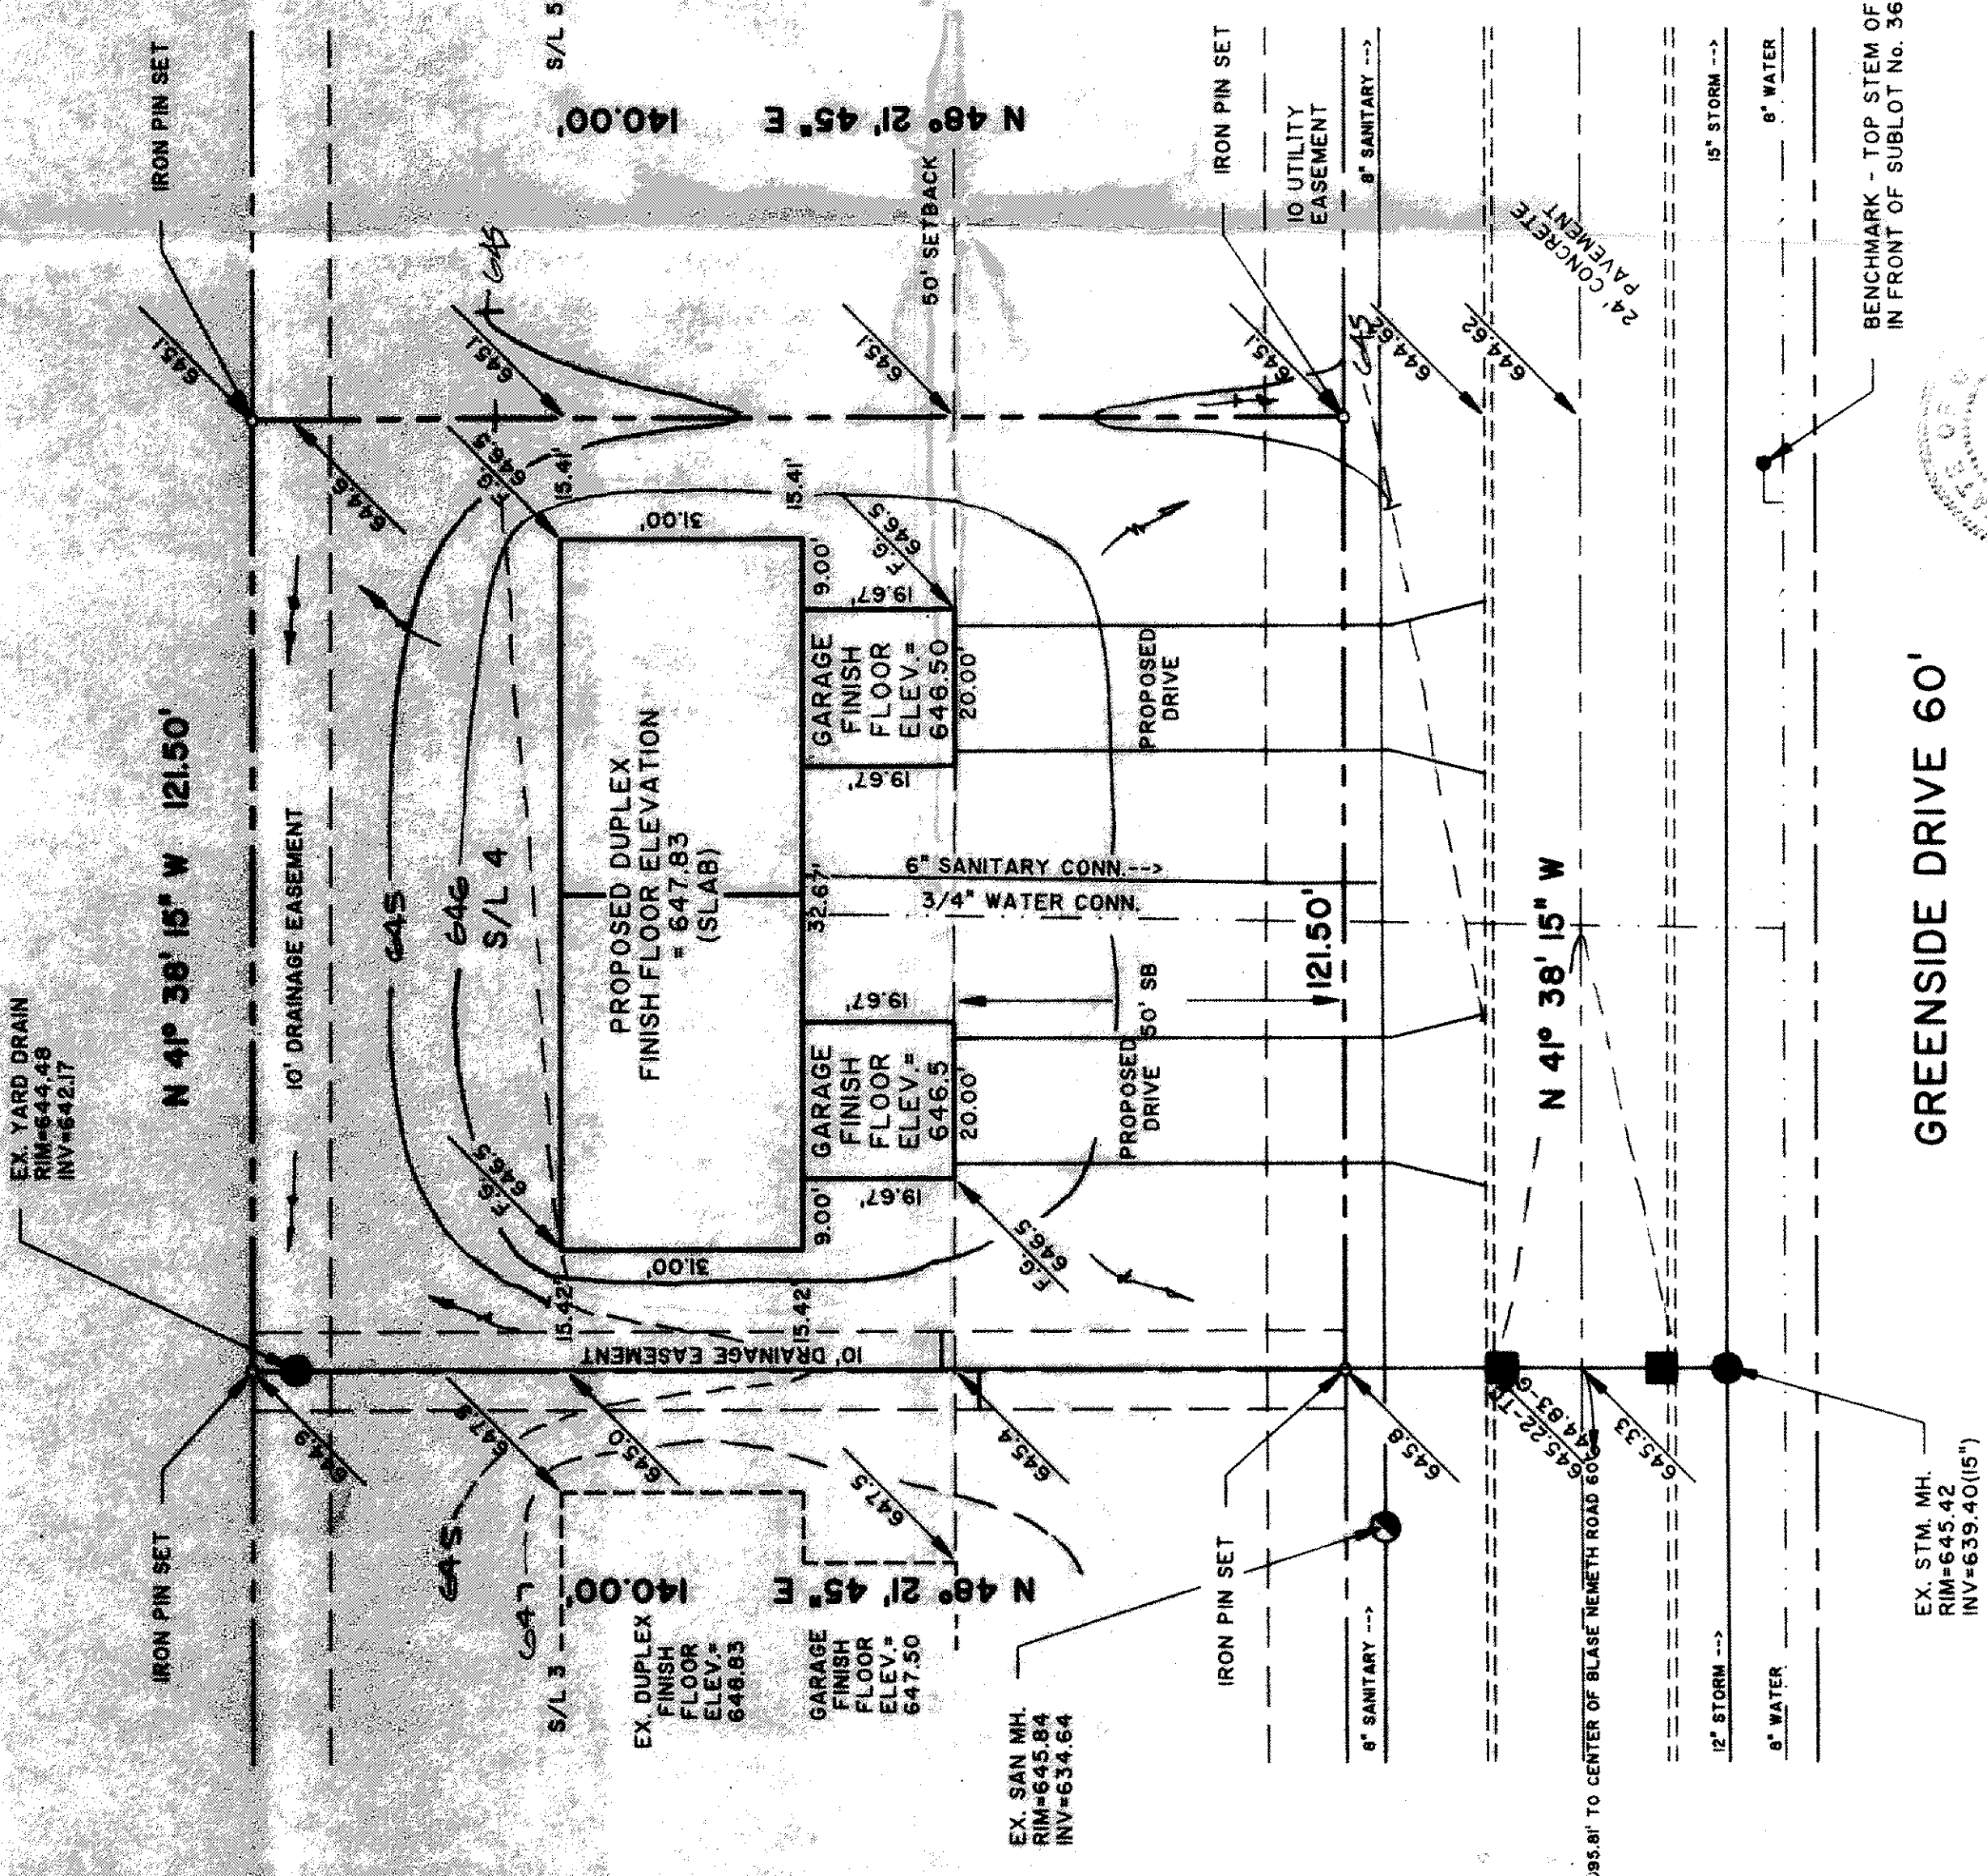

**GENERAL NOTES:**

- 1. DRIVEWAY APRON TO BE 6" THICK
- 2. BENCHMARK - TOP STEM OF FIRE HYDRANT LOCATED IN FRONT OF SUBLOT No. 36, ELEV. = 647.10

**LEGEND**

|  |                    |
|--|--------------------|
|  | EXISTING CONTOUR   |
|  | PROPOSED CONTOUR   |
|  | EXISTING ELEVATION |
|  | PROPOSED ELEVATION |

**CERTIFICATION**

"I, THE UNDERSIGNED HEREBY CERTIFY THAT THIS TOPOGRAPHY INDICATED BY 1" CONTOURS AND ELEVATIONS SHOWN HEREON REPRESENTS AN ACTUAL SURVEY MADE BY ME ON THE 30th DAY OF JAN. 1992 AND THE ELEVATIONS WERE TAKEN AT APPROPRIATE INTERVALS AND AS OF THAT DAY THEY EXISTED AS INDICATED HEREON.

"I HEREBY CERTIFY THAT THIS PLAN WAS PREPARED BY ME AND IS CORRECT TO THE BEST OF MY KNOWLEDGE"

*Quentin S. Himebaugh*  
QUENTIN S. HIMEBAUGH, P.S. No. 6820

**PREPARED BY:**

**Himebaugh and Associates**  
APPROVED TOWNSHIP Surveyors and Site Consultants  
PAINESVILLE TOWNSHIP 38083 West Spaulding St.  
ZONING DEPARTMENT  
#0400 *4/14/93*  
Willoughby, Ohio 44094  
(216) 946-1761

**SITE PLAN:** SUBLOT No. 4 GREENSIDE DRIVE, PAINESVILLE TWP.

PREPARED FOR: ASHBOURNE SUBDIVISION, VOL. 12, PG. 4

SCALE: 1" = 20'

DATE: MARCH 29, 1993

DRAWN BY: DAVID W. NOVAK

GREENSIDE DRIVE 60'

EX. STM. MH.  
RIM=645.42  
INV=639.40(15")

