
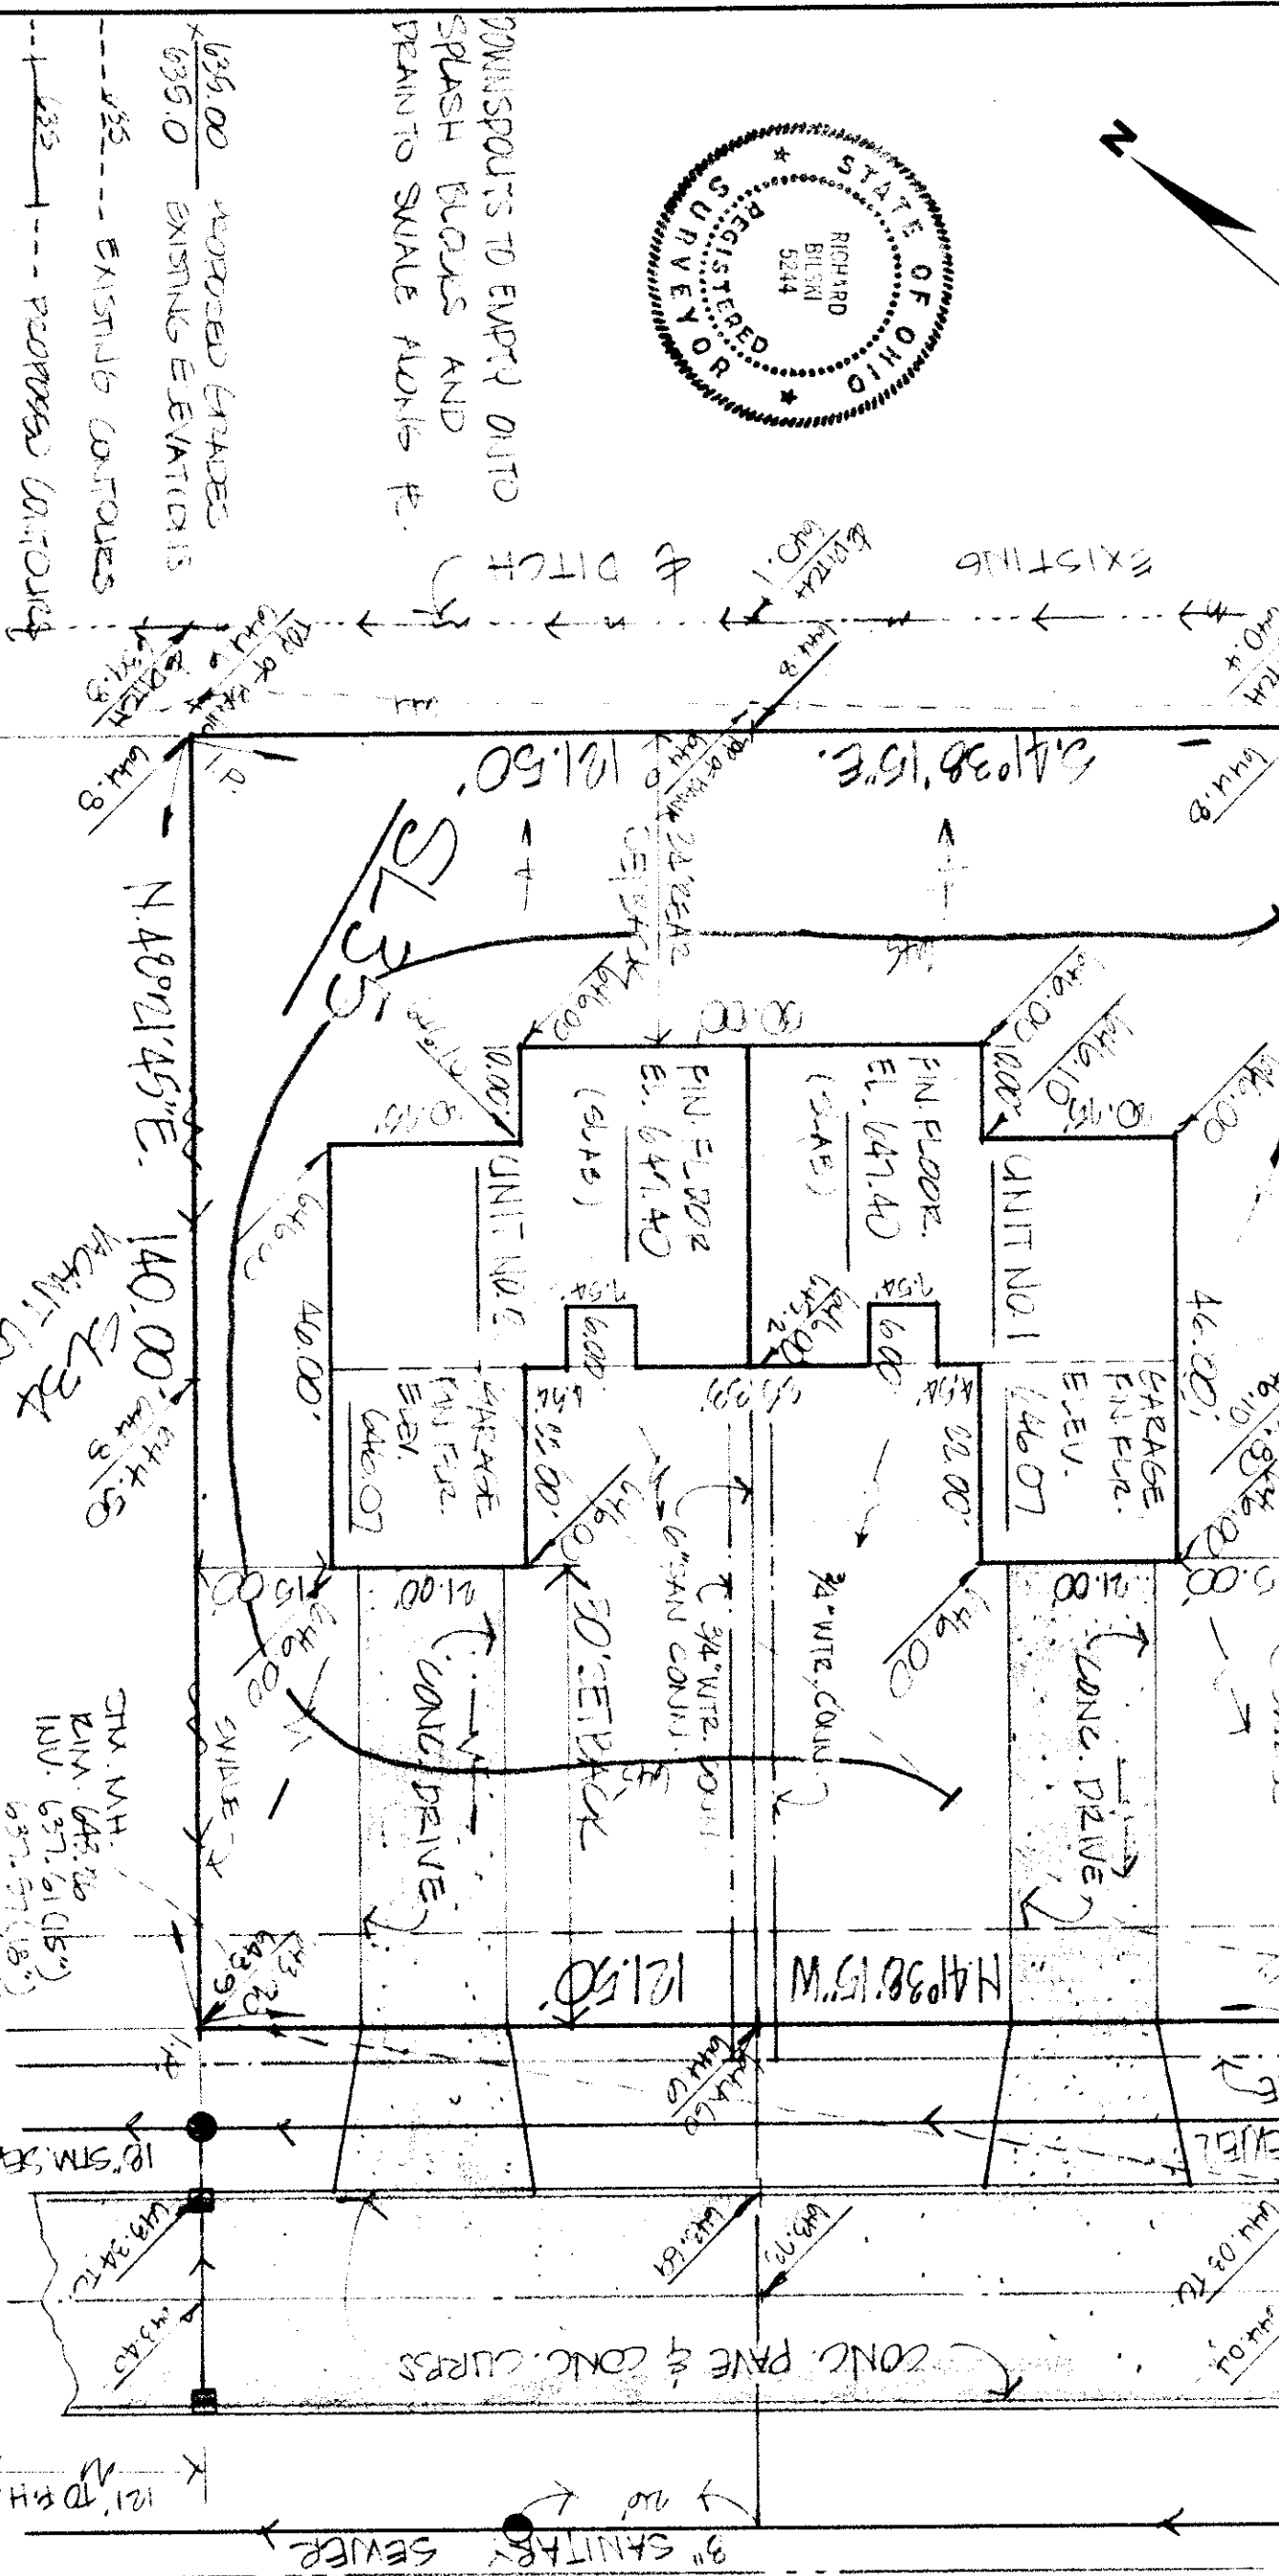


Grading Plan Approved
as shown and/or noted
THOMAS P. GILLES, P.E.
Lake County Engineer
Date 8/20/91
By GJH

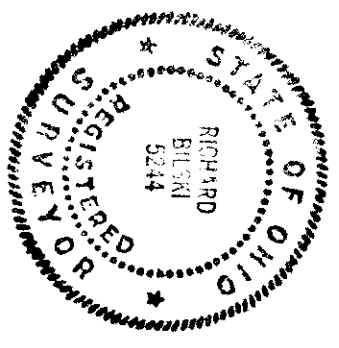

DESIGN CERTIFICATION

THIS PLAN WAS PREPARED BY ME
AND IS CORRECT TO THE BEST OF
MY KNOWLEDGE AND BELIEF

REG. SURVEYOR NO. 5244
Richard Bilski

AS BUILT CERTIFICATION

I HEREBY CERTIFY THAT THE CIRCLED GRADES
ARE EXISTING FINISH GRADES CHECKED IN THE
FIELD ON _____ AND THAT
SURVEY IS CORRECT TO THE BEST OF MY
KNOWLEDGE AND BELIEF

REG. SURVEYOR NO.



CT Consultants, Inc.
Engineers • Architects • Planners
Middletown • Mentor • Columbus • Lorain • North Canton • Steubenville

DATE: 8/16/91

SCALE: 1" = 20'

DRAWN BY: GJH

CHKD BY: GJH

JOB NO. 91-117
PG. 29

SITE PLAN FOR:

EDWARD H. TRESCER, INC.
3100 DEERWOOD BLVD. MENTOR, OHIO 44060
BEING SUBD. NO. 32 IN ASHBOURNE SUBDIVISION
IN PAINEVILLE TOWNSHIP, OHIO.

This Permit Expires 8/13/92
PAINEVILLE TOWNSHIP
ZONING APPROVED
#1901
Zoning Inspector *D. Duot*

GREENHILLSIDE DR.
SAN. M.H.
R.M. 643.77
INV. 633.44

REAR WALL:
TOP OF FINE H.P.
95.11691 to 37.536
3.64111

CL. BLADE - NEMETH RD.