



POUNTSPOOTS TO EMPTY
OUT SPASH BLOCKS
AND DRAIN TO SWALE
ALONG R.L.

--- 636.00 PROPOSED GRADES
--- 635.0 EXISTING ELEVATIONS
--- 635 EXISTING CONTOURS
--- 635 PROPOSED CONTOURS

DESIGN CERTIFICATION

THIS PLAN WAS PREPARED BY ME
AND IS CORRECT TO THE BEST OF
MY KNOWLEDGE AND BELIEF.

REG. SURVEYOR NO. 5244


AS BUILT CERTIFICATION

I HEREBY CERTIFY THAT THE CIRCLED GRADES
ARE EXISTING FINISH GRADES CHECKED IN THE
FIELD ON SURVEY IS CORRECT TO THE BEST OF MY
KNOWLEDGE AND BELIEF.

REG. SURVEYOR NO.



CT Consultants, Inc.
Engineers • Architects • Planners
Millsburgh • Mentor • Columbus • Lorain • North Canton • Starkville

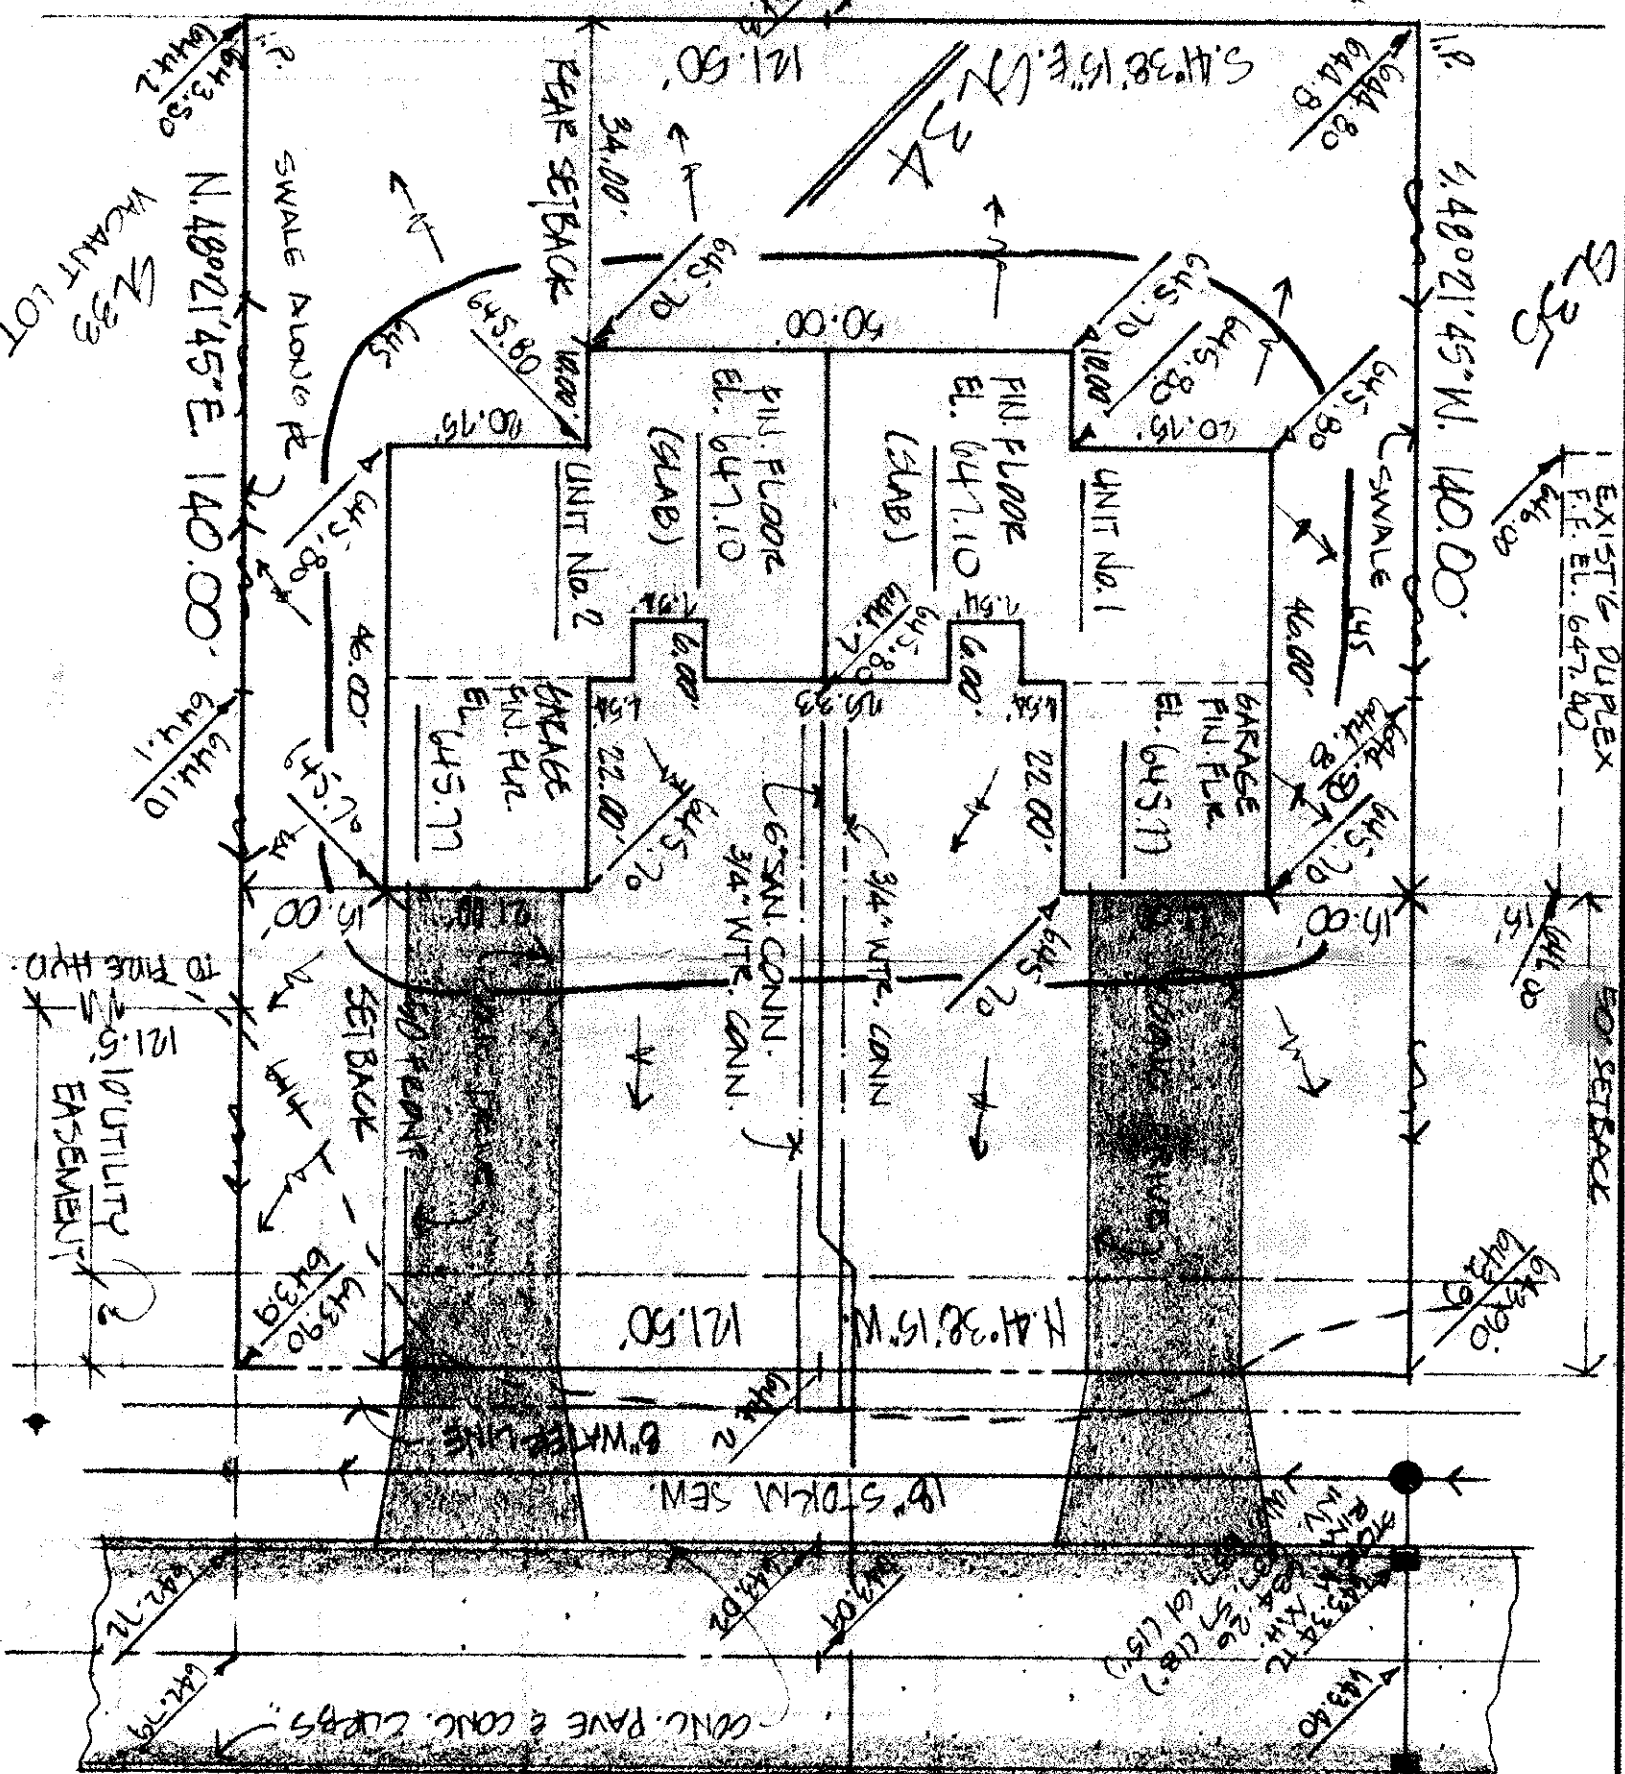

DATE Feb. 12, 1992
SCALE 1" = 20'
DRAWN BY C.O.B.
CHKD BY 91.117
JOB NO. 91.117
PG 31

SITE PLAN FOR:
EDWARD H. TRESEGER, INC.
8100 DEERWOOD BLVD. MENTOR, OH. 44060
BEING SUBLOT NO. 34 IN KSHBOURZAE
SUBDIVISION IN PAINESVILLE TOWNSHIP, OH.

By

Grading Plan Approved
as shown and/or noted
THOMAS P. GILLEO, P.E.
Lake County Engineer

Date 2/27/92

Zoning Inspector

This Permit Expires
2/24/93
PAINESVILLE TOWNSHIP
ZONING APPROVED
8033
D. P. Woot

GREENSIDE DR. 60'

90'
S.W. 1/4
R.M. 14
T.W. 633.77 (BENCH MARK)