



DESIGN CERTIFICATION
THIS PLAN WAS PREPARED BY ME
AND IS CORRECT TO THE BEST OF
MY KNOWLEDGE AND BELIEF

AS BUILT CERTIFICATION
I HEREBY CERTIFY THAT THE CIRCLED GRADES
ARE EXISTING FINISH GRADES CHECKED IN THE
FIELD ON
SURVEY IS CORRECT TO THE BEST OF MY
KNOWLEDGE AND BELIEF

CT Consultants, Inc.
Engineers • Architects • Planners
Wilmington • Mentor • Columbus • Lorain • North Canton • Steubenville

DATE: JUNE 16, 1992
SCALE: 1" = 20'
DRAWN BY: C.O.B.
JOB NO: 91-117
JOB NO: 91-117
PG 31

SITE PLAN FOR:
EDWARD H. TRESEKER, INC.
8100 DEERWOOD BLVD. MENTOR, OH 44060
BEING SUBLOT NO. 31 IN ASHBORNE
SUBDIVISION IN PAINESVILLE TOWNSHIP, OH.

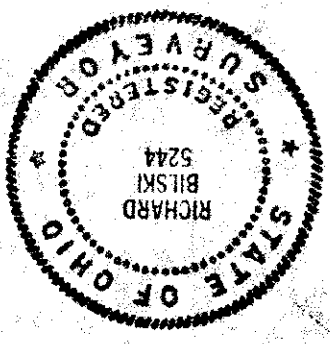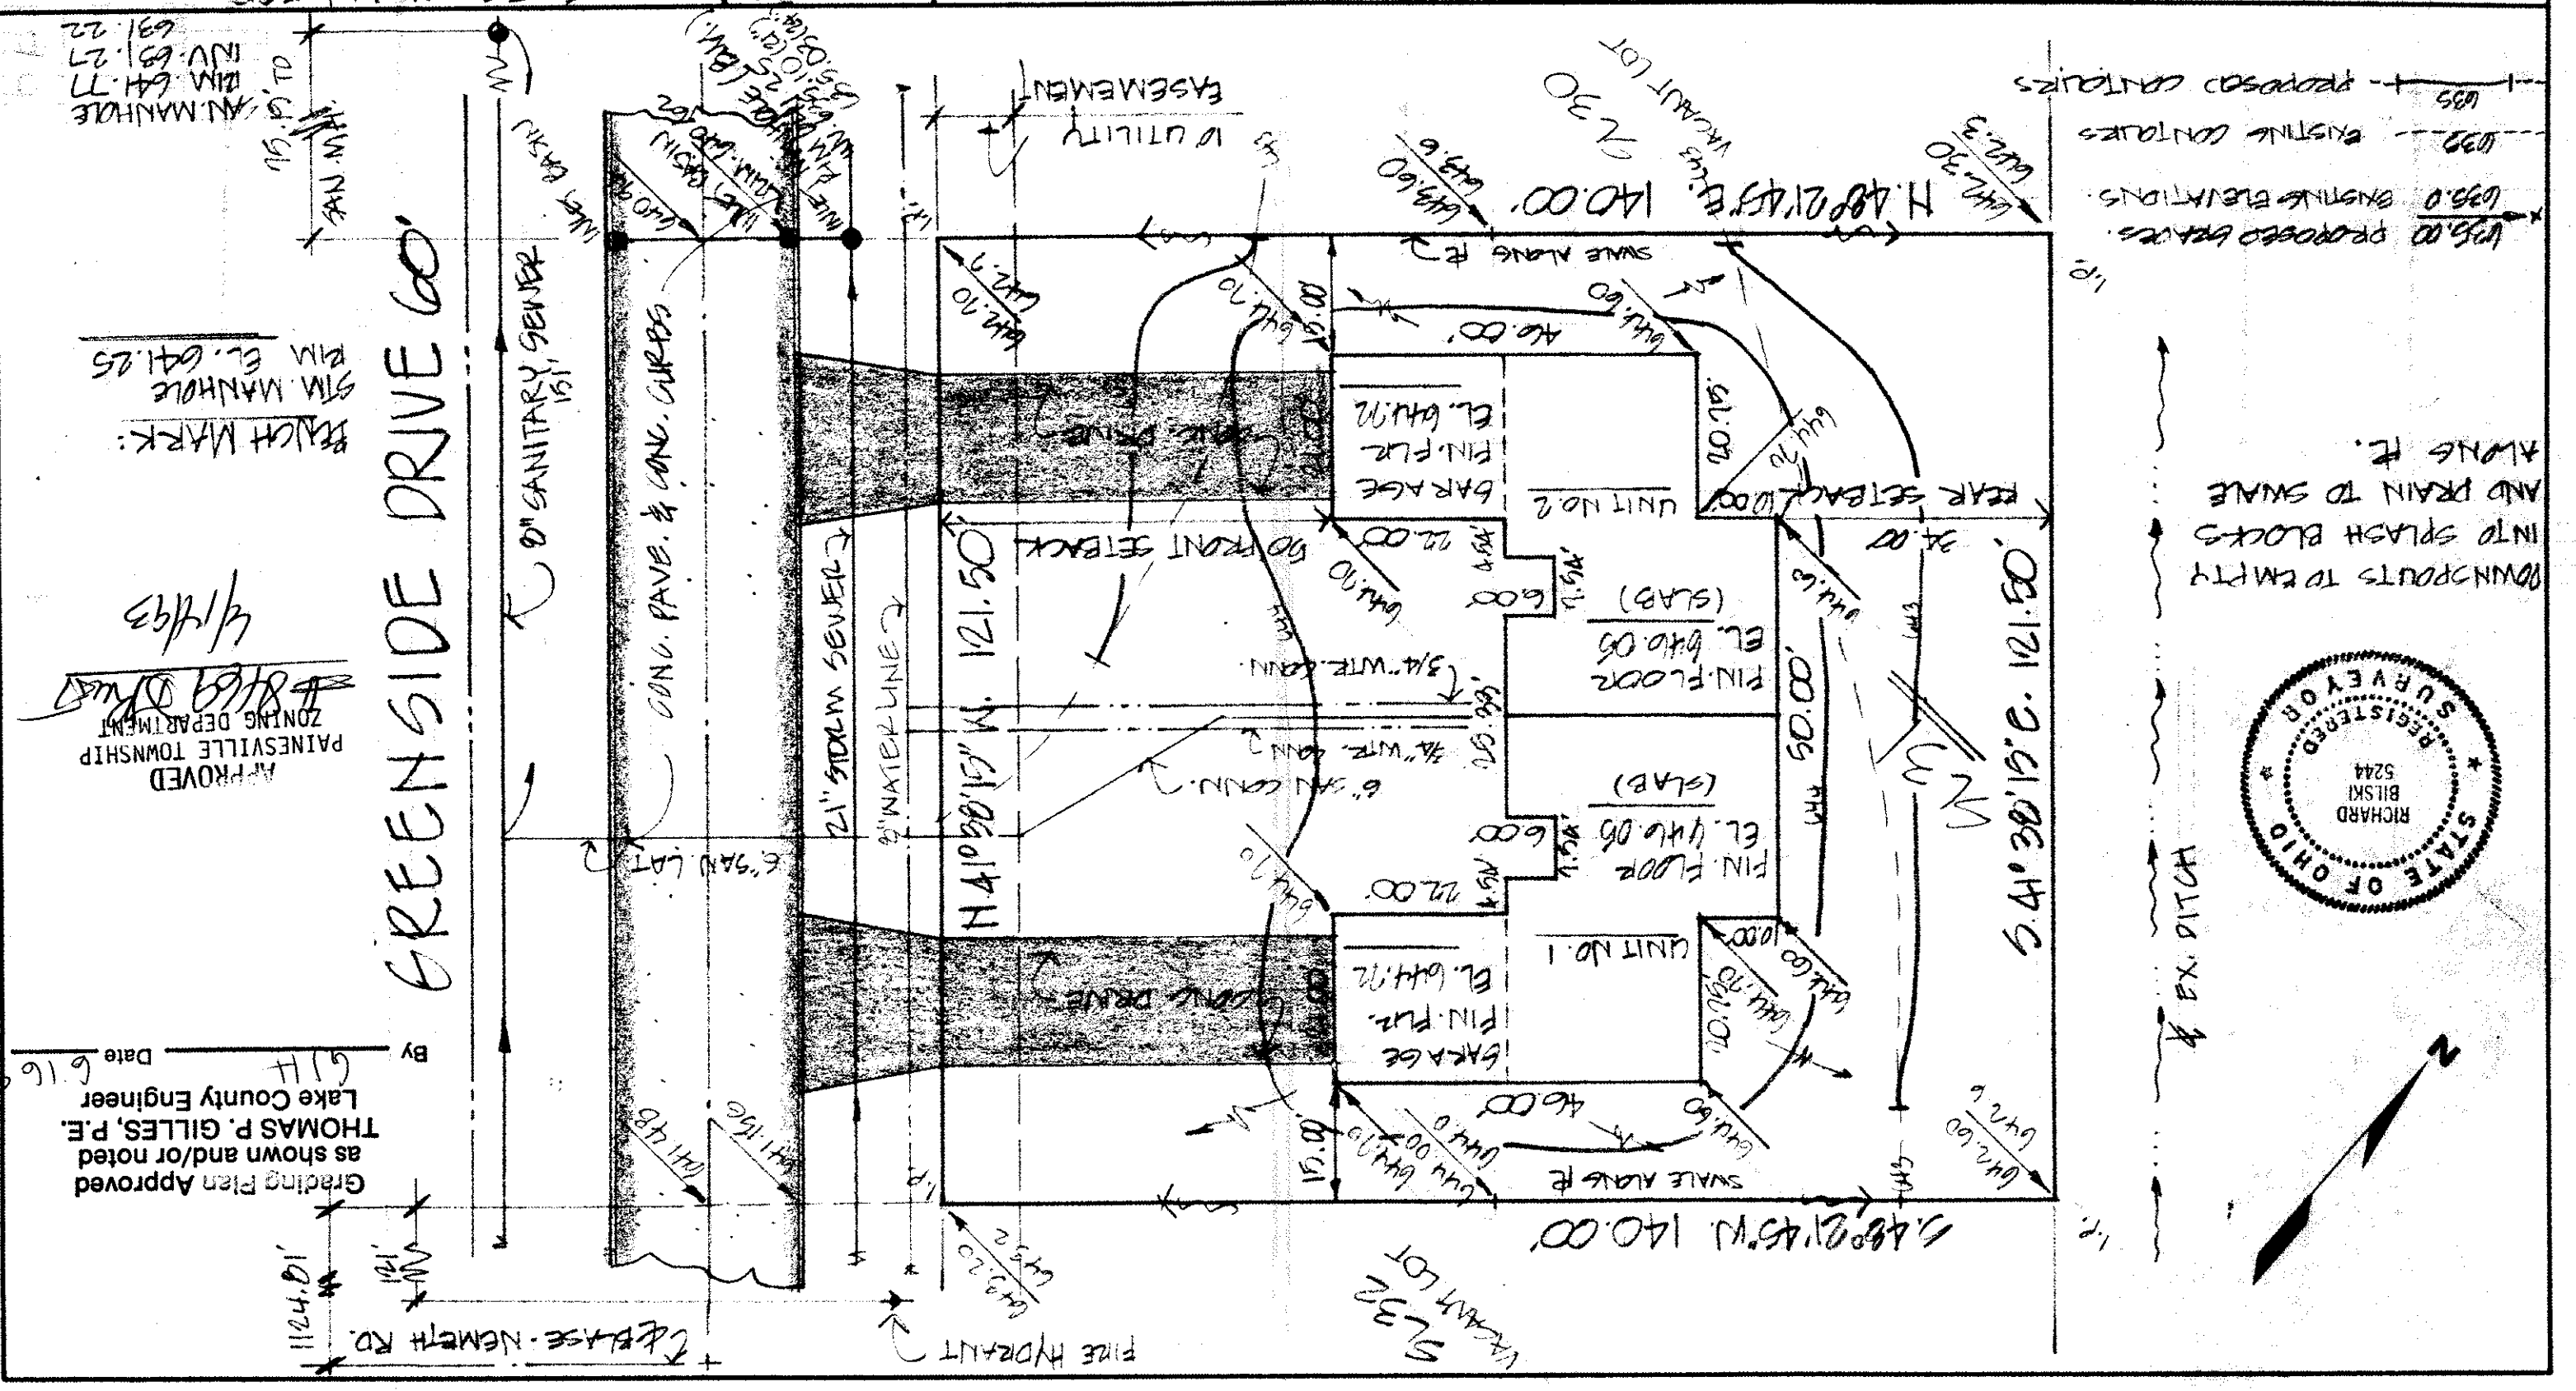

DOWNSPUTS TO EMPTY
INTO SPLASH BLOCKS
AND DRAIN TO SWALE
ALONG E.

EX. DITCH

GREENSIDE DRIVE 60'

ST. MARK:
DIM. 64.25
AN. MANHOLE
DIM. 64.77
INV. 63.27
63/22

APPROVED
PAINESVILLE TOWNSHIP
ZONING DEPARTMENT
4/1/93

Grading Plan Approved
as shown and/or noted
THOMAS P. GILLES, P.E.
Lake County Engineer
Date 6.16.93