

PRILL EX 1/4" C.
Vol. 63 Page 315

PRILL EX 1/4" C.
Vol. 63 Page 315

SUBLOT NO. 3
(VACANT LOT)

SUBLOT NO. 2

SUBLOT NO. 1

FIELD:
PROPOSED ELEVATIONS
EXISTING ELEVATIONS
EXISTING CONTOURS
PROPOSED CONTOURS

BEACH MARK:



TYPE OF FIRE HYDRANT BETWEEN
21' & 32' ELEV. 645.23

CERTIFICATION:

I HEREBY CERTIFY THAT THIS PLAN
WAS PREPARED BY ME AND IS
CORRECT TO THE BEST OF MY
KNOWLEDGE AND BELIEF.

By: Richard J. Bliski, P.E.

RICHARD J. BLISKI, P.E.
5244

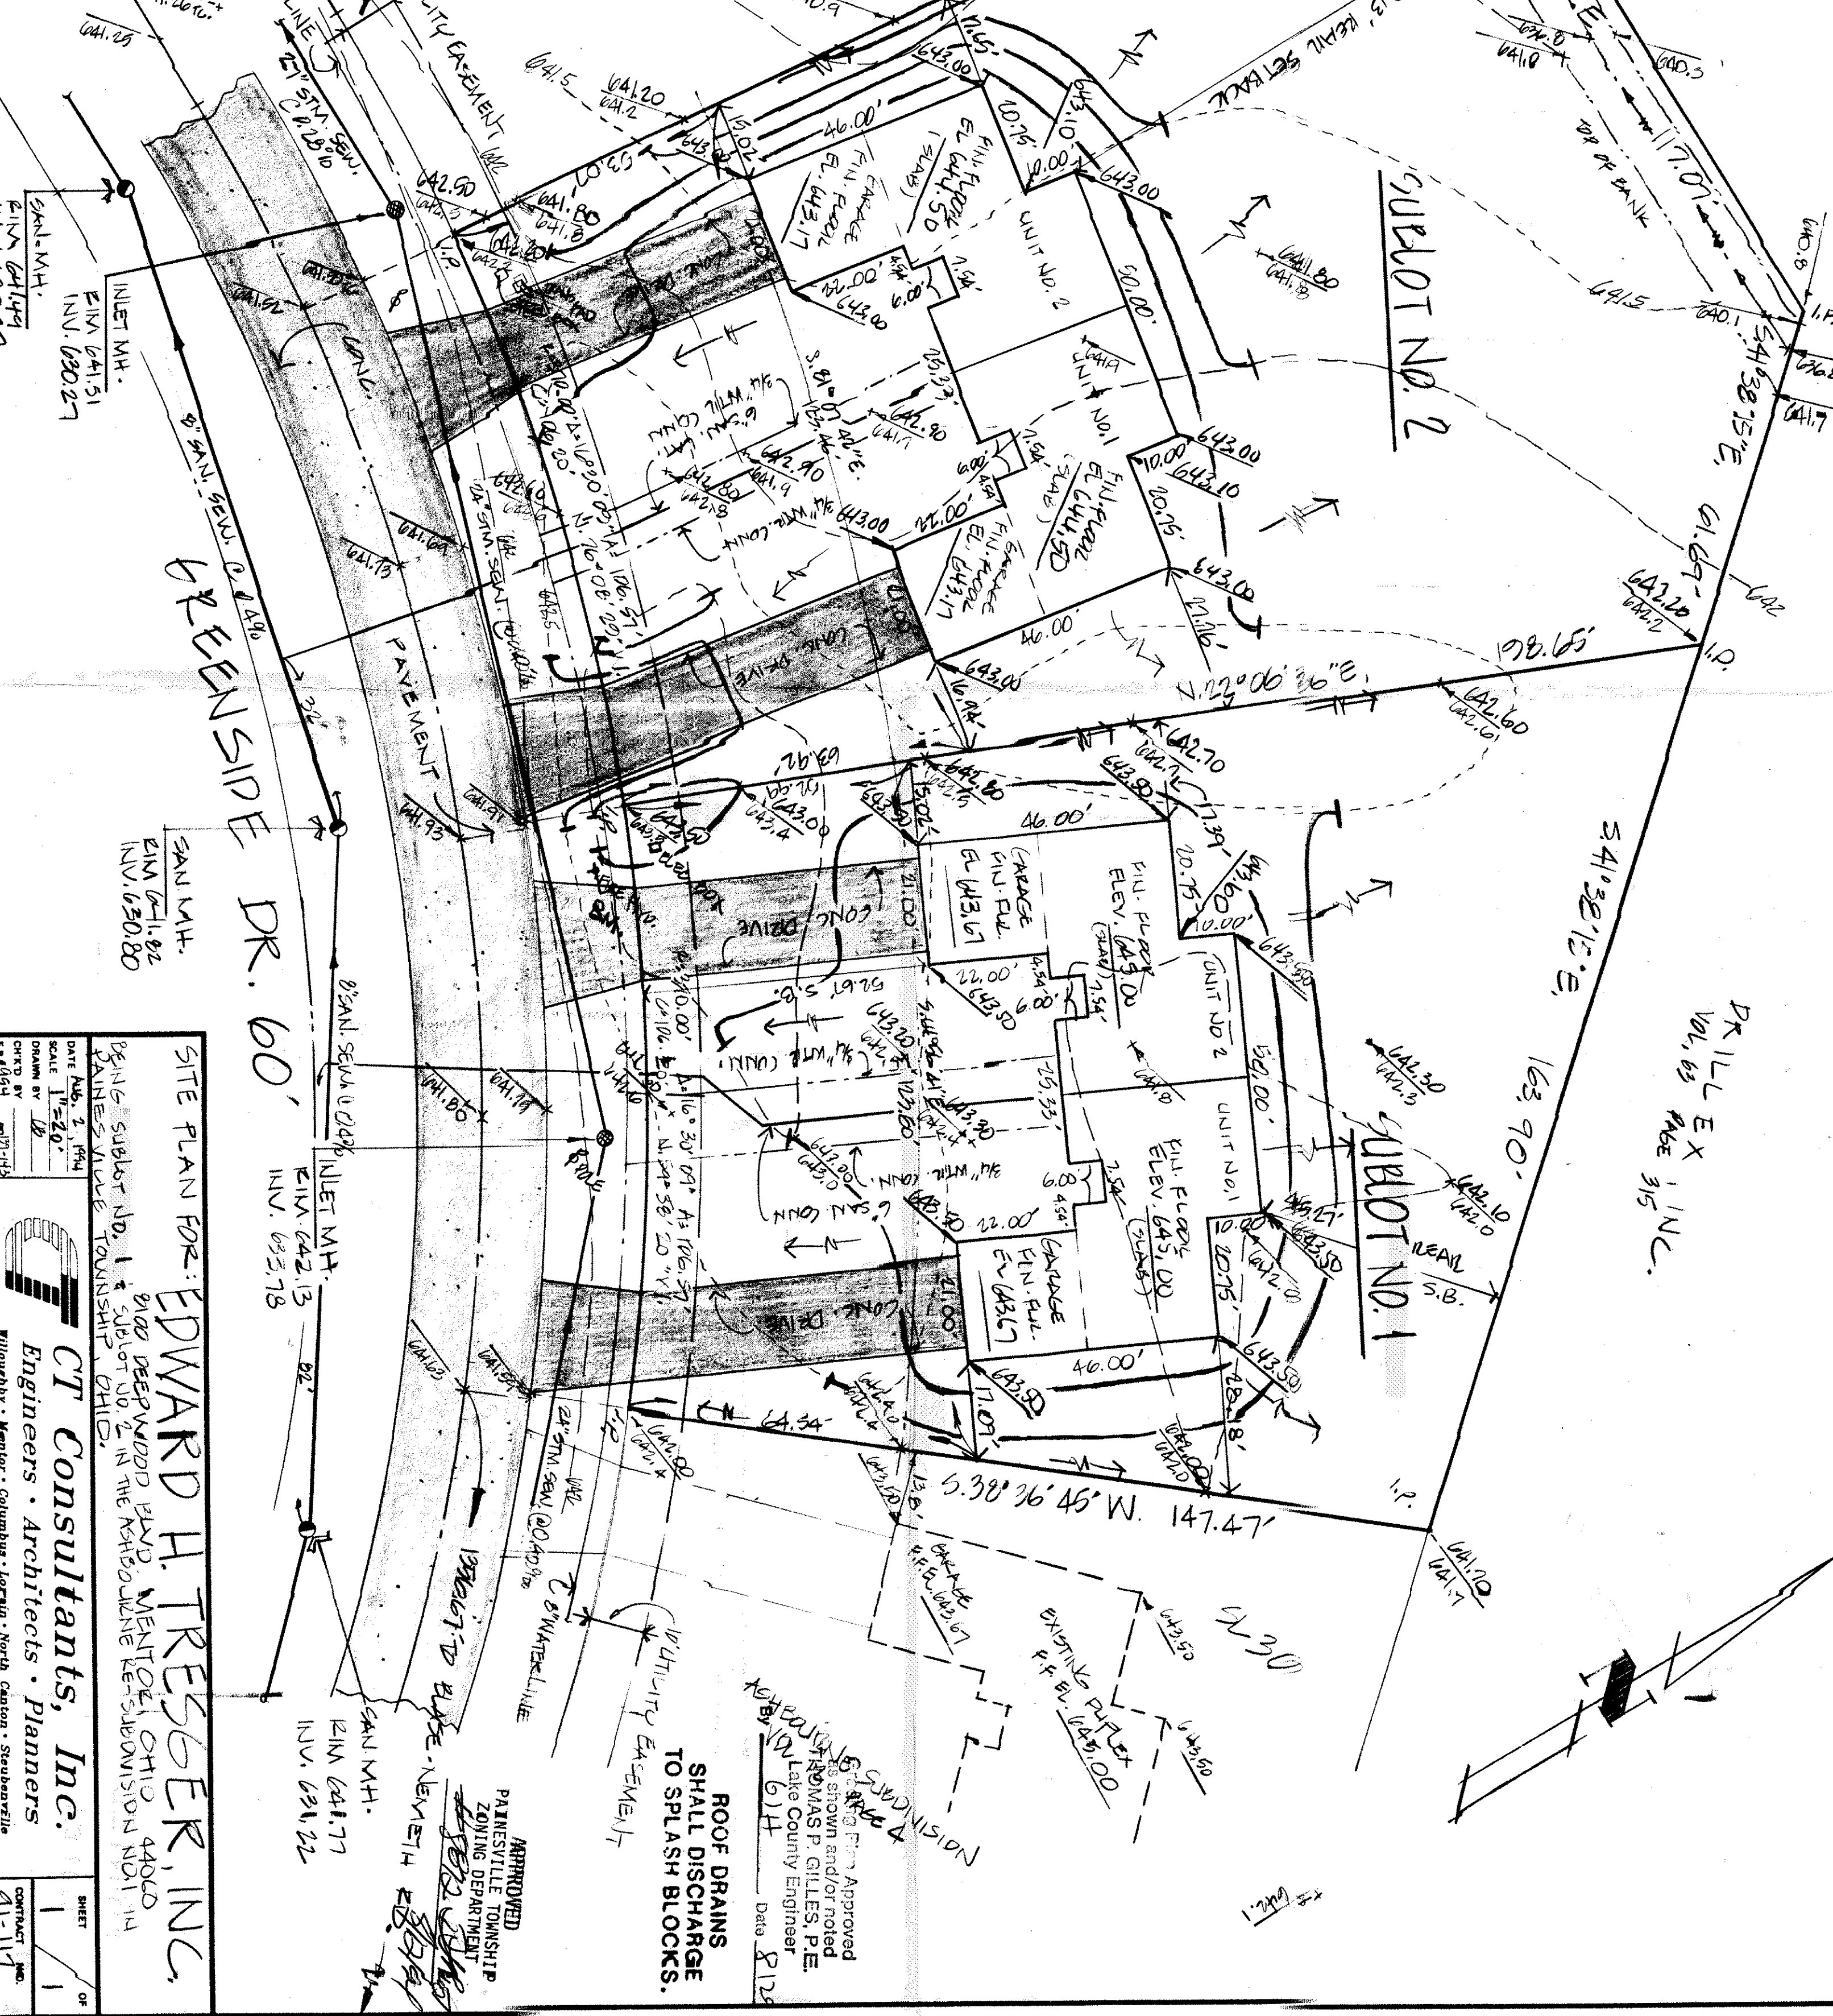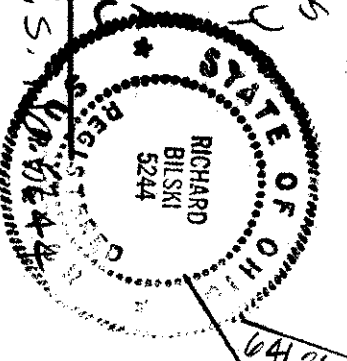

GREENSIDE DR. 60'

SITE PLAN FOR: **EDWARD H. TRESSEK, INC.**

8100 DEERWOOD BLVD. MENTOR, OHIO 44060
BEING SUBLOT NO. 1 & SUBLOT NO. 2 IN THE KATHOLIC RESSUBDIVISION NO. 1 IN
PAINESVILLE TOWNSHIP, OHIO.

DATE: Aug. 2, 1994
SCALE: 1"=20'
DRAWN BY: LB
CHECKED BY: RJB/145
F.B. 9/94

CT Consultants, Inc.
Engineers • Architects • Planners
Wilmington • Mentor • Columbus • Lorain • North Canton • Steubenville

SHEET 1 OF 1
CONTRACT NO. 91-117

ROOF DRAINS
SHALL DISCHARGE
TO SPLASH BLOCKS.

APPROVED
PAINESVILLE TOWNSHIP
ZONING DEPARTMENT
Date 8/12/94

SEAL
THOMAS P. GILLES, P.E.
Lake County Engineer