




CURVE DATA
R=1,690.75'
D=03°23'26"
A=100.05'
C=100.04'
N 89°33'52" W

Ordinary Plan Approved
THOMAS P. GILLES, P.E.
Lands County Engineer
6/14/96 3,294
Scale as shown

APPROVED
PAINESVILLE TOWNSHIP
ZONING DEPARTMENT
4/13/96
D. Novak

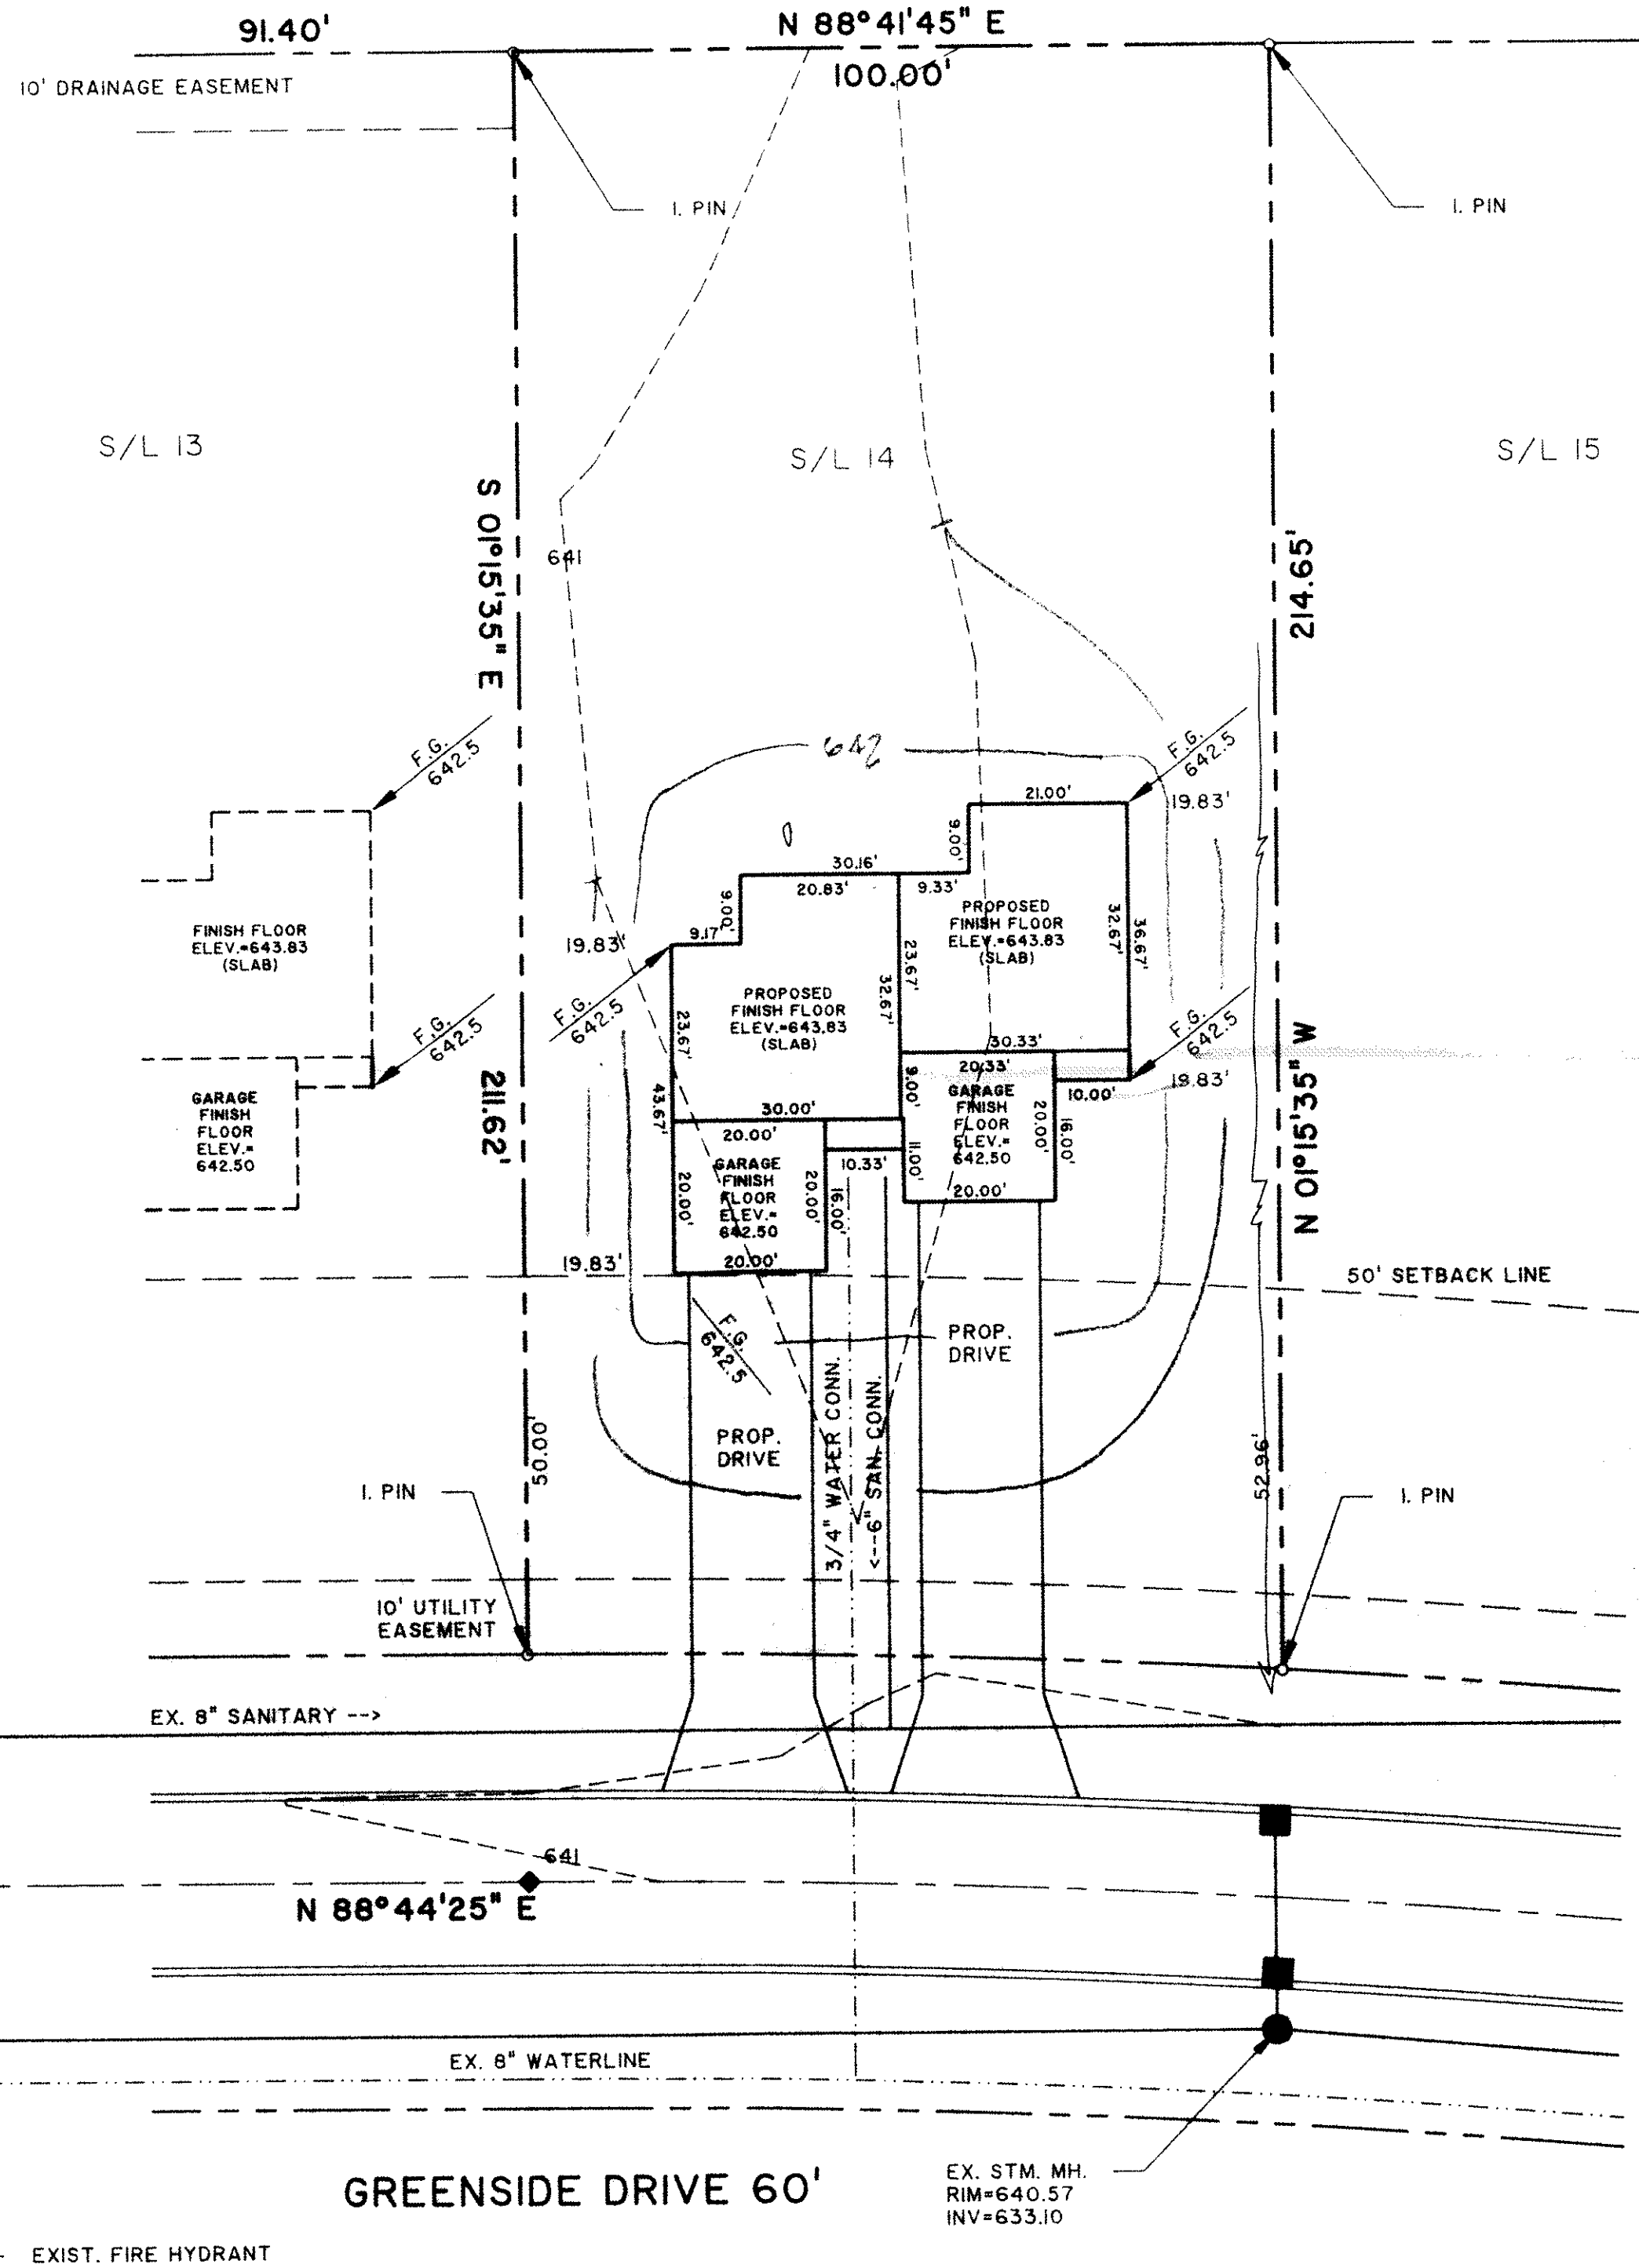


GENERAL NOTES:

1. DRIVEWAY APRON TO BE 6" THICK
2. BENCHMARK - TOP STEM OF FIRE HYDRANT LOCATED IN FRONT OF SUBLOT No. 29, ELEV=645.40

LEGEND

- EXISTING CONTOUR
- PROPOSED CONTOUR
- EXISTING ELEVATION
- PROPOSED ELEVATION

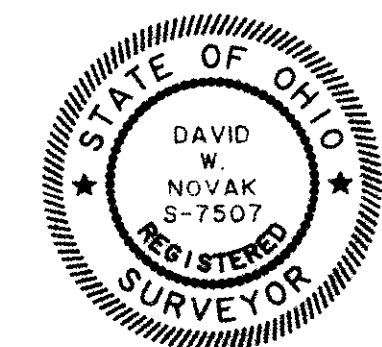

CERTIFICATION

"I THE UNDERSIGNED HEREBY CERTIFY THAT THIS TOPOGRAPHY INDICATED BY 'I' CONTOURS AND ELEVATIONS SHOWN HEREON REPRESENTS AN ACTUAL SURVEY MADE BY ME ON THE 23rd DAY OF MARCH, 1995 AND THE ELEVATIONS WERE TAKEN AT APPROPRIATE INTERVALS AND AS OF THAT DAY THEY EXISTED AS INDICATED HEREON.

"I HEREBY CERTIFY THAT THIS PLAN WAS PREPARED BY ME AND IS CORRECT TO THE BEST OF MY KNOWLEDGE"

David W. Novak
DAVID W. NOVAK, P.S. No. 7507

PREPARED BY:

Himebaugh and Novak
Surveyors and Site Consultants
8663 Tyler Boulevard
Mentor, Ohio 44060-4346
(216) 974-7670, (216) 255-5900 FAX.

SITE PLAN: SUBLOT No. 12, GREENSIDE DRIVE, PAINESVILLE TWP. ASHBOURNE SUBDIVISION, VOL. 12, PG. 4
PREPARED FOR: SCHOENIGER BROS. CONSTRUCTION INC.
SCALE: 1" = 20'
DATE: MARCH 12, 1996
DRAWN BY: DAVID W. NOVAK

94101-14