



APPROVED
PAINESVILLE TOWNSHIP
ZONING DEPARTMENT
1/6/94

Grading Plan Approved
and/or noted
THOMAS P. GILLES, P.E.
Lake County Engineer

6/11 Date 12/6/94

RECOMMEND THE DRIVEWAY
BE MOVED TO ELIMINATE
CONFLICT WITH STORM
MANHOLE AND MET BASIN

INLET MH.
RIM - 640.47
INV. 633.10 (27")
633.11 (24")
635.57 (12")

GREENSIDE DRIVE 60'

8" SANITARY SEWER @ 0.40%

PAVEMENT W/ CURBS

162.93' TO BASE

162.93' TO BASE

INLET MH.
RIM 641.51
INV. 633.78

INLET MH.
RIM 641.51
INV. 633.78


LEGEND:

640.00 PROPOSED GRADES
640.0 EXISTING ELEVATIONS
--- 642 --- EXISTING CONTOURS
--- 640 --- PROPOSED CONTOURS

CERTIFICATION:

I HEREBY CERTIFY THAT THIS PLAT
WAS PREPARED BY ME AND IS CORRECT
TO THE BEST OF MY KNOWLEDGE AND
BELIEF.

BY: Timothy P. Hadden, P.S. No. 6786

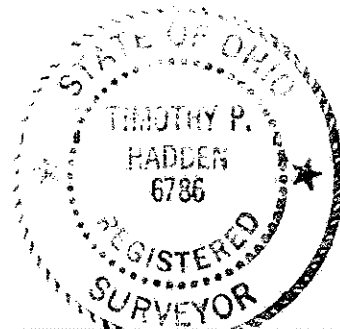

SITE PLAN FOR: EDWARD H. TRESSER, INC.
3100 DEEPWOOD BLVD. MENTOR, OHIO 44060
BEING SUEBLOT NO. 4 IN ASPHOURNE RE-SUBDIVISION IN PAINESVILLE TOWNSHIP, OHIO

DATE 12/31/94
SCALE 1" = 20'
DRAWN BY C.R.D.
CHK'D BY
F.B.F.



CT Consultants, Inc.
Engineers • Architects • Planners
Willoughby • Mentor • Columbus • Lorain • North Canton • Steubenville

SHEET
1
CONTRACT
91-1