


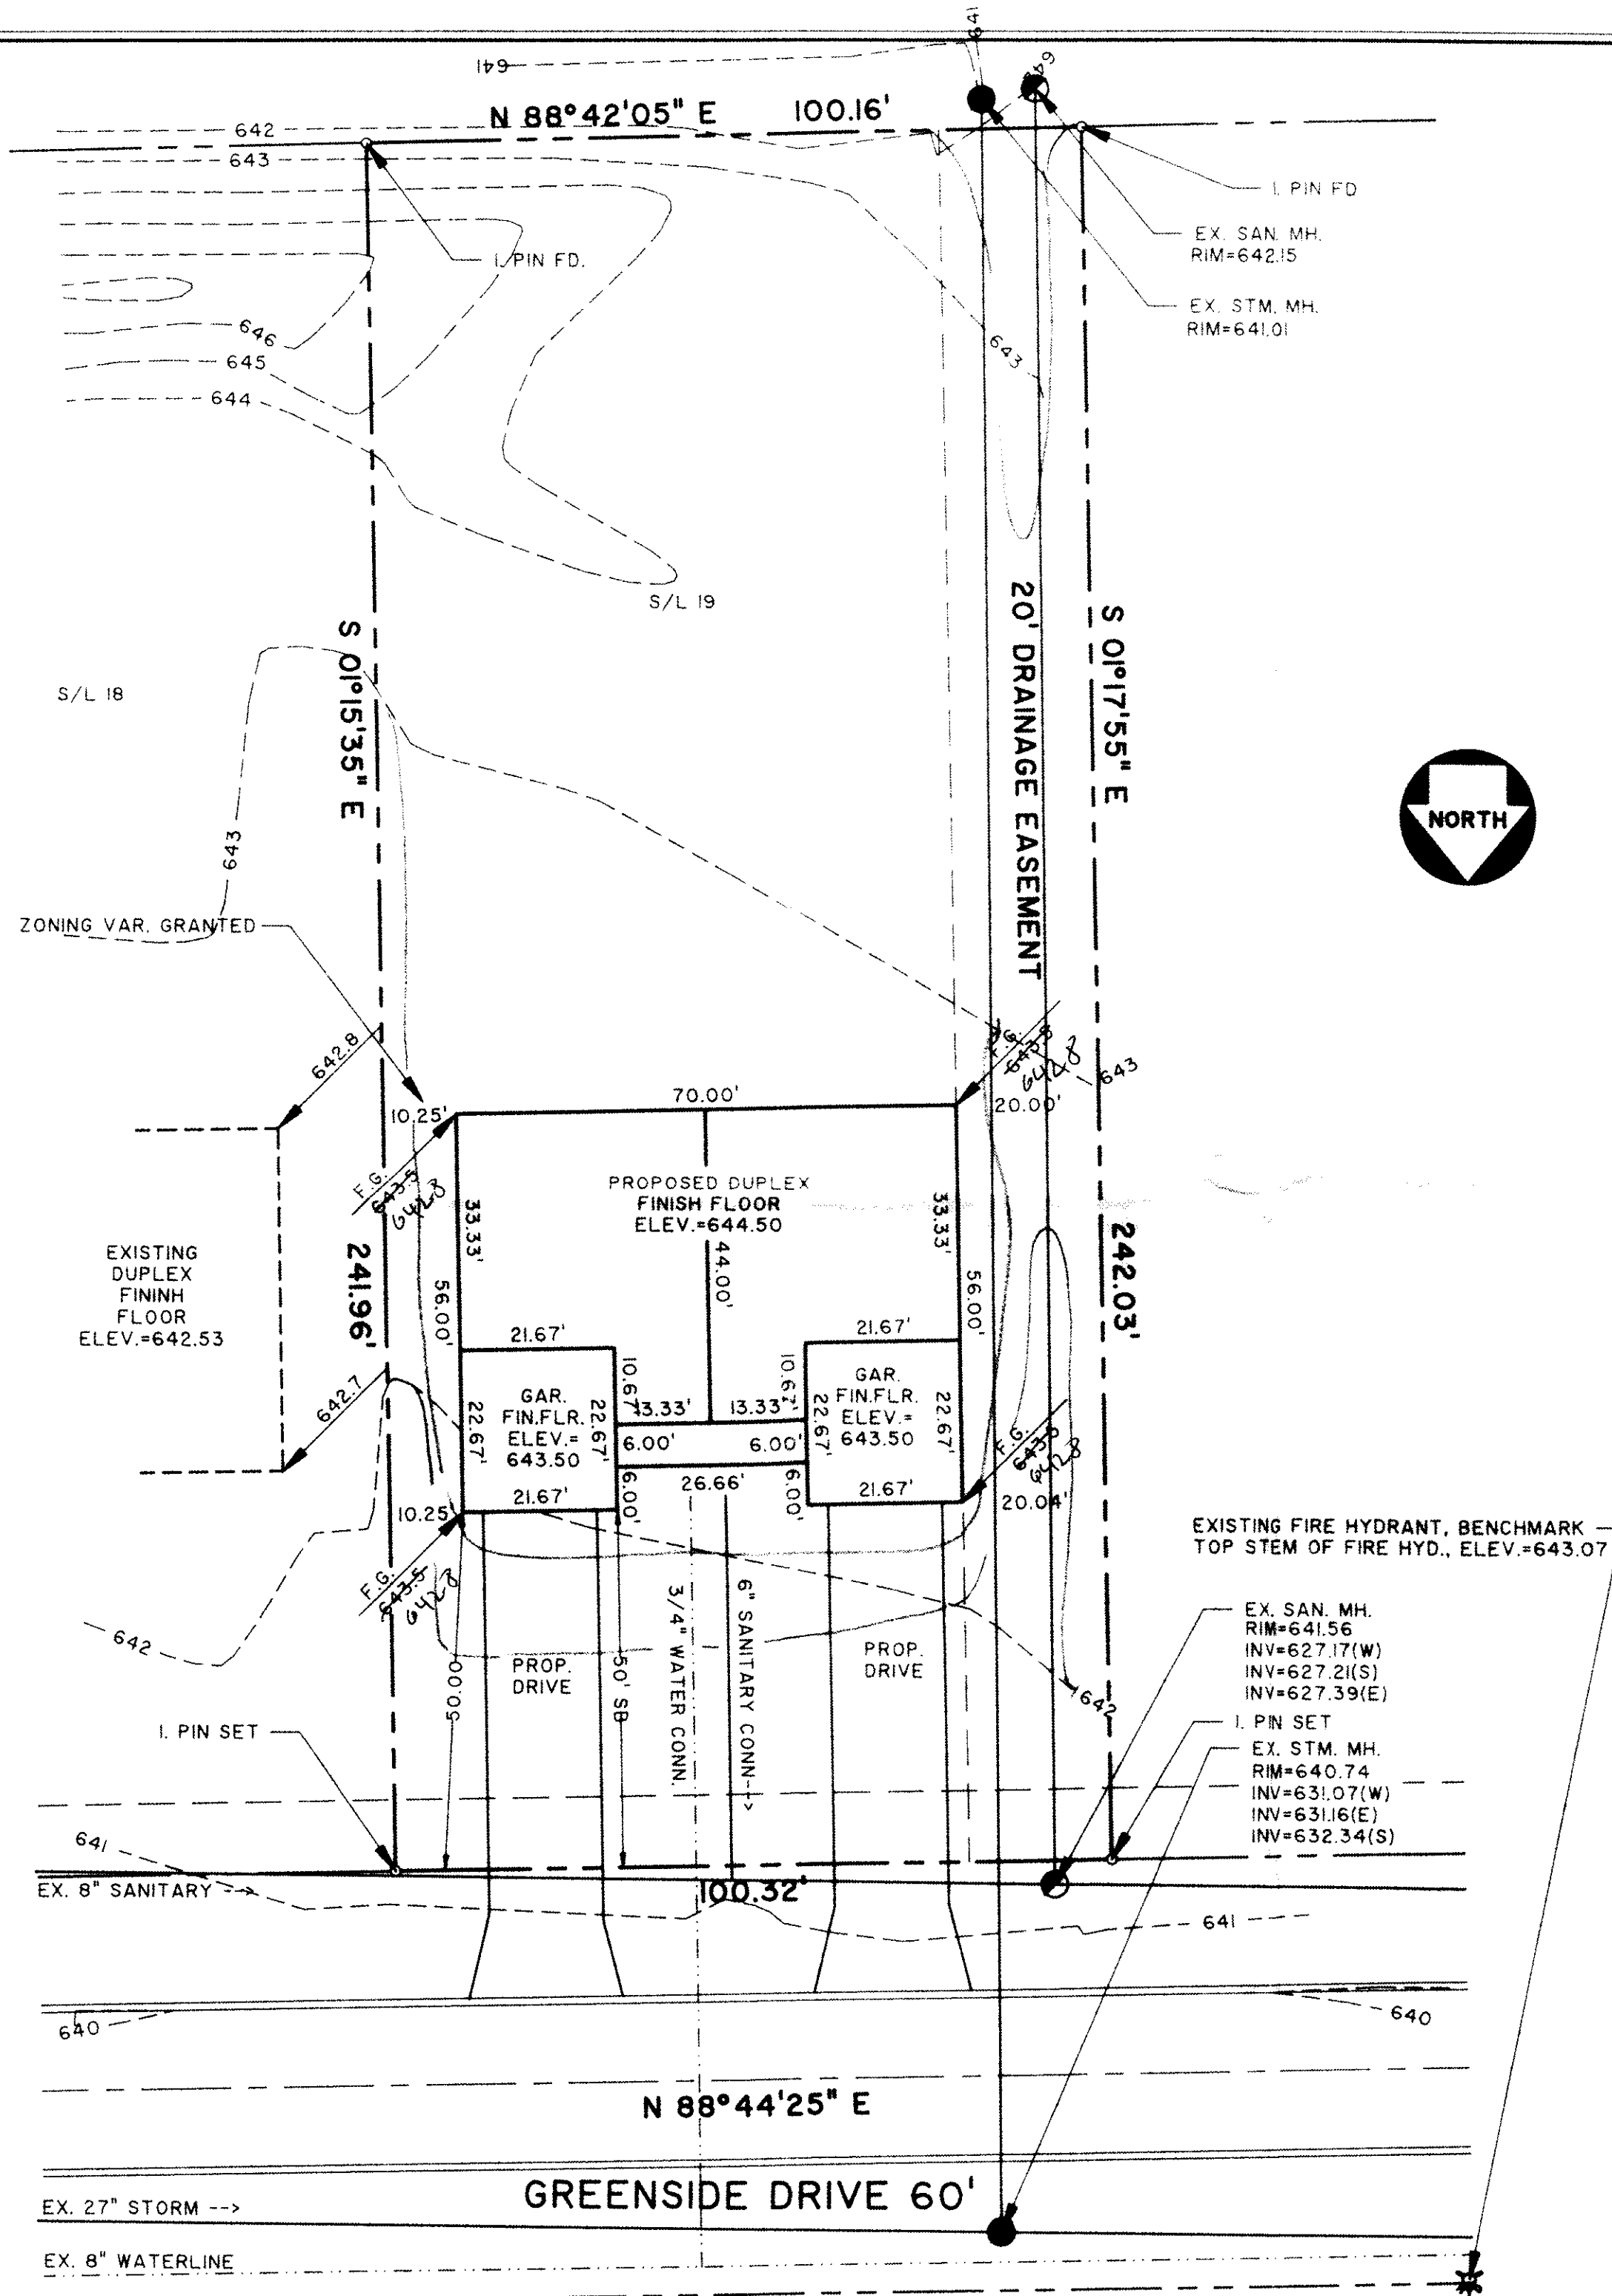


Greenside Drive, Painesville Twp.  
 Sublot No. 19, Ashbourne Subdivision, Vol. 12, Pg. 4  
 Twp. 12 N, R. 10 W, S. 10 E, County of Cuyahoga, Ohio  
 6344 Date 5-31-96  
 Lower finished grades to 642.8

### GENERAL NOTES:

1. DRIVEWAY APRON TO BE 6" THICK
2. BENCHMARK - TOP STEM OF FIRE HYDRANT LOCATED IN FRONT OF SUBLOT NO. 20, ELEV.=643.07

### LEGEND

- EXISTING CONTOUR
- PROPOSED CONTOUR
- EXISTING ELEVATION
- PROPOSED ELEVATION

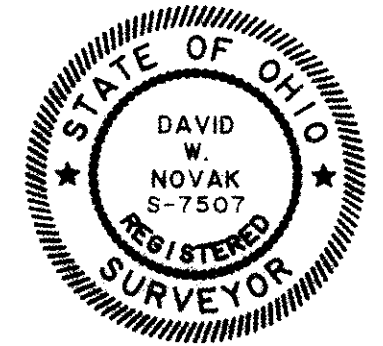

### CERTIFICATION

"I THE UNDERSIGNED HEREBY CERTIFY THAT THIS TOPOGRAPHY INDICATED BY 'I' CONTOURS AND ELEVATIONS SHOWN HEREON REPRESENTS AN ACTUAL SURVEY MADE BY ME ON THE 23rd DAY OF MAY, 1996 AND THE ELEVATIONS WERE TAKEN AT APPROPRIATE INTERVALS AND AS OF THAT DAY THEY EXISTED AS INDICATED HEREON.

"I HEREBY CERTIFY THAT THIS PLAN WAS PREPARED BY ME AND IS CORRECT TO THE BEST OF MY KNOWLEDGE"

*David W. Novak*  
 DAVID W. NOVAK, P.S. No. 7507

### PREPARED BY:

**Himebaugh and Novak**  
 Surveyors and Site Consultants  
 8663 Tyler Boulevard  
 Mentor, Ohio 44060-4346  
 (216) 974-7670, (216) 255-5900 FAX.

**SITE PLAN:** SUBLOT NO. 19, GREESIDE DRIVE, PAINESVILLE TWP.  
 ASHBOURNE SUBDIVISION, VOL. 12, PG. 4  
**PREPARED FOR:** SCHOENIGER BROS. CONSTRUCTION, INC.  
**SCALE:** 1" = 20'  
**DATE:** MAY 27, 1996  
**DRAWN BY:** DAVID W. NOVAK