

PAINESVILLE TOWNSHIP  
 ZONING APPROVED  
 # 3705 7-2-75  
 M. A. Henderson  
 Zoning Inspector

Grading Plan Approved  
 as shown and/or noted  
 THOMAS E. GILLES, P.E.  
 Lake County Engineer

By JWK Date 7-2-75

**SITE PLAN**  
 PAINESVILLE TOWNSHIP LAKE COUNTY, OHIO  
 for: B.S.M.  
 CLIENT OWNER  
 ADDRESS STREET CITY ZIP

Henlock Heights No. 3  
 SUBDIVISION 22 NAME  
 VOL. - PG. HAWK RIDGE DR  
 SUBLOT NO. STREET PERM. PARCEL NO. STREET

**LEGEND**  
 SANITARY MANHOLE --- (D) ---  
 STORM MANHOLE --- (S) ---  
 INLET OR CATCH BASIN --- (I) ---  
 HYDRANT --- (H) ---  
 EXISTING CONTOURS --- (dashed line) ---  
 PROPOSED CONTOURS --- (solid line) ---  
 EXIST. ELEV. --- 100.0 ---  
 100.0 PROP. ELEV. ---  
 WATER VALVE (GAS) --- (V) ---  
 WATER METER (GAS) --- (M) ---  
 AS BUILT ELEVATION --- (circle with number) ---  
 INDICATES DIRECTION OF SURFACE DRAINAGE --- (arrow) ---

**REMARKS**  
 ALL BOUNDARY DATA SHOWN WAS OBTAINED FROM (DEEDS, RECORDED SUBDIVISION PLAT OR OTHER PUBLIC RECORDS)  
 LOCATIONS AS SHOWN OF ADJACENT WELLS AND SEPTIC TANKS OBTAINED FROM LAKE COUNTY HEALTH DEPARTMENT  
Richard Salo

**DESIGN CERTIFICATION**  
 THIS PLAN WAS PREPARED BY ME, AND IS CORRECT TO THE BEST OF MY KNOWLEDGE AND BELIEF  
Richard Salo  
 NAME SURVEYOR REGISTRATION NO.

**CHECK LIST**


|                               |   |
|-------------------------------|---|
| NO. OF BEDROOMS               | WATER MAIN SIZE, LOCATION               |
| DIMENSIONS                    | SAN. SEWER SIZE % GR. LOC.              |
| BEARINGS                      | SAN. MH. CAST. ELEV. INV. ELEV.         |
| TIE TO NEAREST STREET         | SAN. CONN. SIZE, LOC. DEPTH             |
| SUBLOT NO. PARCEL NO.         | STORM SEWER SIZE % GR. LOC.             |
| SURROUNDING OWNERS            | STORM MH. CAST. ELEV. INV. ELEV.        |
| BLDG. DIMENSIONS FIN. GR.     | PAVT TYPE GRADE CURBS                   |
| BLDG. TIES FL'R. GRADES       | GAS LINE LOC. SIZE PRESSURE             |
| APRON TYPE WIDTH THICKNESS    | SEPTIC TANK LOCATION & DUPLICATION AREA |
| SIDEWALK TYPE WIDTH THICKNESS | WELL LOCATION                           |
| CULVERT TYPE DIA., LENGTH     | ISOLATION RADIUS FROM WELL              |
| ROCK OUTCROPPINGS             |   |

**PLAN PREPARED BY:**  
**DEBEVEC-SALO & ASSOCIATES, INC.**  
 130 EAST JACKSON ST. PAINESVILLE, OHIO

|     |        |     |            |              |                     |
|-----|--------|-----|------------|--------------|---------------------|
| NO. | DATE   | BY  | DRAWN BY   | SCALE        | PHONE NO.           |
| 1   | July 2 | TJB | TJB        | 1"=20'       | 552-9250            |
| 2   |        |     |            |              |                     |
| 3   |        |     |            |              |                     |
| 4   |        |     | CHK'D. TJB | DATE 6-26-75 | DRAWING NO. 4438-19 |
| 5   |        |     | CREW CHIEF | APP'D. Ke    |                     |

**"AS BUILT" CERTIFICATION**  
 I, HEREBY CERTIFY THAT THE CIRCLED GRADES ARE EXISTING FINISH GRADES CHECKED IN FIELD ON 19 BY SURVEYING AND ARE CORRECT TO THE BEST OF MY KNOWLEDGE AND BELIEF.

REGISTERED SURVEYOR REG. NO.

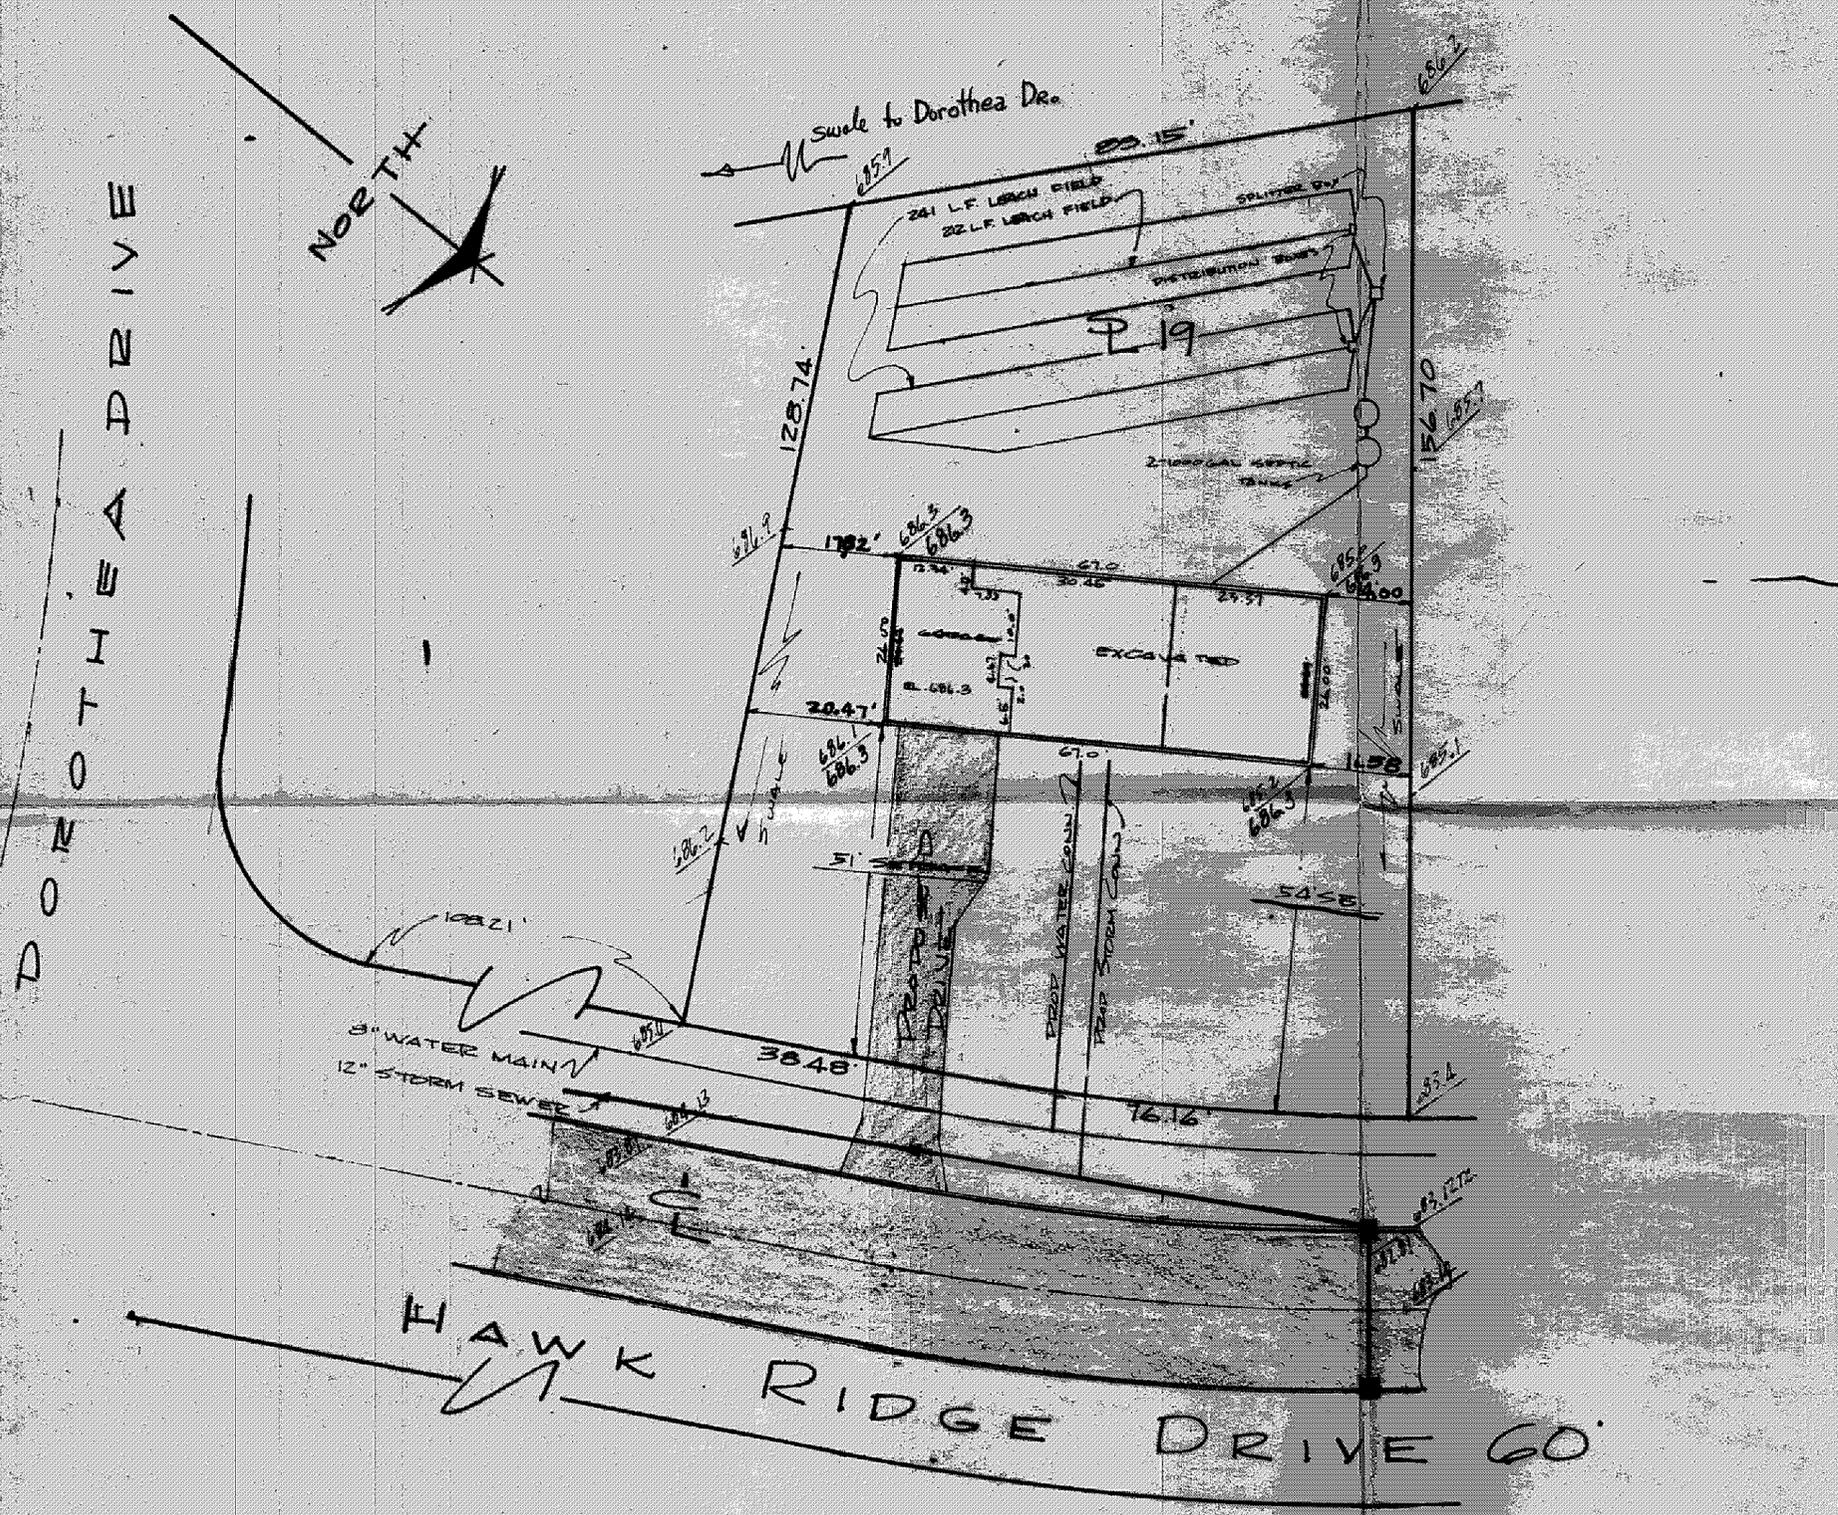

TOP OF BLOCK  
 El. 686.97

*[Handwritten signature]*

Bevig I