


Readings are based on an assumed meridian and is used for double angles only.

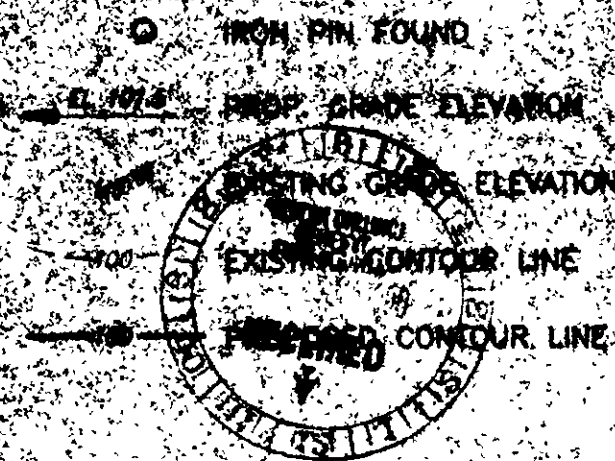


## Site Plan FOR Roger and Mindy Sicker

Situated in the Township of Painesville,  
County of Lake, and State of Ohio and known as  
being a part of Lot 3, Tract 1 in said Township.


"I, THE UNDERSIGNED HEREBY CERTIFY THAT THE  
TOPOGRAPHY SHOWN HEREON, INDICATED BY ONE FOOT  
CONTOURS AND ELEVATIONS REPRESENTS AN ACTUAL FIELD  
TOPOGRAPHIC SURVEY MADE BY ME IN JUNE, 1999.  
AND THAT THE ELEVATIONS WERE TAKEN AT APPROPRIATE INTERVALS  
AND THAT AS OF THAT DATE THEY EXISTED AS INDICATED HEREON."

DISTANCES ARE GIVEN IN FEET AND DECIMAL PARTS THEREOF  
UNLESS OTHERWISE NOTED AND WERE TAKEN FROM THE PLAT  
AND DEEDS HEREIN NOTED. SURVEYED JUNE, 1999.  
THIS PLAN WAS PREPARED UNDER MY SUPERVISION AND IS  
CORRECT TO THE BEST OF MY KNOWLEDGE AND BELIEF

David A. Rapp 7-15-99  
P.S. No. 759

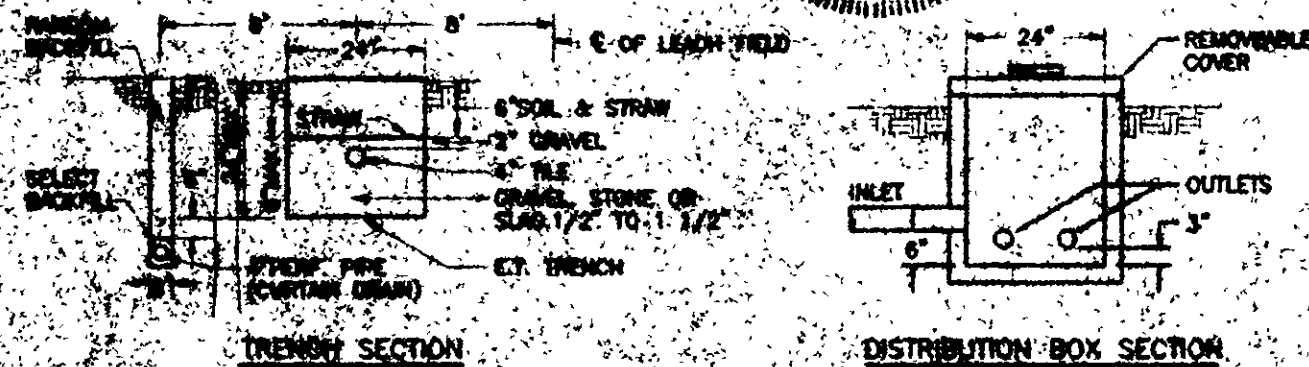

Leach  
EVAPO-TRANSPIRATION TILE FIELD

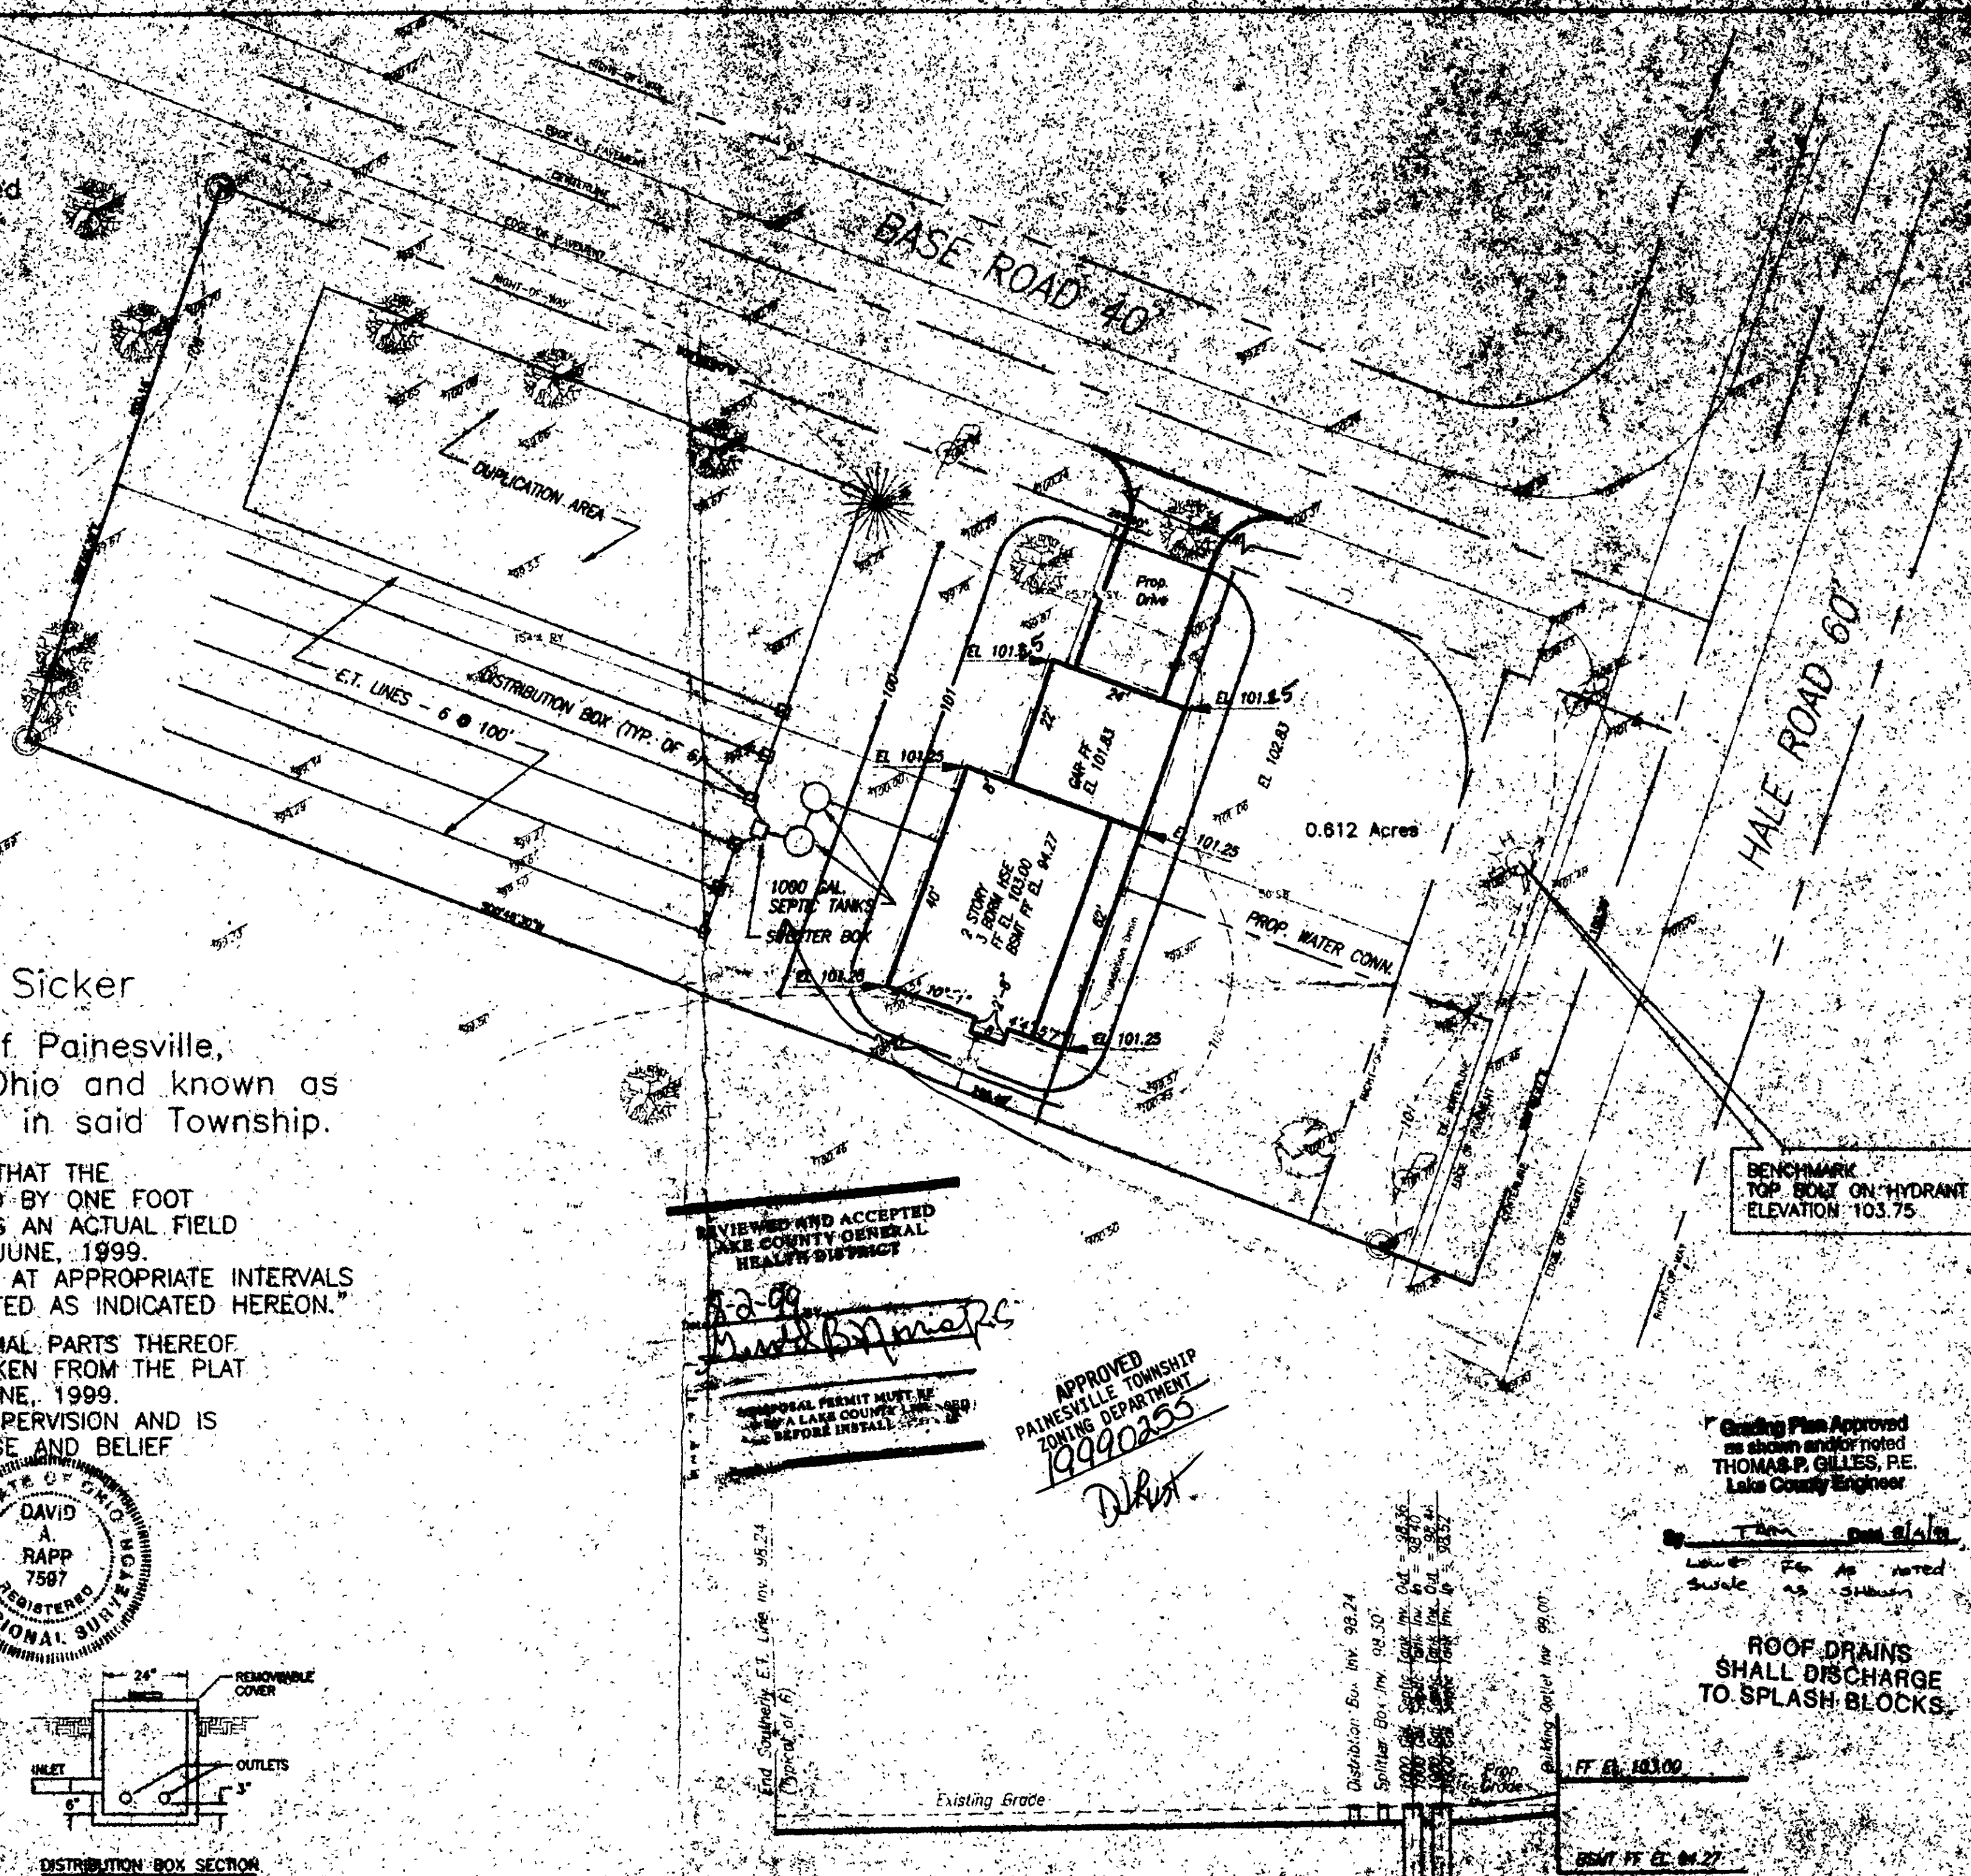

Hydraulic Profile

Scale: Horiz. 1"=20'  
Vert. 1"=2'