

SITE PLAN

PAINESVILLE TOWNSHIP, LAKE COUNTY, OHIO

for: PAKEL SHEETON

CLIENT OWNER
21 BOWHALL RD. P.VILLE CITY ZIP

PAINESVILLE - ON THE LAKE
SUBDIVISION D-13 NAME
13-15 VOL. - P. HARDY RD
SUBLOT NO. STREET

LEGEND

SANITARY MANHOLE WATER VALVE (GAS)
STORM MANHOLE WATER METER (GAS)
INLET OR CATCH BASIN AS BUILT ELEVATION
HYDRANT
EXISTING CONTOURS
PROPOSED CONTOURS
EXIST. ELEV. 100.0 PROP. ELEV. 100.0
INDICATES DIRECTION OF SURFACE DRAINAGE

REMARKS

ALL BOUNDARY DATA SHOWN WAS OBTAINED FROM (DEEDS, RECORDED
SUBDIVISION PLAT OR OTHER PUBLIC RECORDS)
LOCATIONS AS SHOWN OF ADJACENT WELLS AND SEPTIC TANKS OBTAINED FROM
LAKE COUNTY HEALTH DEPARTMENT

DESIGN CERTIFICATION

THIS PLAT WAS PREPARED BY ME, AND IS CORRECT
TO THE BEST OF MY KNOWLEDGE AND BELIEF. 2/24/3

CHECK LIST

NO. OF BEDROOMS
DIMENSIONS
TIE TO NEAREST STREET
SUBLOT NO. PARCEL NO.
SURROUNDING OWNERS
BLDG. DIMENSIONS FTH. GR.
BLDG. TIES FTH. GR.
ADJACENT TYPE AND THICKNESS
CULVERT TYPE DIA. LENGTH
ROCK OUTCROPPINGS

WATER MAIN SIZE, LOCATION
SAN. SEWER SIZE % GR. LOC.
SAN. MH. CAST. ELEV. INV. ELEV.
SAN. CONN. SIZE, LOC. DEPTH
STORM SEWER SIZE % GR. LOC.
STORM MH. CAST. ELEV. INV. ELEV.
PAV'T TYPE GRADE CURVES
GASLINE LOC. SIZE PRESSURE
SEPTIC TANK LOCATION & DUPLICATION AREA
WELL LOCATION
ISOLATION RADIUS FROM WELL

NO.	DATE	BY
1	2-5-30	R
2		
3		
4		
5		

PLAN PREPARED BY:
BABCOCK • JONES & ASSOCIATES, INC.
PAINESVILLE, OHIO

DRAWN BY	SCALE	PHONE NO.
CHK'D. III	1" = 20'	357-1811
DATE	8-29-30	DRAWING NO.
CREW CHIEF	APPD. HI	90-208

"AS BUILT" CERTIFICATION

I, HEREBY CERTIFY THAT THE CIRCLED GRADES ARE EXISTING
FINISH GRADES CHECKED IN THE FIELD ON _____, 19____
AND ARE CORRECT TO THE BEST OF MY KNOWLEDGE AND BELIEF.

REGISTERED SURVEYOR

REG. NO.

TEMP. SAN M.H. RINI, ELEV. = 629.27

Grading Plan Approved
as shown and/or noted
by JAS P. GILLES, P.E.
Lake County Engineer


By GJH Date 2/11/90

1. NO OPEN CUT OF HARDY ROAD IS NOT PERMITTED. BORING IS REQUIRED.
2. ROAD PERMIT FOR BORING IS REQUIRED BY THIS OFFICE.



This Permit Expires
9-11-90
PAINESVILLE TOWNSHIP
ZONING APPROVED
#7612
Zoning Inspector

NORTH

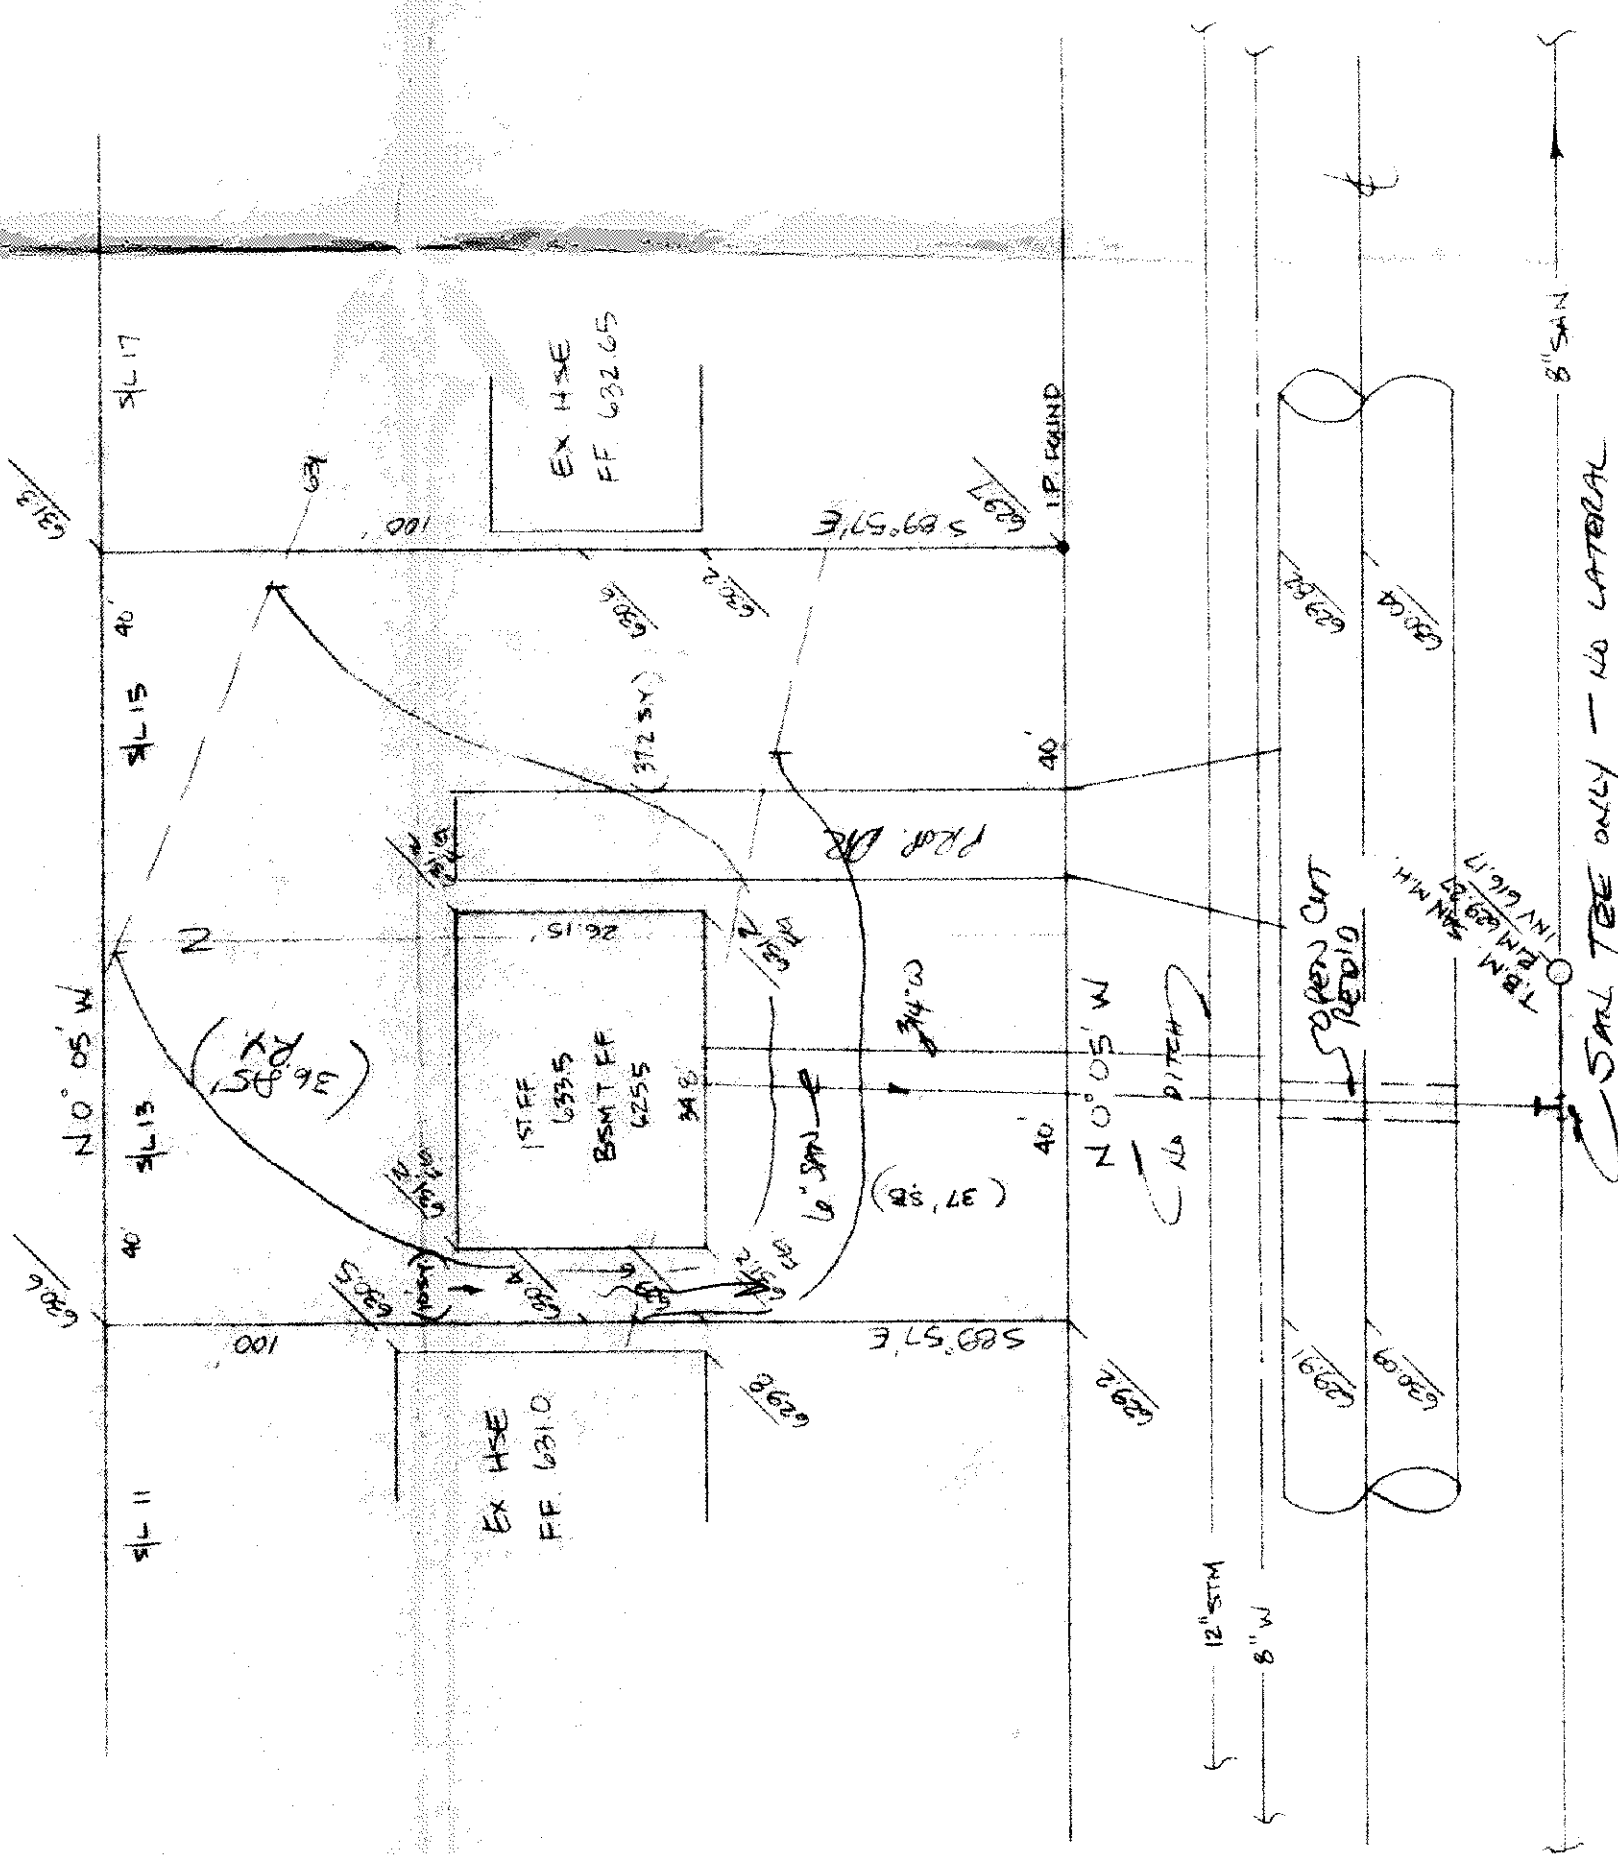

HARDY ROAD - 60'