
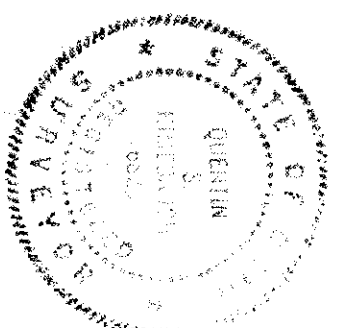


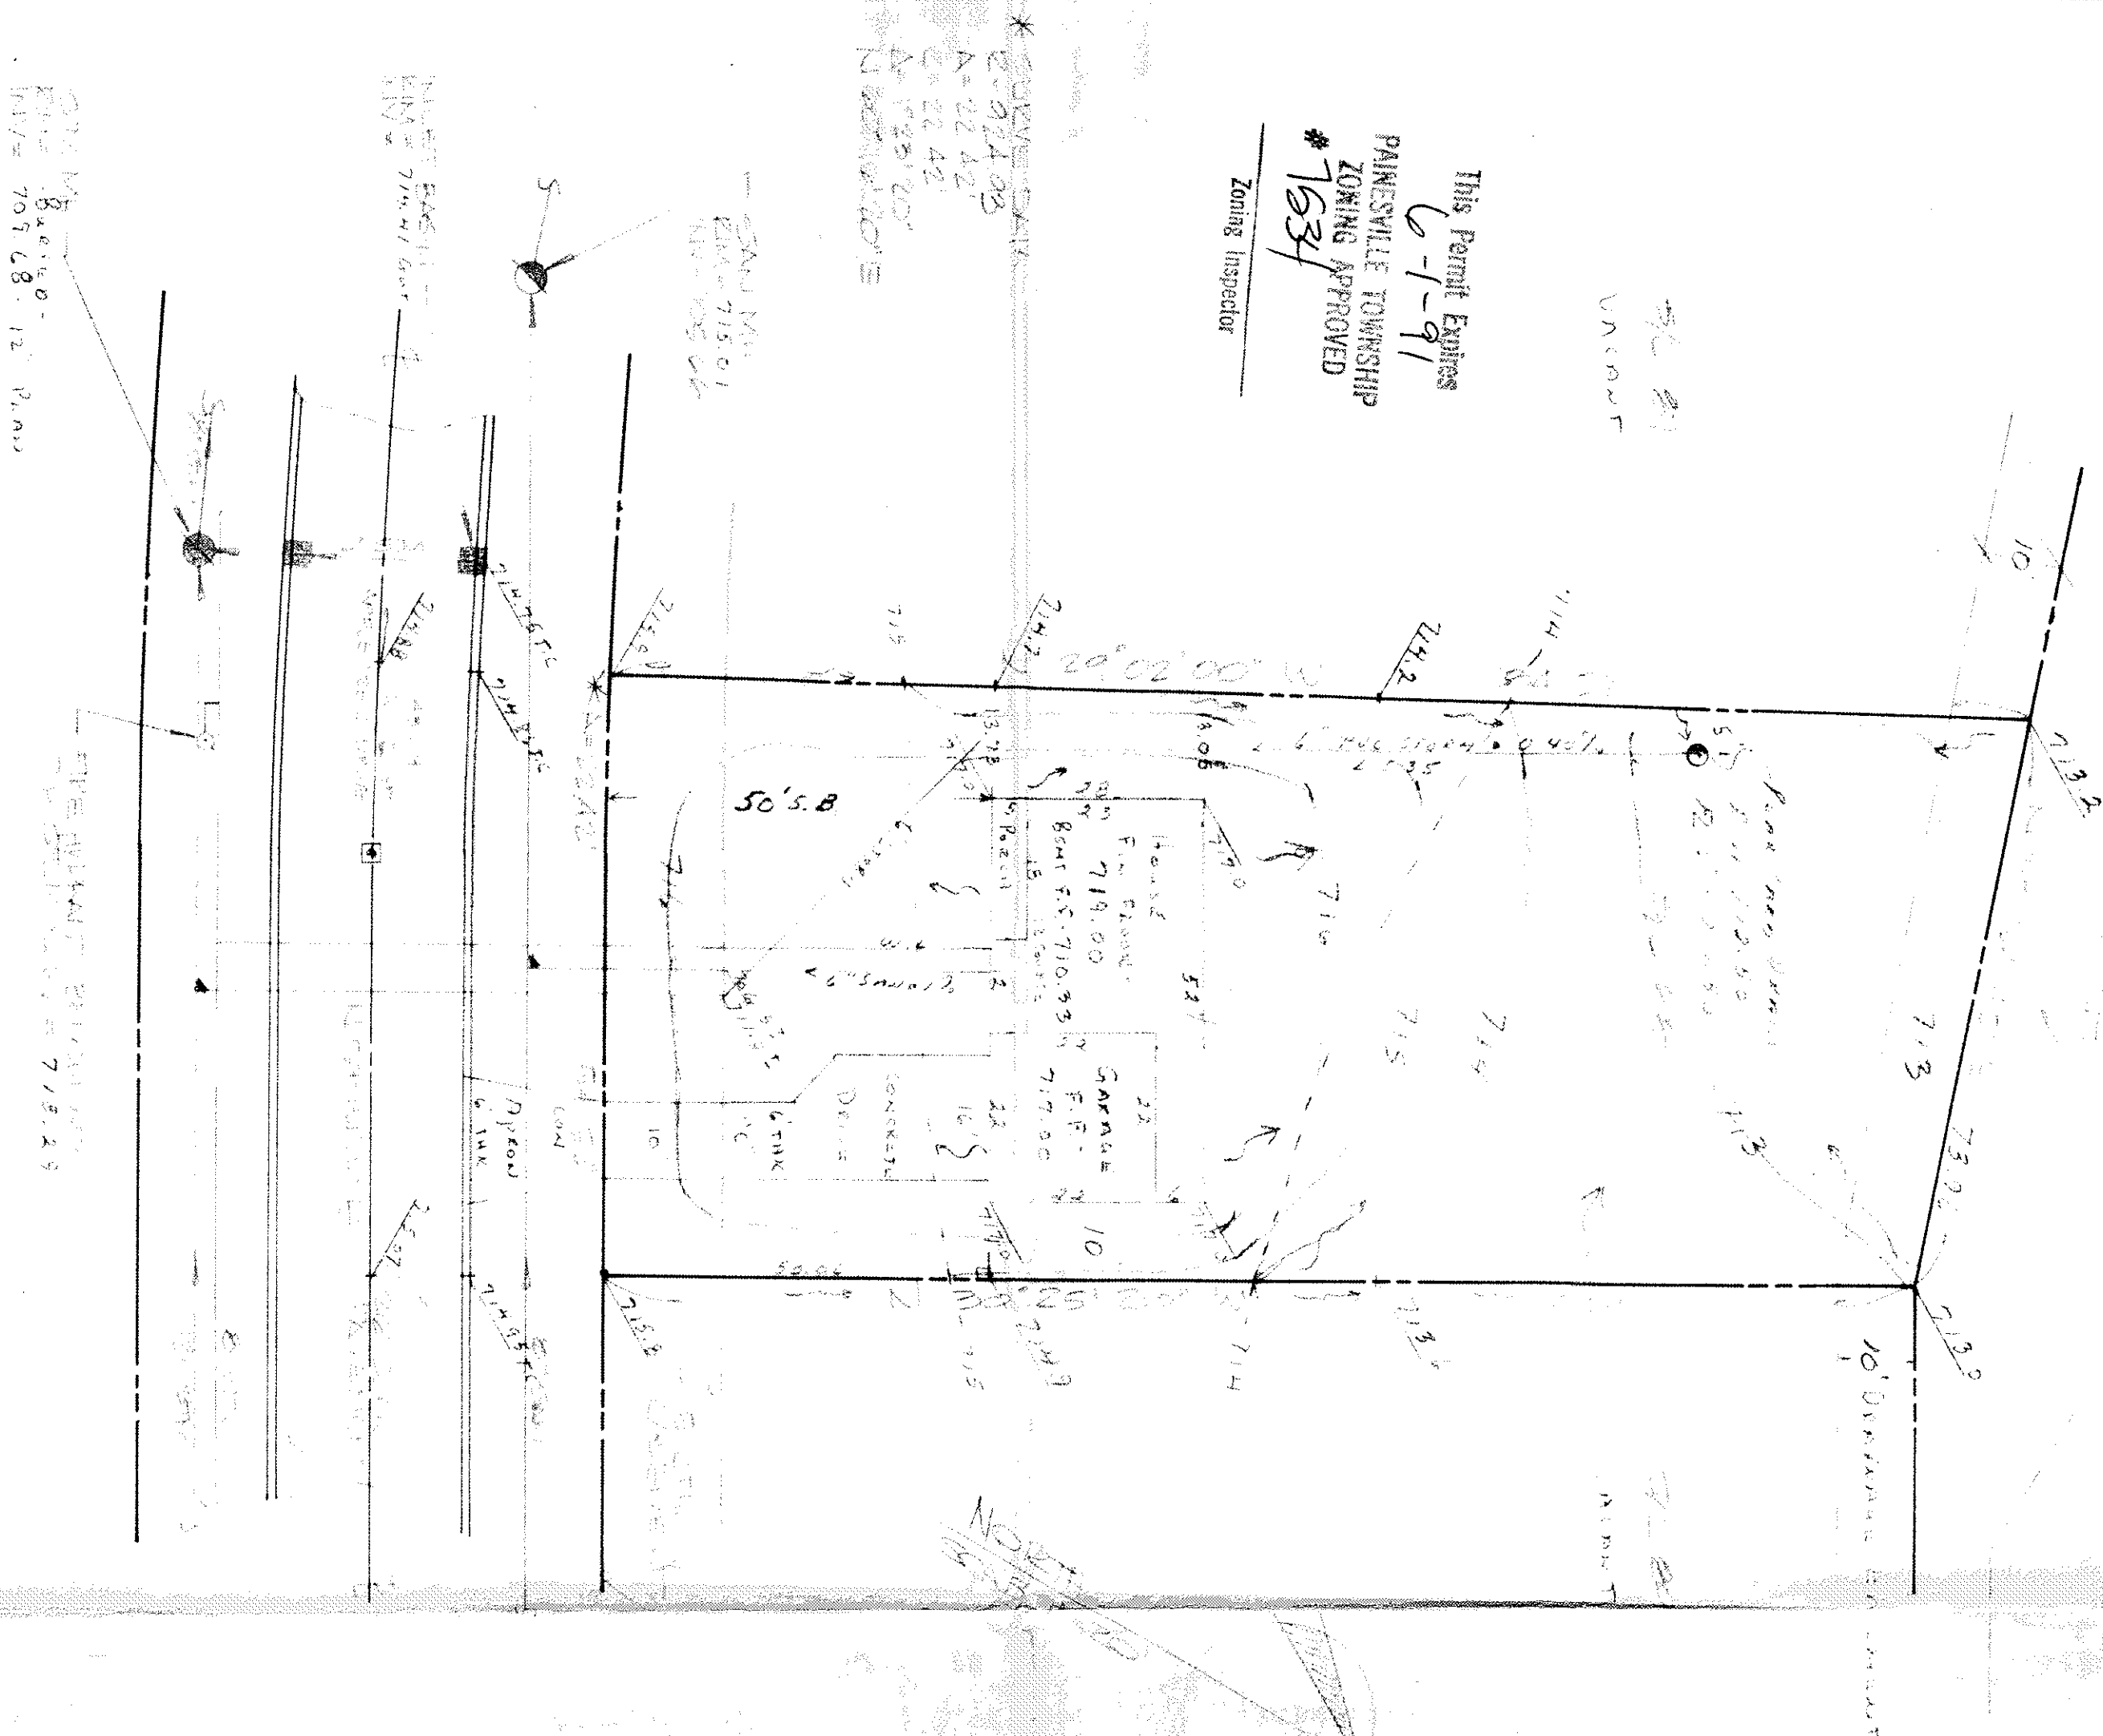

Credit Plan Approved
 Date of Approval 11/1/00
 Approved By: J. L. DILLON, P.E.
 Harris County Engineer
 By GAH
 Date 6/6/00
 1. CONNECT SUMP^{8"} TO PROPOSED
 YARD DRAIN OR 6" STORM.

Empire State

1. The first part of the document is a list of names and their corresponding dates. The names are: John Doe, Jane Smith, and Bob Johnson. The dates are: 1/1/2020, 2/1/2020, and 3/1/2020.

[illegible]

SITE PLAN SHEET 00 HEATHLESTONE DRIVE
 HEATHLESTONE VILLAGE PHASE/LOT TOP
 SCALE: 1" = 20'
 DATE: MAY 12, 2020
 APPROVED BY: J. Hanning
 DRAWN BY: DUDOVNE
 PREPARED BY: THE BAKER AND ASSOCIATES
 2203 N. SPALDING ST. SUITE 200, CHICAGO, IL 60614
 2(6) 046-7721
 DRAWING NUMBER: 20-041-88