

PAINESVILLE TWP., LAKE
COUNTY, OHIO

for: MALKAMAKI BUILDERS
CLIENT OWNER

ADDRESS		CITY		ZIP	
STREET					
HEATHERSTONE SUB SUBDIVISION 2-35 NAME 91 VOL. 14 SUBJ. OF NO. HEATHERSTONE STREET DE		LOT		TRACT	
		VOLUME		PAGE	
		PERM. PARCEL NO.		STREET	

LEGEND	
SAINTARY MANHOLE	①
STORM MANHOLE	②
INLET OR CATCH BASIN	③
HYDRANT	④
EXISTING CONTOURS	—
PROPOSED CONTOURS	—
EXIST. ELEV.	100.0
	100.0
	PROV. ELEV.
WATER VALVE (GAS)	+
WATER METER (GAS)	+
AS BUILT ELEVATION	100.0
INDICATES DIRECTION OF SURFACE DRAINAGE	→

REMARKS
ALL BOUNDARY DATA SHOWN WAS OBTAINED FROM (DEEDS, RECORDED
SUBDIVISION PLAT OR OTHER PUBLIC RECORDS)
LOCATIONS AS SHOWN OF ADJACENT WELLS AND SEPTIC TANKS OBTAINED FROM
LAKE COUNTY HEALTH DEPARTMENT

DESIGN CERTIFICATION

THIS PLAT WAS PREPARED BY ME, AND IS CORRECT
TO THE BEST OF MY KNOWLEDGE AND BELIEF.

NAME JOHN J. BERRY SURVIVOR REGISTRATION NO. 6343

NO. OF BEDROOMS
DIMENSIONS
BEARINGS
THE TO NEAREST STREET
SUBLOT NO.
SURROUNDING OWNERS
ALSO, DIMENSIONS FIN. GR.
ALSO, THE P.L.N. GRASSES
ARROW TYPE WIDTH THICKNESS
SIDEWALK TYPE WIDTH THICKNESS
CULVERT TYPE DIA. LENGTH
ROCK OUTCROPPINGS

WATER MAIN SIZE, LOCATION
SAN, SEWER SIZE & GR. LOC.
SAN, MH, CAST ELEV. INV. ELEV.
SAN, CONN. SIZE, LOC. DEPTH
STORM SEWER SIZE & GR. LOC.
STORM MH, CAST ELEV. INV. ELEV.
PAV'T TYPE GRADE CURVES
GAS LINE LOC. SIZE PRESSURE
SEPTIC TANK LOCATION & DUPLICATION AREA
WELL LOCATION
ISOLATION RADII'S FROM WELL

REVISIONS		
NO.	DATE	BY
1		
2		
3		
4		
5		

PLAN PREPARED BY: BABCOCK • JONES & ASSOCIATES, INC. PAINESVILLE, OHIO		
DRAWN BY <i>DL</i>	SCALE 1" = 20'	PHONE NO. 357-1811
CHECKED <i>HT</i>	DATE 3-7-92	DRAWING NO. 80-004-91
CREW CHIEF <i>WLB</i>	APP'D. <i>HT</i>	

"AS BUILT" CERTIFICATION
I, HEREBY CERTIFY THAT THE CIRCLED GRADES ARE EXISTING
FINISH GRADES CHECKED IN THE FIELD ON _____, 19____
AND ARE CORRECT TO THE BEST OF MY KNOWLEDGE AND BELIEF.

REGISTERED SURVEYOR REG. NO.

BENCHMARK: LIM SAN MH S/L 90, ELEV = 715.30

Grading Plan Approved
as shown and/or noted
by J. P. GILL, P.E.
and County Engineer.

By J/H Date 3/23/92


DISCHARGE SWAMP PUMP TO
STORM SEWER

- SWALE AS SHOWN

This Permit Expires
3/10/93
PAINESVILLE TOWNSHIP
ZONING APPROVED

4-20-17

HEATHERSTONE DRIVE - 600'

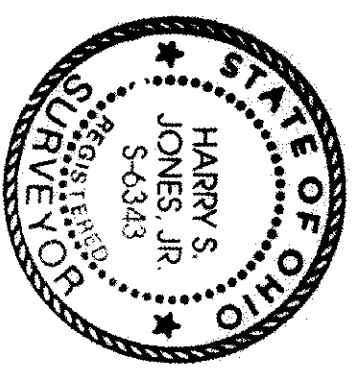

NOTE: Builder shall verify sanitary sewer lateral depth prior to excavation of basement to determine if basement sanitary service is available.

