


This Permit Expires
8/13/92
PAINESVILLE TOWNSHIP
ZONING APPROVED

#7910
D. K. K. K.
Zoning Inspector


"CONTRACTOR TO VERIFY"
1. ELEV'S AND SIZE OF HOUSE.
2. ELEV'S AND LOCATION OF EXISTING
UTILITY CONNECTIONS.
"BEFORE STREETING CONSTRUCTION."

SITE PLAN FOR
CLUBHOUSE
BEING SUBCOT NO. 93 IN THE
HEATHERSTONE VILLAGE NO. 1
RECORDED IN V. 2 PG. 35-6
PAINESVILLE TOWNSHIP, LAKE COUNTY
MAY 1991 SCALE: 1"=20'

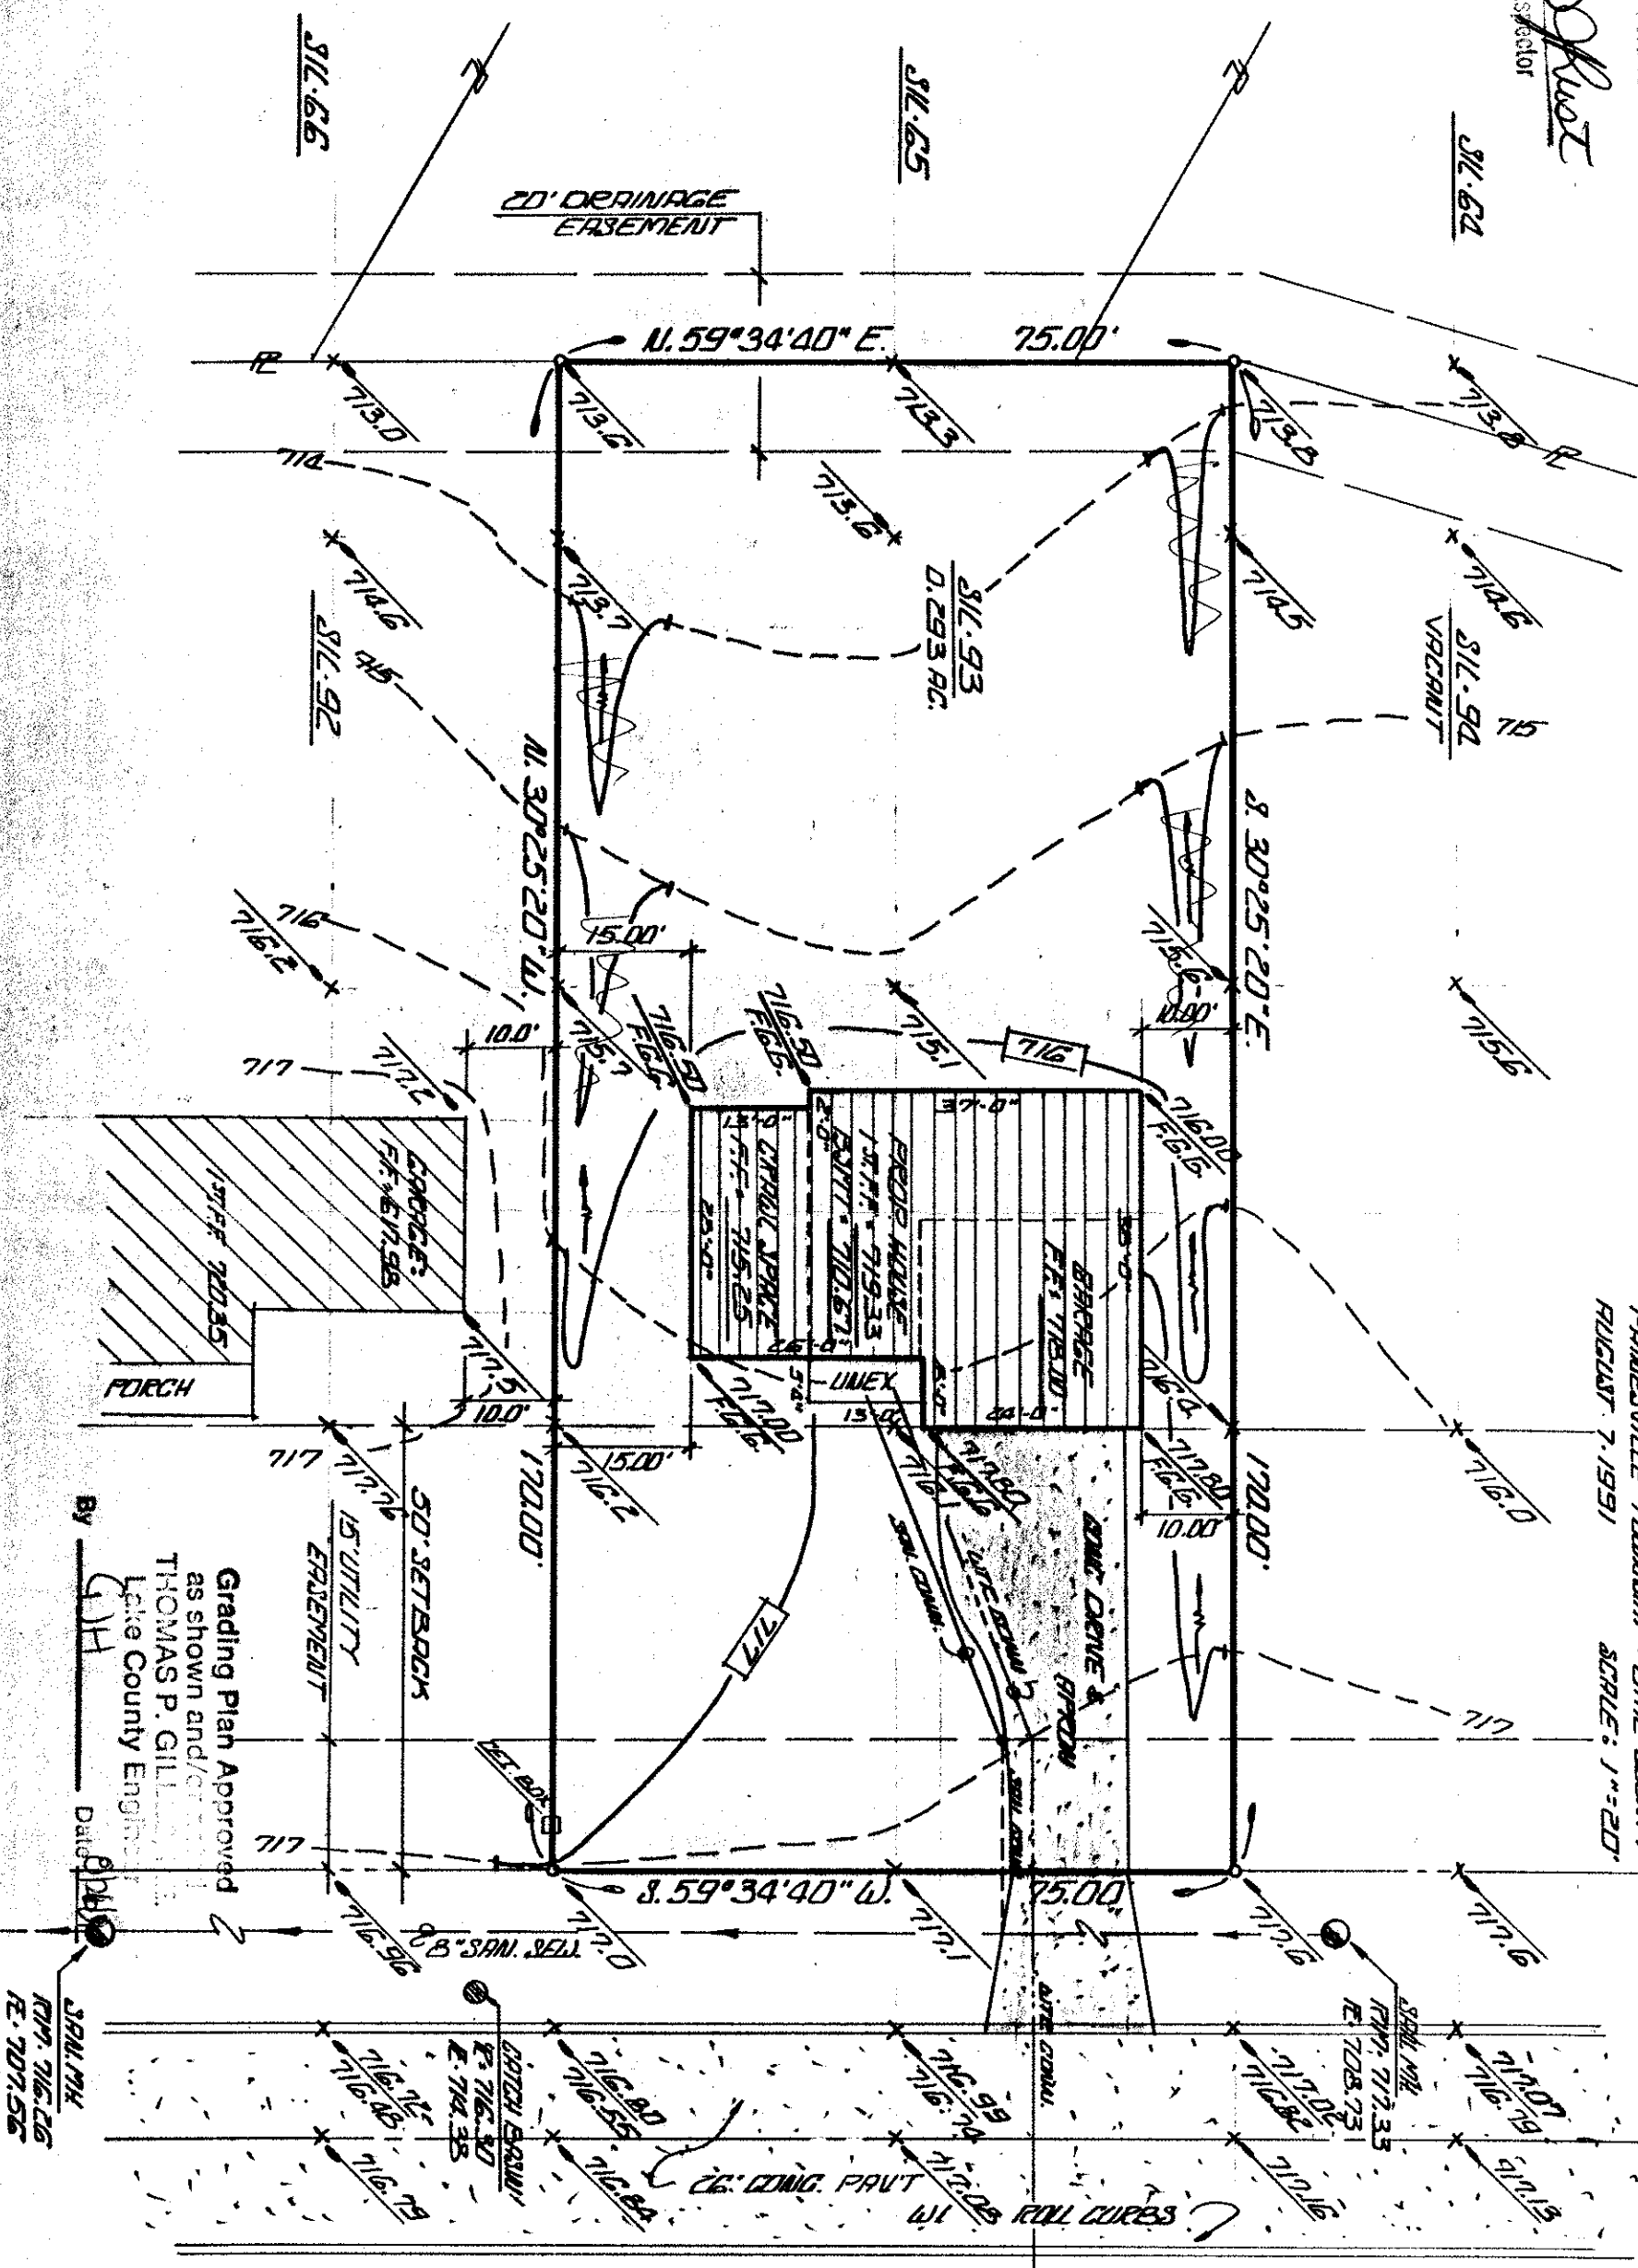

HEATHERSTONE DRIVE 60'

BEACHMERE:
TOP OF E. HYDRAULIC
ELEV. 719.60

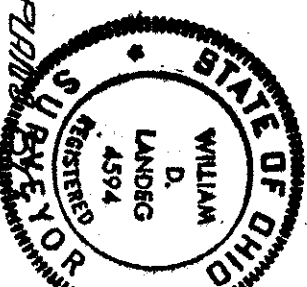

LAKE INC.

ENGINEERS & SURVEYORS
30601 EUGENIO AVENUE
WICKLIFFE, OHIO 44092

AUG 07 1991

LAKE INC.

JOB NO. 91-170