



SITE PLAN

FOR
R.C. REED CONST.
BEING SUBLOT No 97, HEATHERSTONE
VILLAGE SUBD. No. 1, IN THE TOWNSHIP
OF PAINESVILLE, LAKE COUNTY, OHIO.

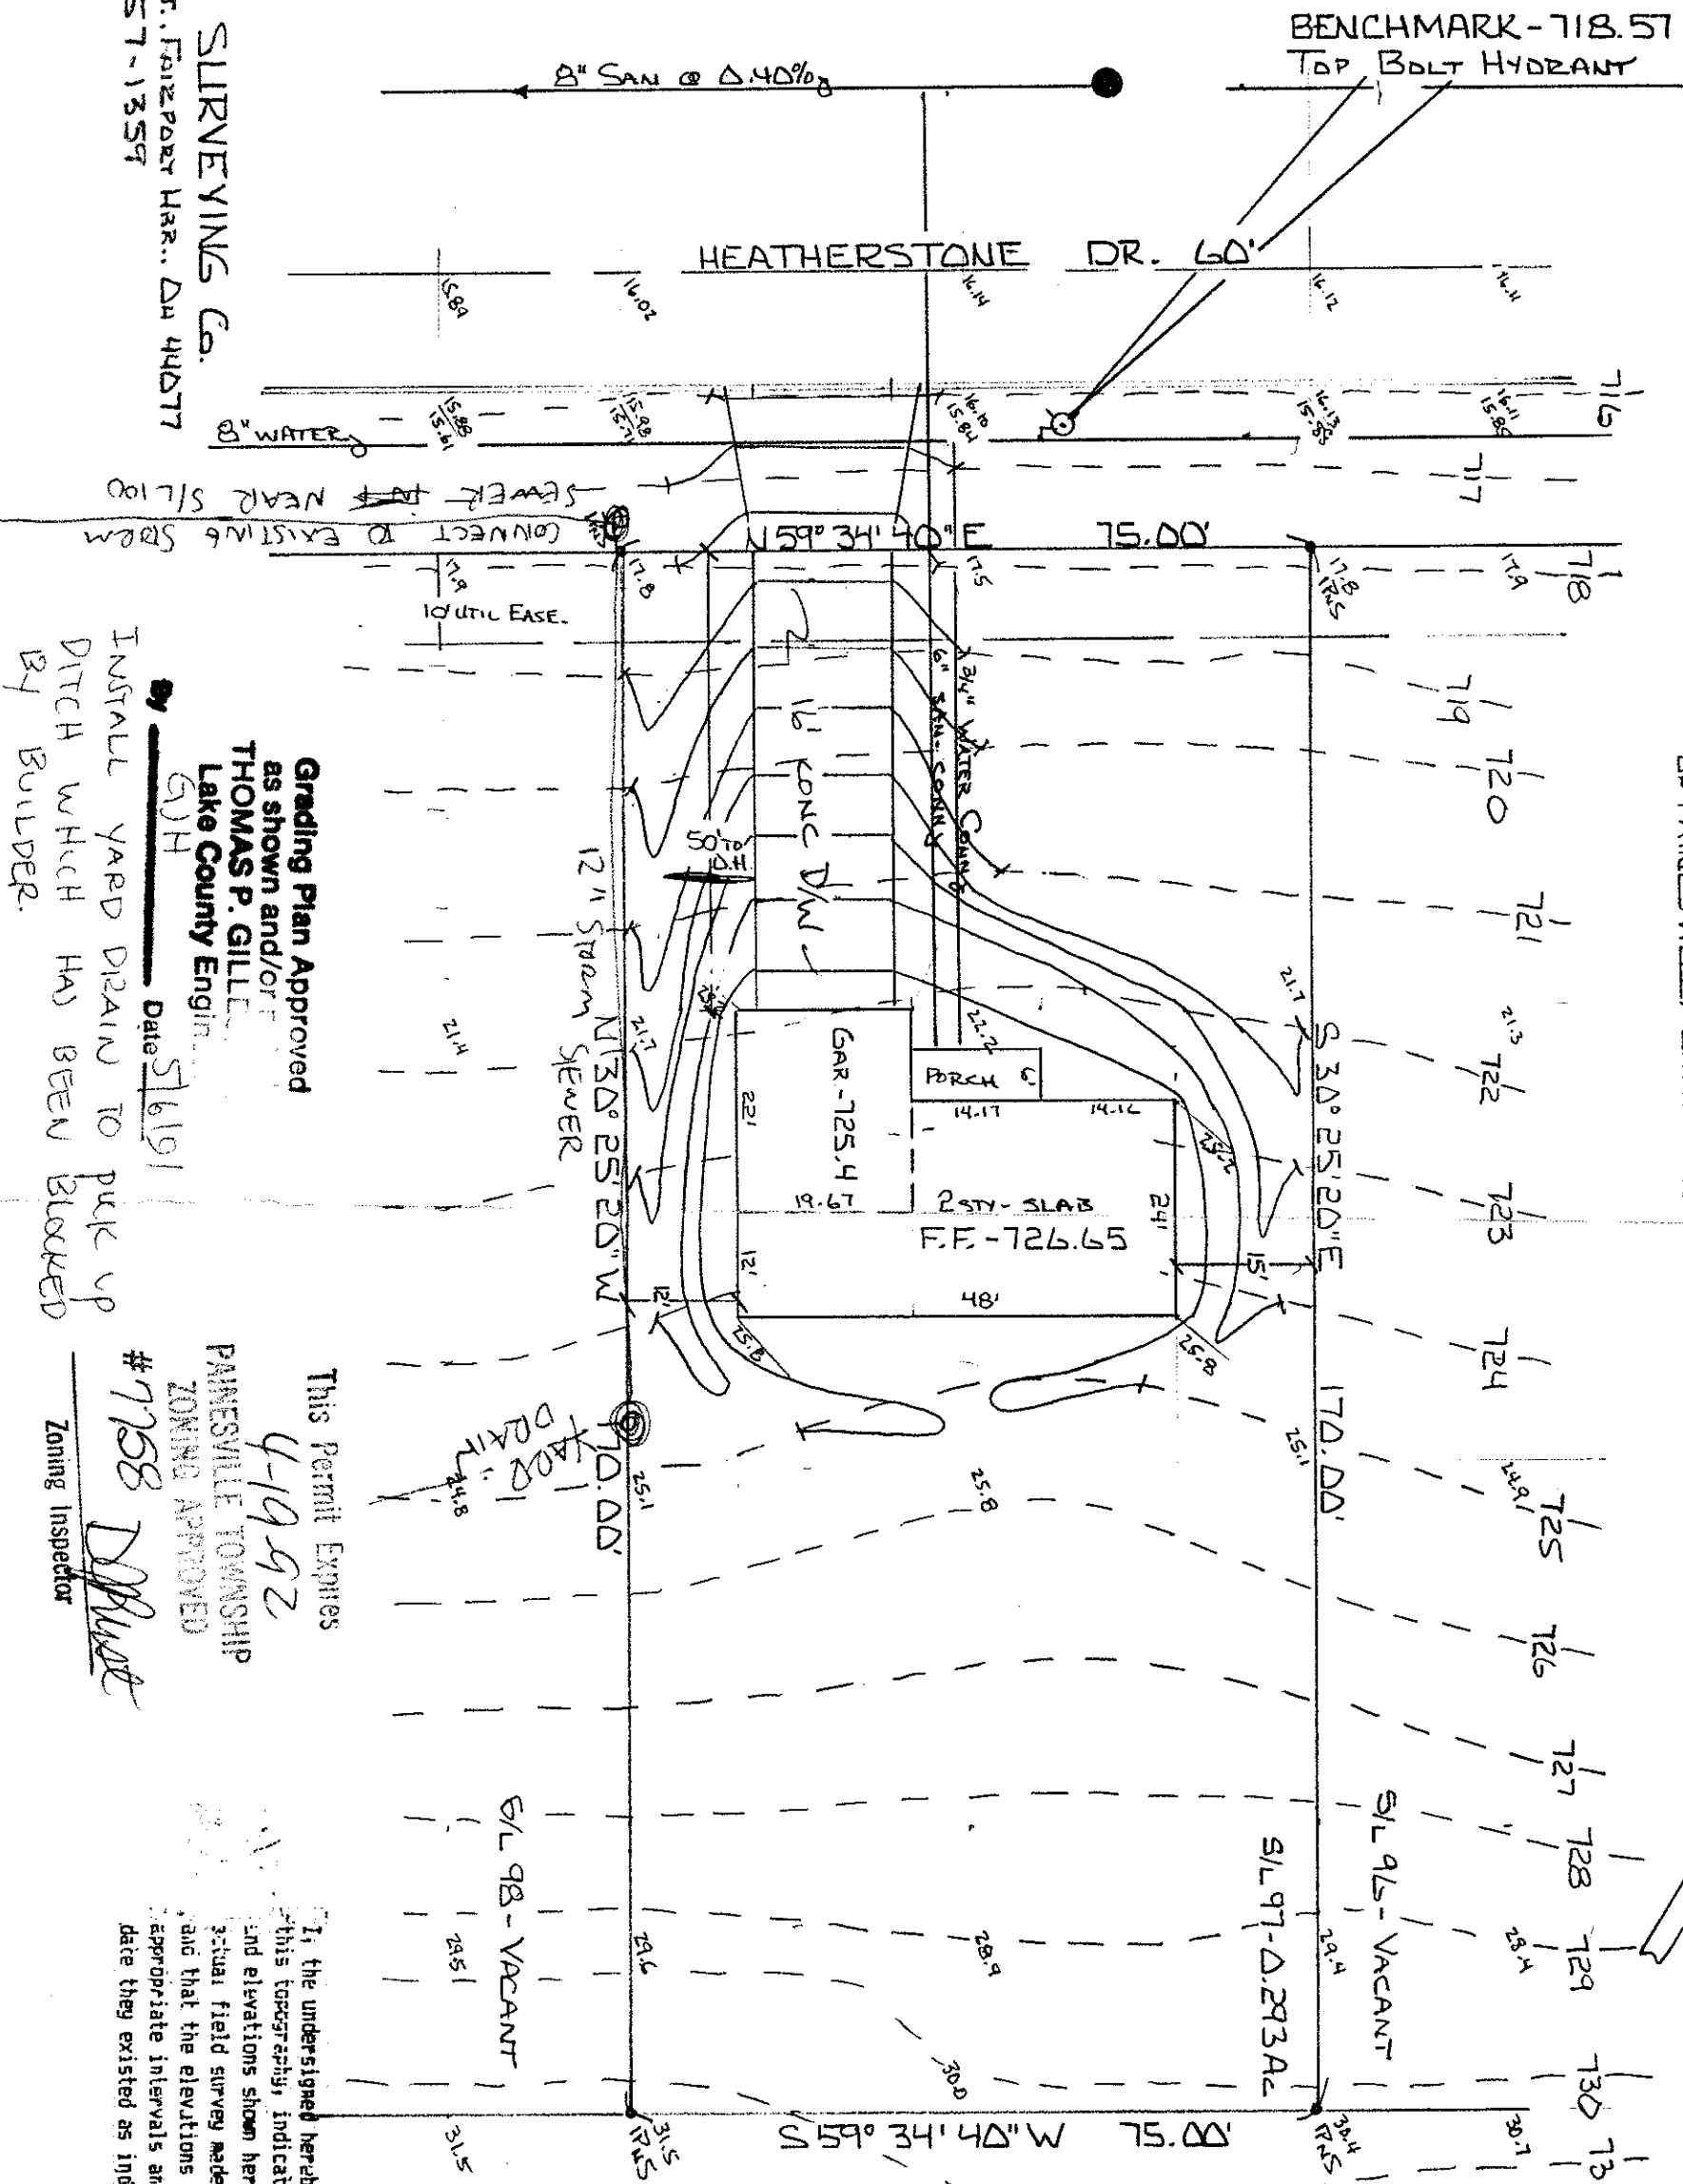

L.T. & M. CURTIS & J.C. JOHNSON
VOL. 617-448

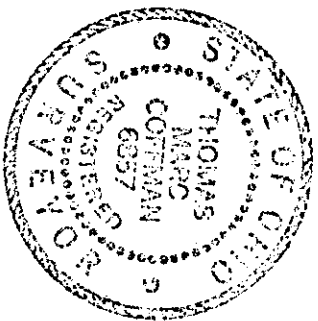

Grading Plan Approved
as shown and/or

THOMAS P. GILLE
Lake County Engineer

by GJH Date 5/6/91

INSTALL YARD DRAIN TO PICK UP
DITCH WHICH HAS BEEN BLOCKED
BY BUILDER.

This Permit Expires

4-19-92

PAINESVILLE TOWNSHIP
ZONING APPROVED

#7758

Zoning Inspector

I, the undersigned hereby certify that
this topography, indicated by 1" = 20',
and elevations shown hereon represent an
actual field survey made by me on 3-14-91
and that the elevations were taken at
appropriate intervals and that as of that
date they existed as indicated hereon.

J.W. Coffman P.E.
No. 6057

VILLAGE SURVEYING Co.

222 THIRD ST. FAIRPORT HARBOR, OH 44027
(216) 357-1357