

S/L 65*
<VACANT>

<VACANT>

*S/L 93
<VACANT>

PLAT OF SURVEY
FOR
R.C. REED

VILLAGE SURVEYING CO.
202 THIRD ST. FAIRPORT HARBOR, OH. 44017
(216) 357-1359

(216) 357-1359

Val. 836-372


HEATHERSTONE VILLAGE DEV. CORP.

* ALL FOUR LOTS:

Grading Plan Approved
as shown and/or noted
THOMAS P. GILLES, P.E.
Lake County Engineer
6/14
Date 10/1/01
I. Swale AS SHOWN.

~~William E. Montgomery~~
Zoning Inspector 10/13/89
2369

10-13-98
This Permit Expires
PAINESVILLE TOWNSHIP
ZONING APPROVED

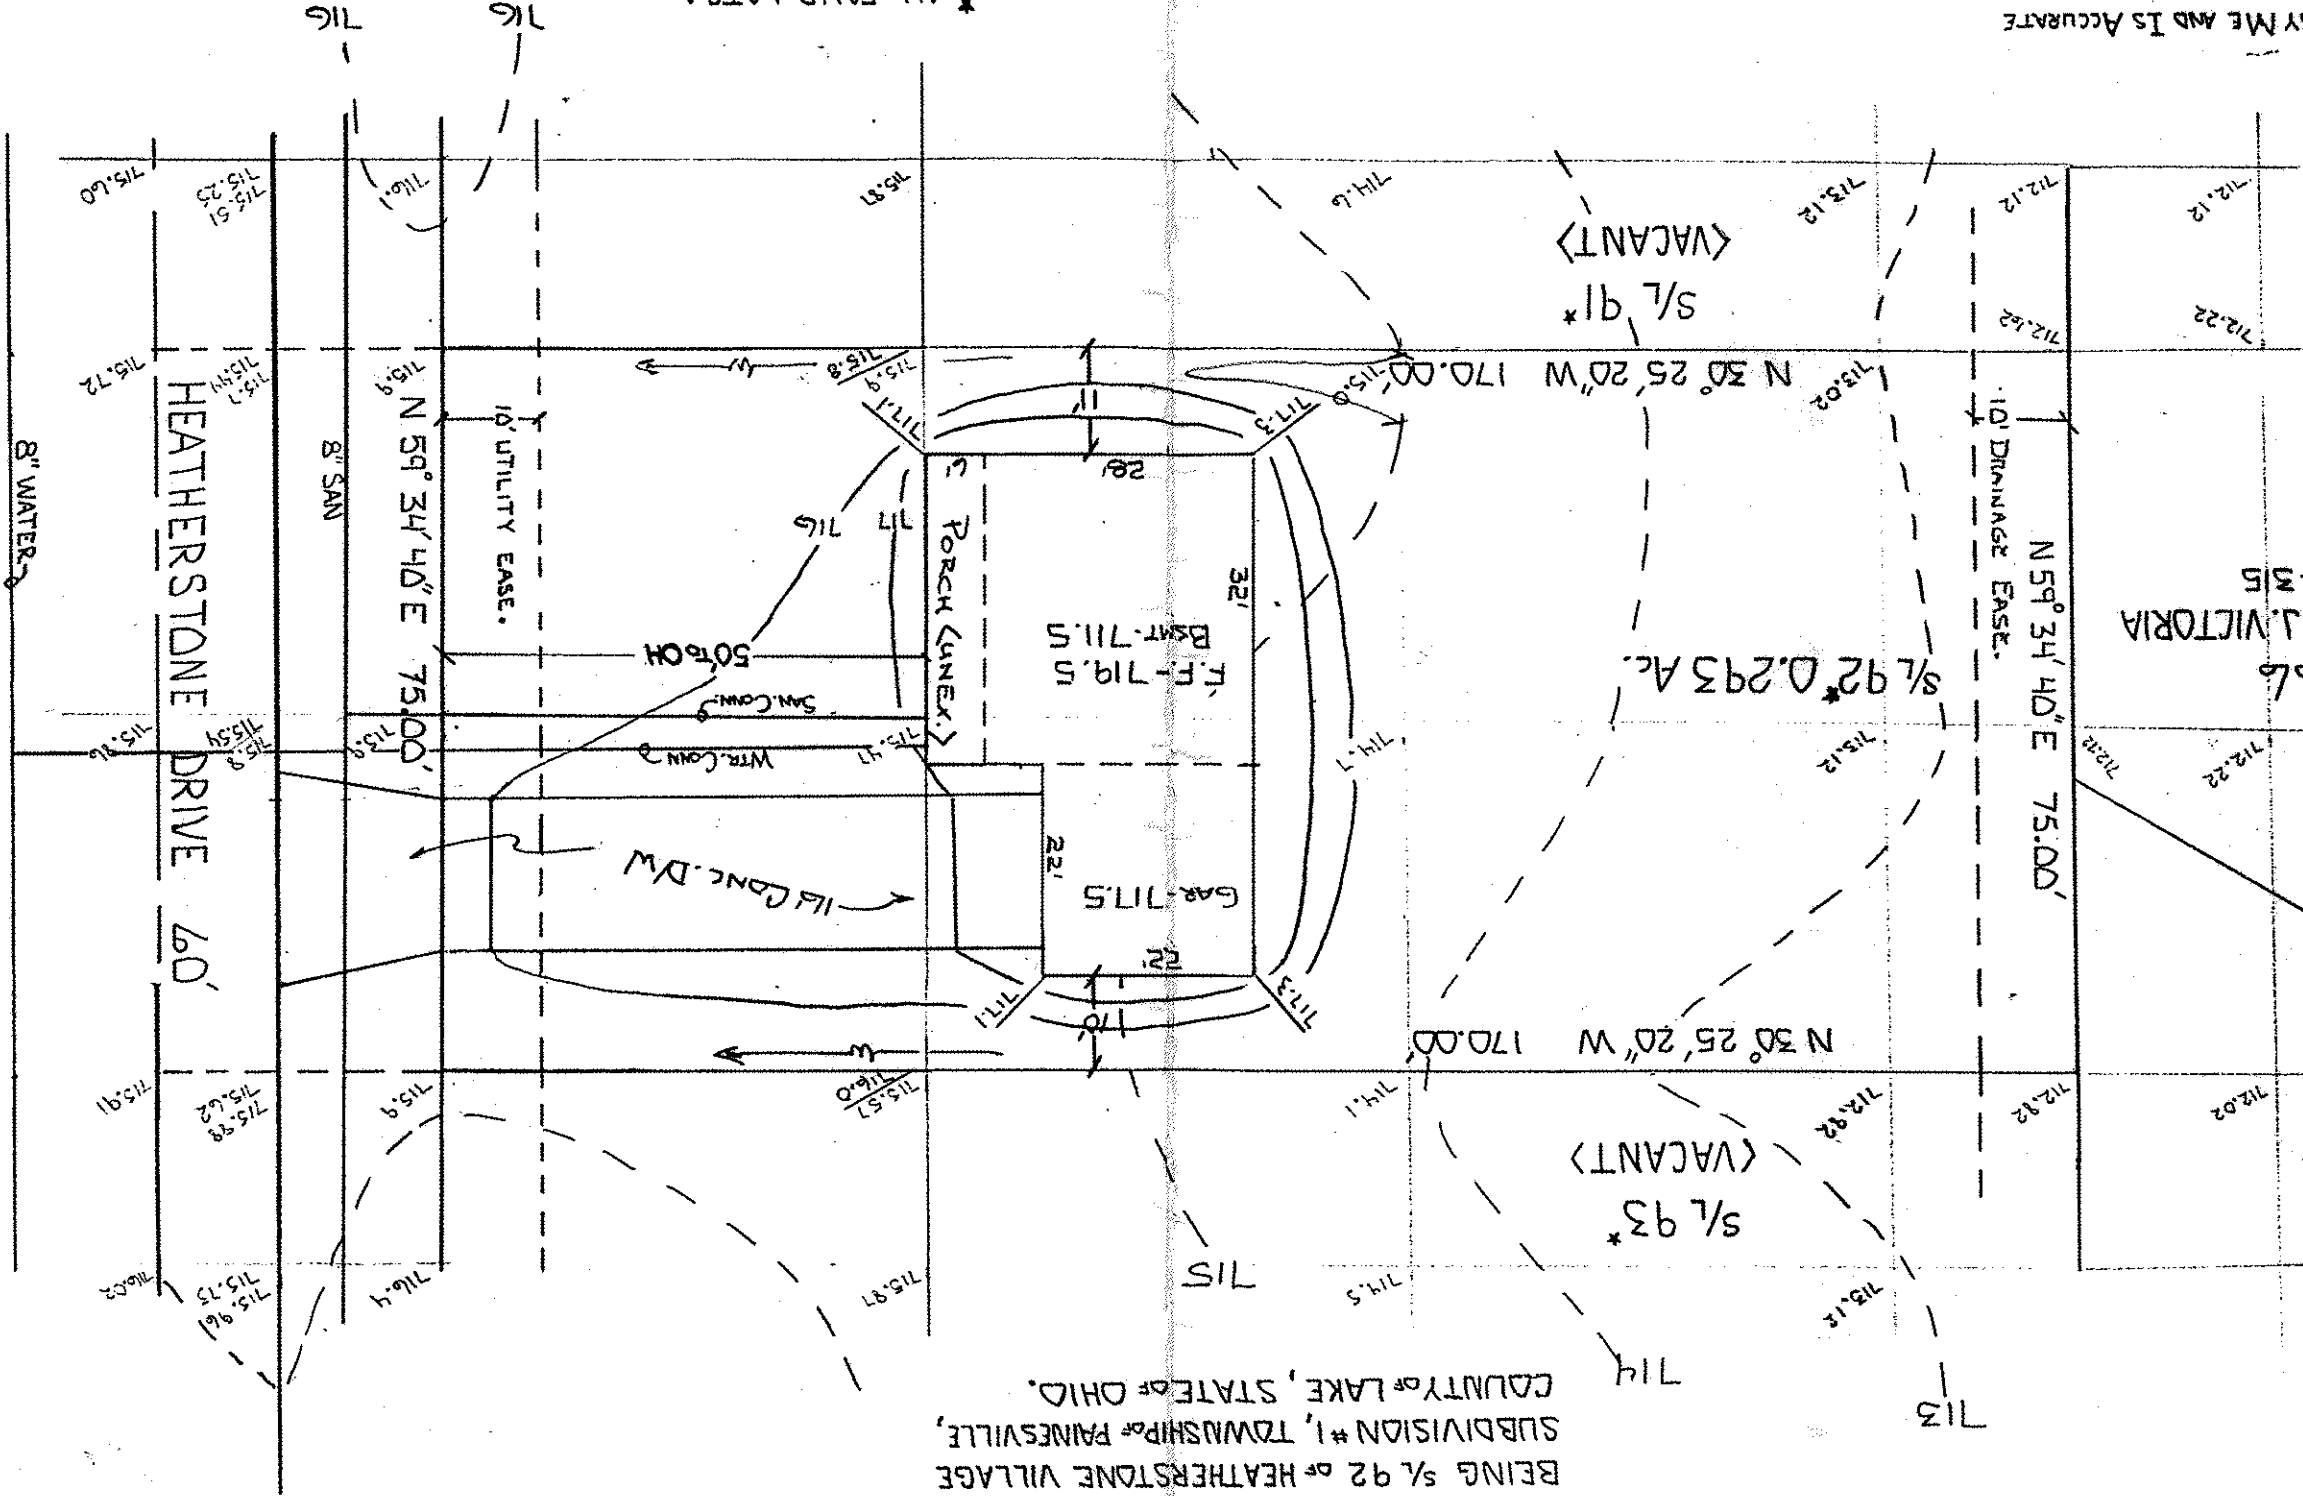

EXIST. ~~PROT.~~

