


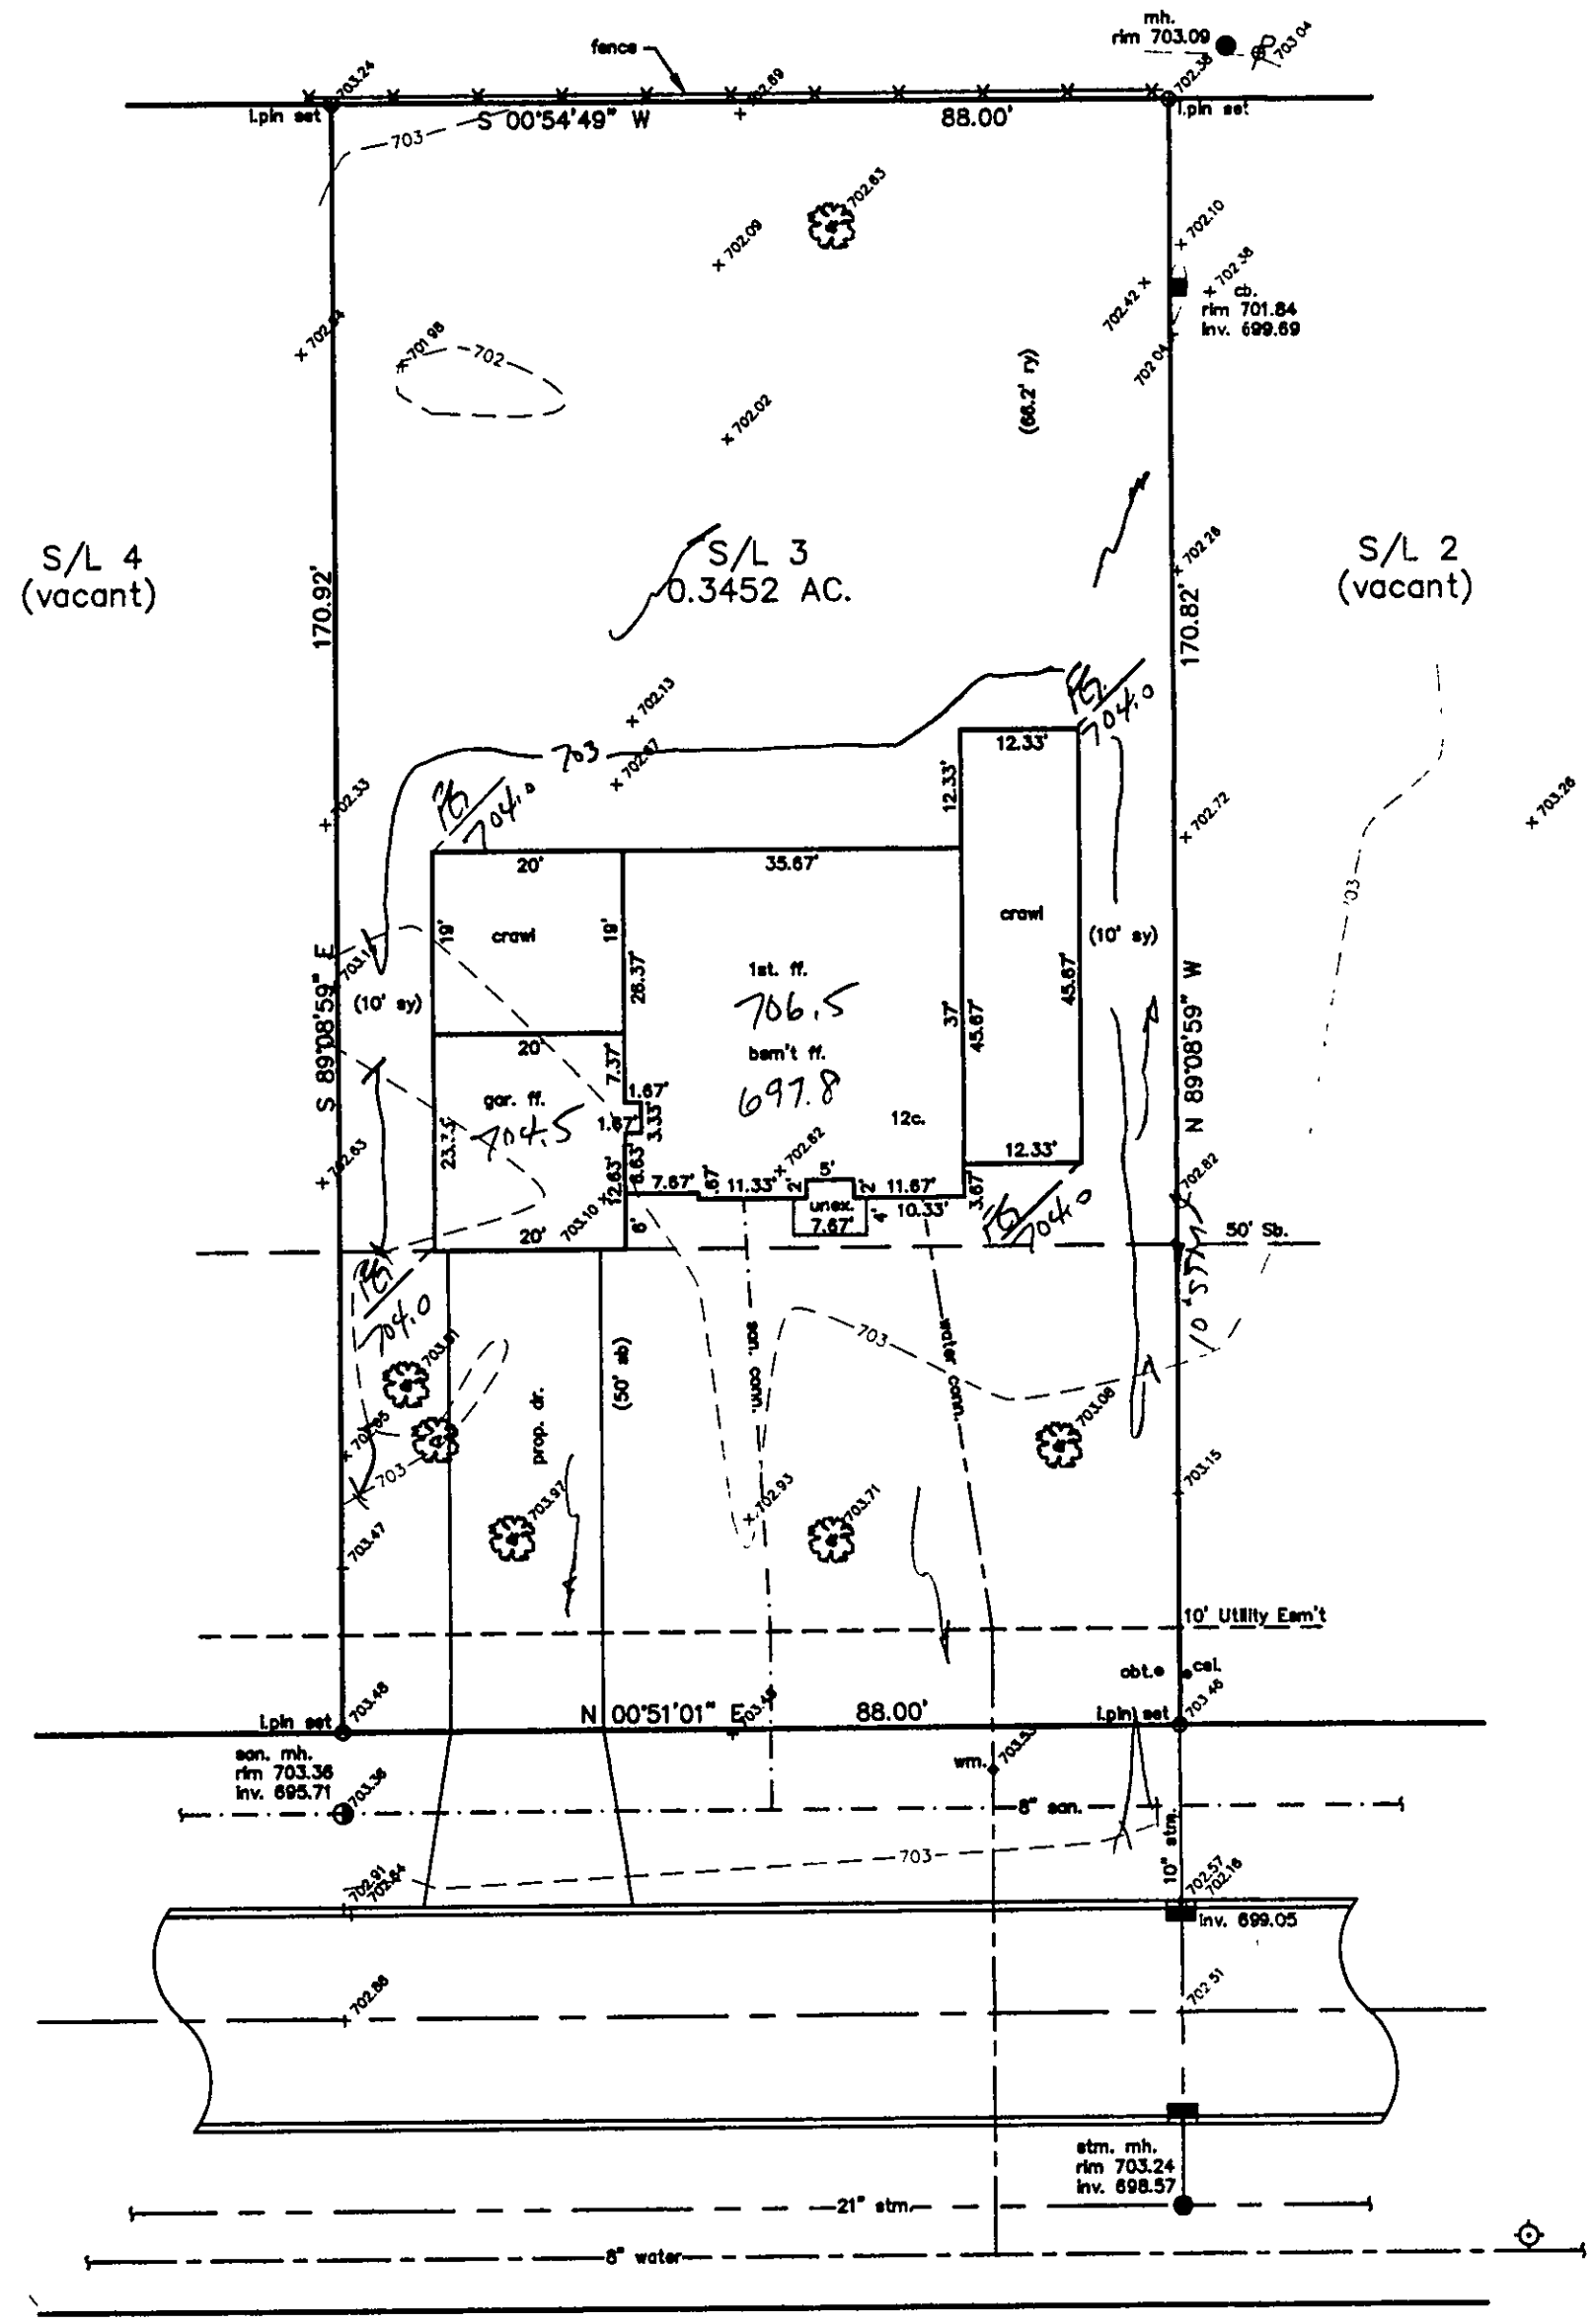

HELENE DRIVE - 60'

SITE PLAN

PAINESVILLE TWP., LAKE COUNTY, OHIO

for: KAY HOMES

CLIENT		OWNER	
ADDRESS	STREET	CITY	ZIP
SOMERSET MEADOWS			
SUBDIVISION	33-18	NAME	TRACT
3	VOL-PG.	HELENE DR.	LOT
SUBLOT NO.	STREET	VOL-PG.	PERM. PARCEL NO.

LEGEND

SANITARY MANHOLE	--- (1) ---	EXIST. ELEV. --- 100.0 ---	PROP. ELEV. --- 100.0 ---
STORM MANHOLE	--- (2) ---	AS BUILT ELEVATION	
INLET OR CATCH BASIN	--- (3) ---	INDICATES DIRECTION OF SURFACE DRAINAGE	
HYDRANT	--- (4) ---		
EXISTING CONTOURS	--- (5) ---		
PROPOSED CONTOURS	--- (6) ---		

REMARKS

ALL BOUNDARY DATA SHOWN WAS OBTAINED FROM (DEEDS, RECORDED SUBDIVISION PLAT OR OTHER PUBLIC RECORDS)

LOCATIONS AS SHOWN OF ADJACENT WELLS AND SEPTIC TANKS OBTAINED FROM LAKE COUNTY HEALTH DEPARTMENT

DESIGN CERTIFICATION

THIS PLAT WAS PREPARED BY ME, AND IS CORRECT TO THE BEST OF MY KNOWLEDGE AND BELIEF

NAME: Thomas P. Gilles SURVEYOR REGISTRATION NO. 98-228-03

CHECK LIST

NO. OF BEDROOMS	WATER MAIN SIZE, LOCATION
DIMENSIONS	SAN. SEWER SIZE & GR. LOC.
BEARINGS	SAN. MH. CAST. ELEV. INV. ELEV.
TIE TO NEAREST STREET	SAN. CONN. SIZE, LOC. DEPTH
SUBLOT NO. PARCEL NO.	STORM SEWER SIZE & GR. LOC.
SURROUNDING OWNERS	STORM MH. CAST ELEV. INV. ELEV.
BLDG. DIMENSIONS FIN GR.	PWT TYPE GRADE CURVES
BLDG. TIES FL'R. GRADES	GAS LINE LOC. SIZE PRESSURE
APRON TYPE WIDTH THICKNESS	SEPTIC TANK LOCATION & DUPLICATION AREA
SIDEWALK TYPE WIDTH THICKNESS	WELL LOCATION
CULVERT TYPE DIA. LENGTH	ISOLATION RADIUS FROM WELL
ROCK OUTCROPPINGS	

REVISIONS			PLAN PREPARED BY:	
NO.	DATE	BY	BABCOCK JONES & ASSOCIATES, INC.	
1			PAINESVILLE, OHIO	
2				
3			DRAWN BY T.R.	SCALE 1"=20' PHONE NO. 440-357-1811
4			CHK'D. H.J.	DATE 1/20/00 DRAWING NO. 98-228-03
5			CREW CHIEF W.B.	APP'D H.J.

"AS BUILT" CERTIFICATION

I, HEREBY CERTIFY THAT THE CIRCLED GRADES ARE EXISTING FINISH GRADES CHECKED IN THE FIELD ON 20 AND ARE CORRECT TO THE BEST OF MY KNOWLEDGE AND BELIEF.

REGISTERED SURVEYOR	REG. NO.
TBM-TOP OF HYDRANT S/L 22	
ELEV.=705.72	

Grading Plan Approved as shown and/or noted
THOMAS P. GILLES, P.E.
Lake County Engineer

By TAM Date 2/4/2000

ROOF DRAINS SHALL DISCHARGE TO SPLASH BLOCKS.

APPROVED
PAINESVILLE TOWNSHIP
ZONING DEPARTMENT
2000-013
D. Rust

