

**SITE PLAN**

**PAINESVILLE TWP., LAKE COUNTY, OHIO**

for: **SHAMROCK**

CLIENT		OWNER	
ADDRESS	STREET	CITY	ZIP
<b>SOMMERSET MEADOWS</b>			
SUBDIVISION	33-18	NAME	TRACT
23	VOL-76	HELENE DR.	LOT
SUBLOT NO.	STREET	VOL-PG.	PERM. PARCEL NO.

**LEGEND**

SANITARY MANHOLE	---○---	EXIST. ELEV. $\rightarrow$ 100.0	PROP. ELEV. $\rightarrow$ 100.0
STORM MANHOLE	---●---	AS BUILT ELEVATION	
INLET OR CATCH BASIN	---□---	INDICATES DIRECTION OF SURFACE DRAINAGE	
HYDRANT	---◇---	INDICATES DIRECTION OF SURFACE DRAINAGE	
EXISTING CONTOURS	---○---	INDICATES DIRECTION OF SURFACE DRAINAGE	
PROPOSED CONTOURS	---○---	INDICATES DIRECTION OF SURFACE DRAINAGE	

**REMARKS**

ALL BOUNDARY DATA SHOWN WAS OBTAINED FROM (DEEDS, RECORDED SUBDIVISION PLAT OR OTHER PUBLIC RECORDS)  
 LOCATIONS AS SHOWN OF ADJACENT WELLS AND SEPTIC TANKS OBTAINED FROM LAKE COUNTY HEALTH DEPARTMENT

**DESIGN CERTIFICATION**

THIS PLAT WAS PREPARED BY ME, AND IS CORRECT TO THE BEST OF MY KNOWLEDGE AND BELIEF

NAME: *Harry Jones* REGISTRATION NO. *10343*

**CHECK LIST**

NO. OF BEDROOMS	WATER MAIN SIZE, LOCATION
DIMENSIONS	SAN. SEWER SIZE & GR. LOC.
BEARINGS	SAN. MH. CAST. ELEV. INV. ELEV.
TIE TO NEAREST STREET	SAN. CONN. SIZE, LOC. DEPTH
SUBLOT NO. PARCEL NO.	STORM SEWER SIZE & GR. LOC.
SURROUNDING OWNERS	STORM MH. CAST ELEV. INV. ELEV.
BLDG. DIMENSIONS FIN GR.	PAV'T TYPE GRADE CURBS
BLDG. TIES FL'R. GRADES	GAS LINE LOC. SIZE PRESSURE
APRON TYPE WITH THICKNESS	SEPTIC TANK LOCATION & DUPLICATION AREA
SIDEWALK TYPE WITH THICKNESS	WELL LOCATION
CULVERT TYPE DIA., LENGTH	ISOLATION RADIUS FROM WELL
ROCK OUTCROPPINGS	

REVISIONS			PLAN PREPARED BY:		
NO.	DATE	BY	BABCOCK JONES & ASSOCIATES, INC.		
1			PAINESVILLE, OHIO		
2			DRAWN BY	T.R.	SCALE 1"=20'
3			CHK'D.	H.J.	DATE 10/22/99
4			APP'D	H.J.	PHONE NO. 440-357-1811
5			CHEF	K.J.	DRAWING NO. 98-228-23

**"AS BUILT" CERTIFICATION**  
 I, HEREBY CERTIFY THAT THE CIRCLED GRADES ARE EXISTING FINISH GRADES CHECKED IN THE FIELD ON 10/22/99, 1999 AND ARE CORRECT TO THE BEST OF MY KNOWLEDGE AND BELIEF.

REGISTERED SURVEYOR \_\_\_\_\_ REG. NO. \_\_\_\_\_


TBM-TOP OF HYDRANT S/L 22  
 ELEV.=705.72

Grading Plan Approved as shown and/or noted  
**THOMAS P. GILLES, P.E.**  
 Lake County Engineer

By *T.P.G.* Date *11/15/99*

ROOF DRAINS SHALL DISCHARGE TO SPLASH BLOCKS.

APPROVED  
 PAINESVILLE TOWNSHIP ZONING DEPARTMENT  
*199 90363*  
*D.J.O.*

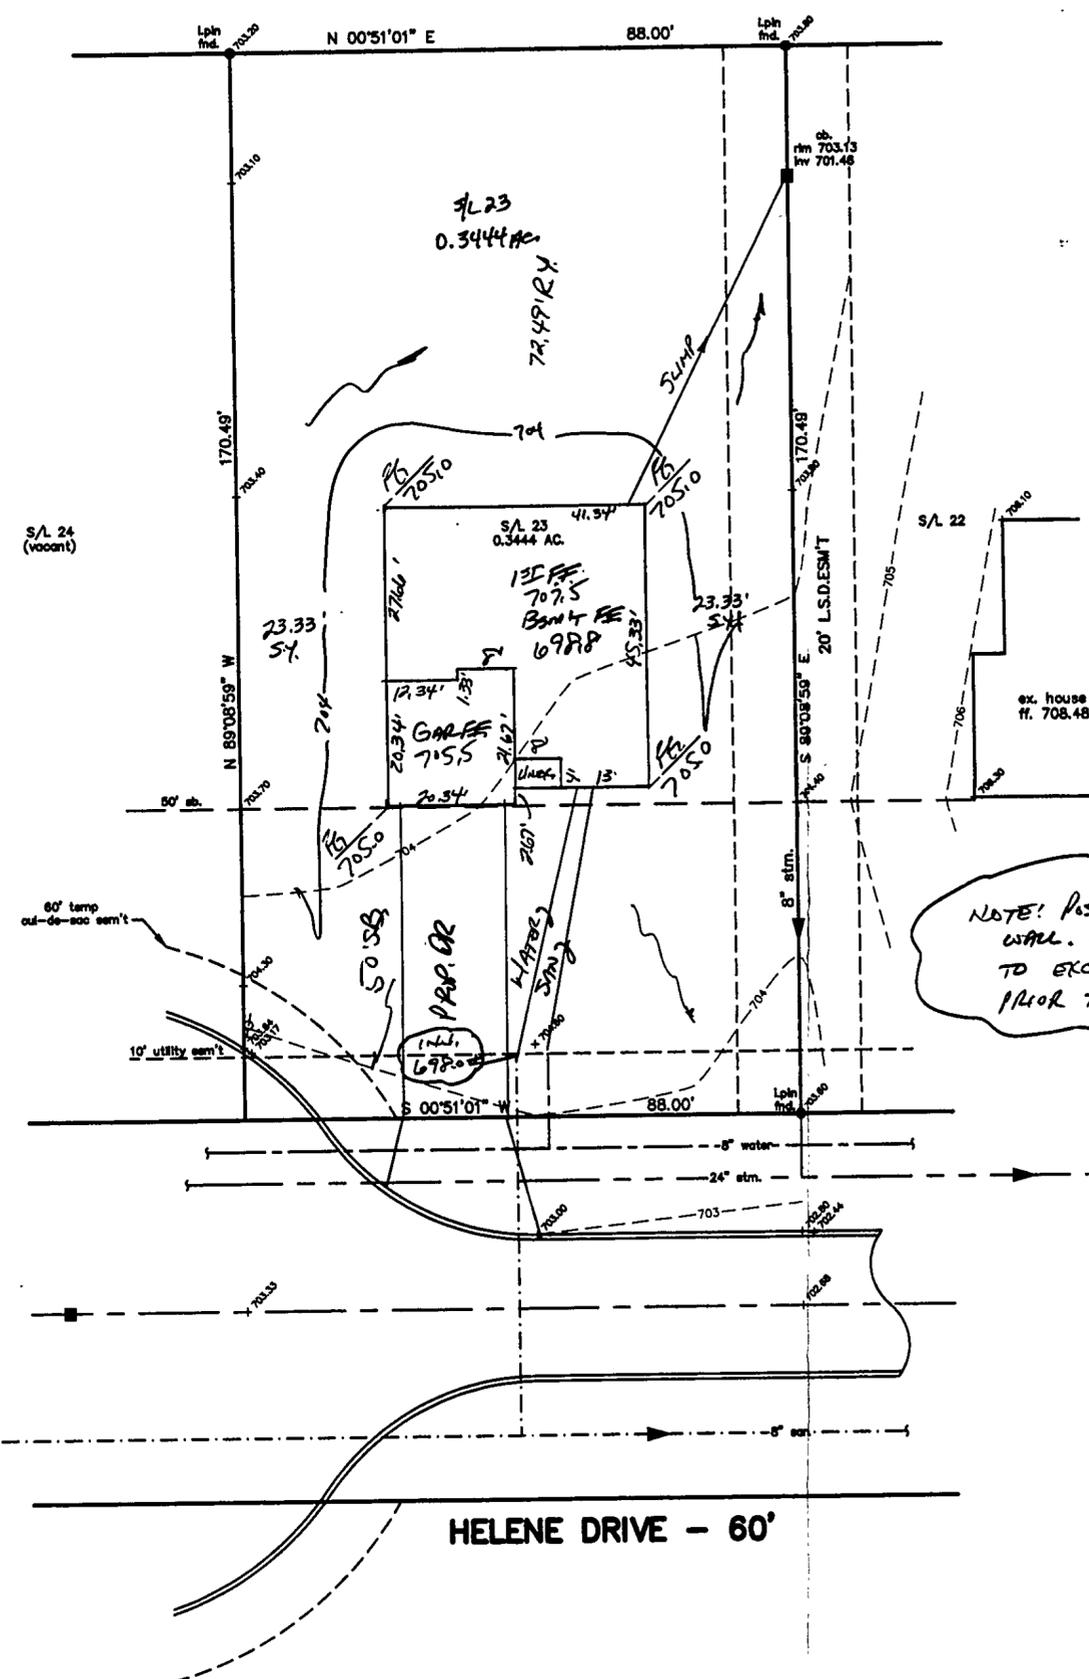

con. mh.  
 rim 704.50  
 inv. 697.00

stm. mh.  
 rim 703.07  
 inv. 698.57(out)