


for	TIM PIATAK			
	B600	EAST AVE.	MENTOR	
	ADDRESS	STREET	CITY	
23	URBANHURST ALLOTMENT G 8			
SUBLOT No.	SUBDIVISION NAME		VOL.	PAGE
51 4	PAINESVILLE		OHIO	
LOT, TRACT	OFFY/70 PARTNERSHIP			



GUTOSKEY & ASSOCIATES INC.
Civil Engineers and Surveyors
8227 E. Washington St.
Chagrin Falls, Ohio 44023 Tel (216) 543-6900
Fax (216) 543-7176

CHECK LIST

LOT DIMENSIONS & BEARINGS
 TIE TO NEAREST STREET
 SUBJECT NO. (PARCEL NO.)
 SURROUNDING OWNERS
 BUILDING DIMENSIONS
 SETBACK SIDEYARD, REARYARD
 FINISHED GRADES
 DRIVE & APRON TYPE, WIDTH, THICKNESS
 7. TANK TYPE, WIDTH, THICKNESS
 7. LAVERE TYPE, DIAM., LENGTH
 WATER MAIN SIZE, LOCATION
 SAN. SEWER SIZE, GRADE, LOCATION
 SAN. M.H. CAST. ELEV., INV. ELEV.
 SAN. CONN. SIZE, GRADE, LOCATION
 STORM SEWER SIZE, GRADE, LOCATION
 STORM M.H. CAST. ELEV., INV. ELEV.
 PAVT. TYPE, LOG. CURBS
 GAS LINE, LOG. SIZE
 SEPTIC SYSTEM & DUCTIFICATION
 WELL LOCATION & DUCTIFICATION RADIUS

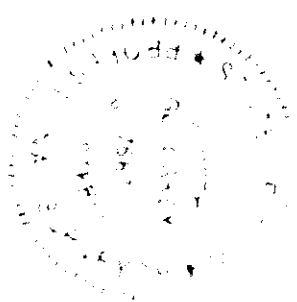

STATE SEAL

DESIGN CERTIFICATION

DESIGN CERTIFICATION
THIS PLAT WAS PREPARED BY ME, AND IS CORRECT
TO THE BEST OF MY KNOWLEDGE.
John R. [Signature]

~~NAME~~

DATE _____

"AS-BUILT" CERTIFICATION

AS- DOWD
I HEREBY CERTIFY THAT THE CIRCLED INFORMATION IS EXISTING
AS OBTAINED ON THE SITE 19 AND IS
CORRECT TO THE BEST OF MY KNOWLEDGE AND BELIEF.

NAME		SCALE
DRAWN BY	M.D.	1" = 20'
CHECKED BY	DATE	
REV.	16	3-95
REV.		
REV.		

BENCHMARK: AS-BUILT STM. M.H.
RIM ELEV. 6974.55


* DRIVE APRON AND WALK @ APRON SHALL BE 6" THICK CONCRETE.

2 WORKING DAYS BEFORE YOU DIG
CALL TOLL FREE 800-362-2764
OHIO UTILITIES PROTECTION SERVICE

APPROVED
PAINTSVILLE TOWNSHIP
TOWN CLERK

95-04-01 Rhuot
PAINESVILLE TOWNSHIP
ZONING DEPARTMENT

CONTRACT NO.
95-644-23

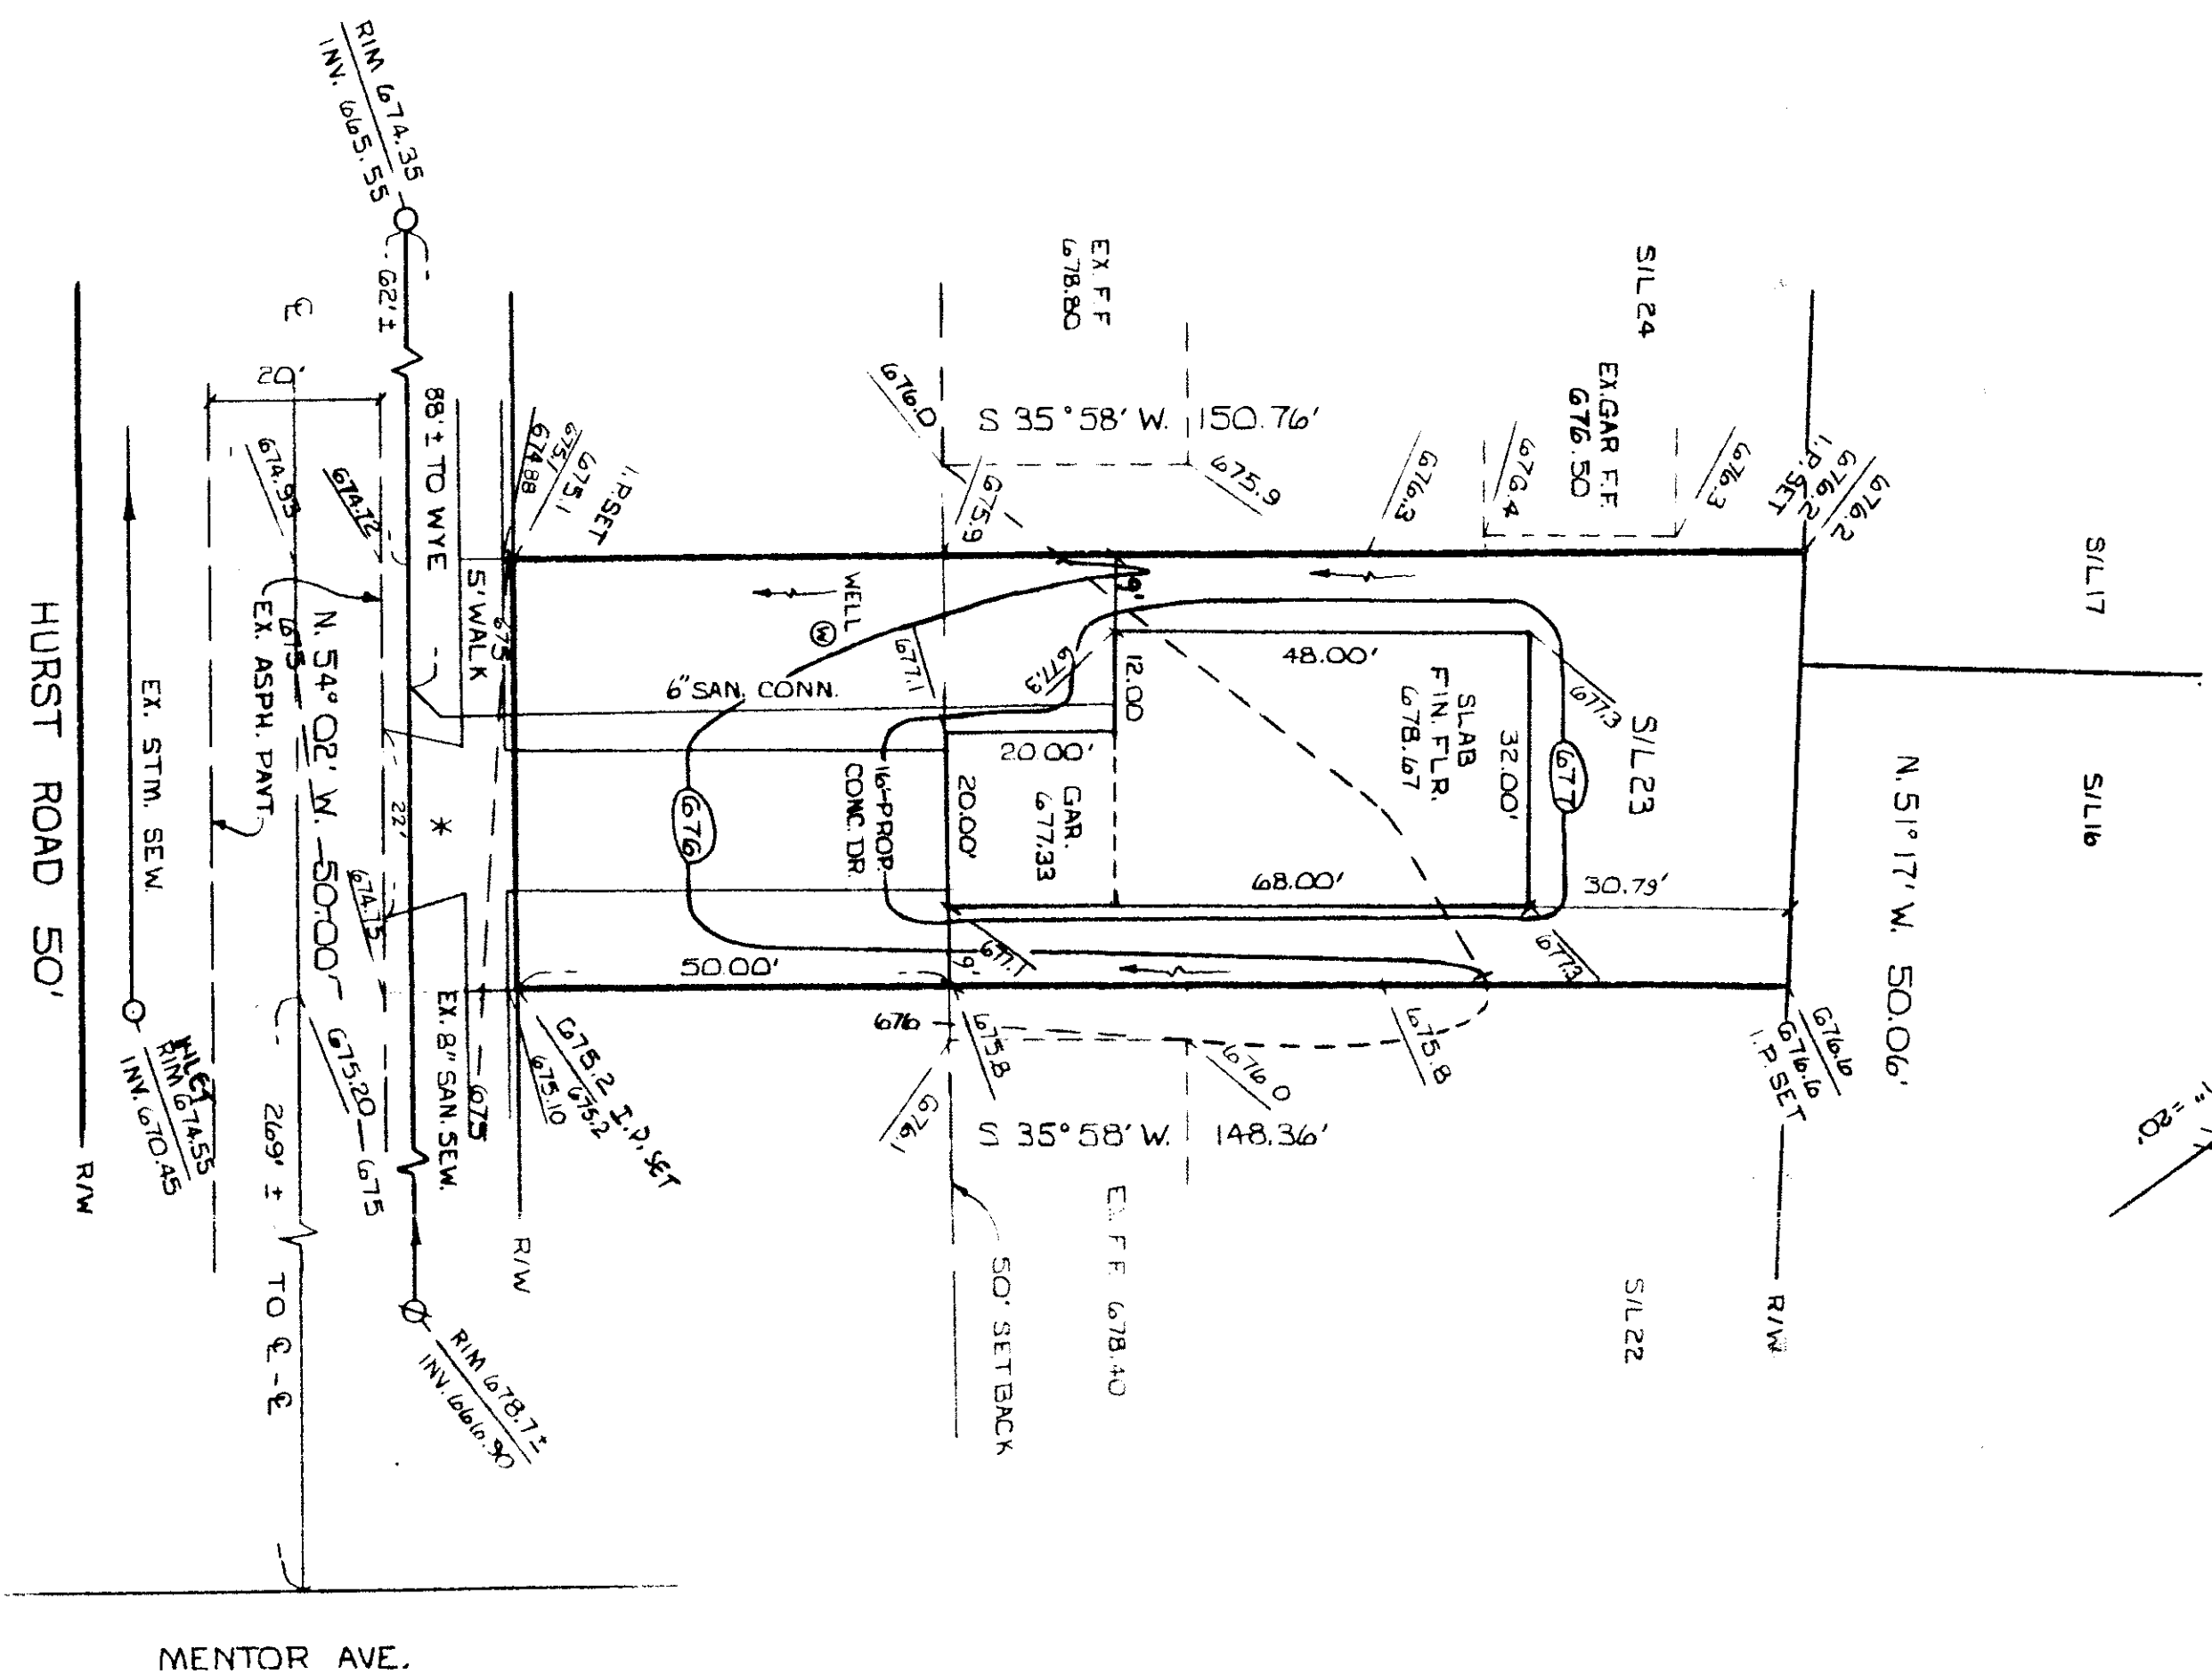

MENTOR AVE.

65H 4695
lower Ell's Cove Foot