


Jackson

Street

60'

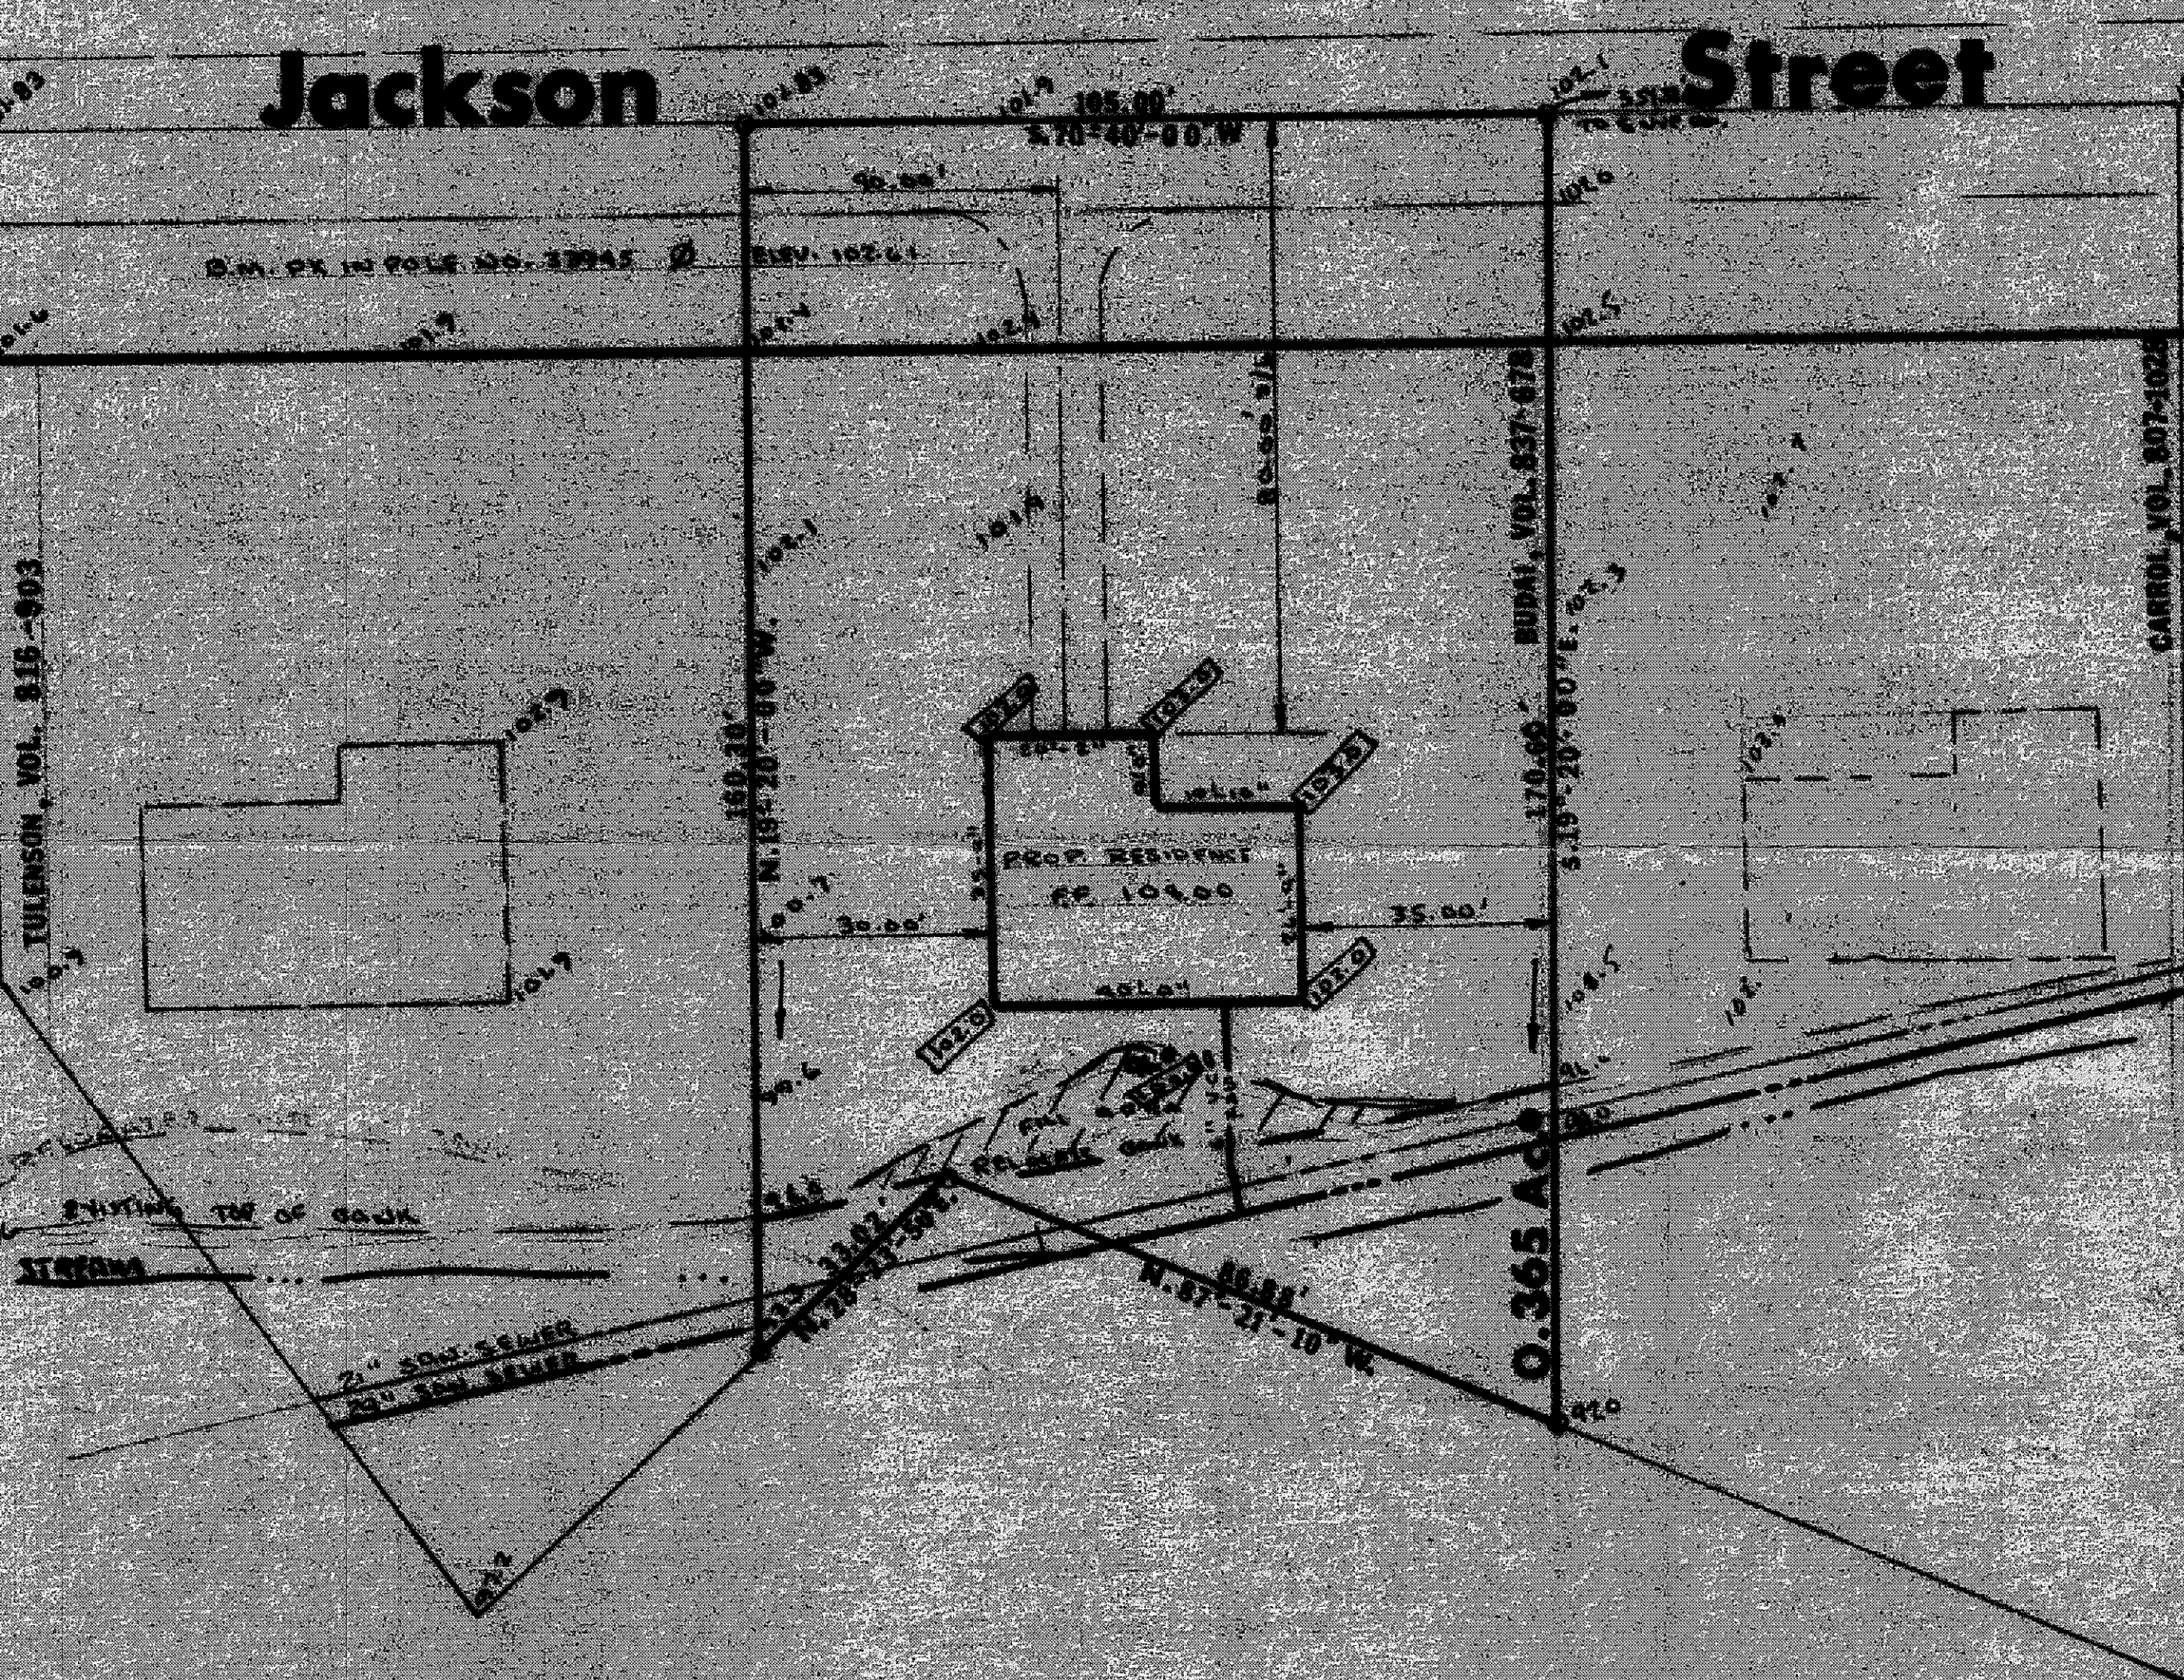

PAINESVILLE TWP.
ZONING APPROVAL
#4366 9-20-78
Thomas P. Gilles
Zoning Inspector

Grading Plan Approved
as shown and/or noted
THOMAS P. GILLES, P.E.
Lake County Engineer

Grading Plan Approved
as shown and/or noted
THOMAS P. GILLES, P.E.
Lake County Engineer

By *T. P. Gilles* Date *20/1/78*

I HEREBY CERTIFY THAT I HAVE PREPARED THIS SITE PLAN, AND THAT THE BEARINGS,
DISTANCES, LOCATION OF PROPERTY LINES, AND OTHER PARTICULARS SHOWN ARE CORRECT.

DATE: *9/1/78*
Robert J. Adams
ROBERT J. ADAMS, P.E.
REGISTERED CIVIL ENGINEER AND LAND SURVEYOR

BUDAI SITE PLAN

SCALE: 1:20	APPROVED BY:	DRAWN BY:
DATE: 3/17/78		REVISED:
PAINESVILLE TWP : LAKE COUNTY, OHIO		
PP 11A-151-1		DRAWING NO.

EXIST. GR 100.0
PROP. GR 100.0