
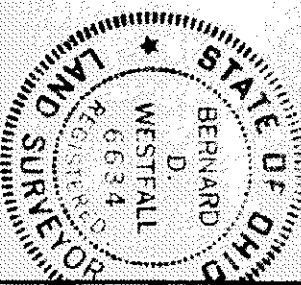


R=125.00'
Δ=24°-16'-38"
C=52.57'
N-43°-13'-43"-E
A=52.96'

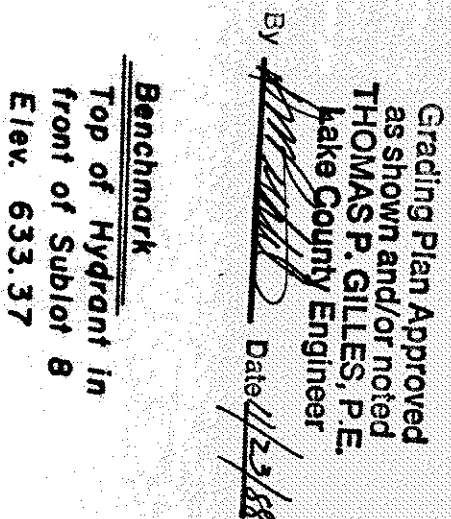

PAINESVILLE, LAKE COUNTY, OHIO

P.O. BOX 164 MENTOR 44061
ADDRESS STREET CITY ZIP

LOT	TRACT
VOLUME	PAGE
PENAL PAGE NO.	TRIPLET

SANITARY	MANHOLE	WATER VALVE (GAS)	_____
STORM	MANHOLE	WATER METER (GAS)	_____
INLET OR CATCH BASIN	_____	AS BUILT ELEVATION	_____
HYDRANT	_____		
EXISTING CONTOURS	_____		
PROPOSED CONTOURS	_____		
EXIST. ELEV.	100.0		
	100.0		
	PROP. FLEV.		

INDICATES DIRECTION OF SURFACE DRAINAGE

100'

ALL BOUNDARY DATA SHOWN WAS OBTAINED FROM IDEBS, RECORDED SUBDIVISION PLAT OR OTHER PUBLIC RECORDS.

LOCATIONS AS SHOWN OF ADJACENT WELLS AND SEPTIC TANKS OBTAINED FROM LAKE COUNTY HEALTH DEPARTMENT.

THIS PLAT WAS PREPARED BY ME, AND IS CORRECT
TO THE BEST OF MY KNOWLEDGE AND BELIEF.

NAME	SURVEYOR	REGISTRATION
Kennard, D. L.	D. L.	6634

NAME	SURVEYOR	REGISTRATION	NO.

NO. OF BEDROOMS	WATER MAIN SIZE	LOCATION
DIMENSIONS	BAY SEWER SIZE	% GR. LOC.
BEARINGS	SAN. INV. CAST ELEV.	INV. ELEV.
TIE TO NEAREST STREET	SAN. CONN. SIZE	LOC. DPTH.
SUBLOT NO. PARCEL NO.	STORM SEWER SIZE	% GR. LOC.
SURROUNDING OWNERS	STORM INV. CAST ELEV.	INV. ELEV.
BLDG. DIMENSIONS FIN. GR.	PAV'T TYPE	GRADE CURBS
BLDG. TIES F.L.R. GRADERS	BASE LINE LOC.	SIZE PRESSURE
COMMON TYPE WIDTH THICKNESS	SEPTIC TANK LOCATION	AND DUFF/CAT
SHOWER TYPE WIDTH THICKNESS	WELL LOCATION	
ROCK OUTCROPPINGS	ISOLATION RADIIUS FROM WELL	

REVISIONS			PLAN PREPARED BY:		
NO.	DATE	BY			
1			WESTFALL & ASSOCIATES 228 N. Chestnut St. Jefferson, OH		
2					
3					
4					
5					
DRAWN BY FDS			SCALE 1" = 20'	PHONE NO. 576-5500	
CHKD.			DATE 11-21-88	DRAWING NO.	
CNEW CHIEF			APPD.		
AJW					

I, HEREBY CERTIFY THAT THE CIRCLED GRADES ARE EXISTING IN THE
FINISH GRADES CHECKED IN THE FIELD ON _____, 19____
AND ARE CORRECT TO THE BEST OF MY KNOWLEDGE AND BELIEF.

REG. NO.

This Permit Expires
11-23-89

PAINESVILLE TOWNSHIP
ZONING APPROVED
2136

7128

~~Zamir Zingir~~