



KENILWORTH AVENUE (50')

N-89°-21'-36"-W 65.00'

15' ST.M. SEW

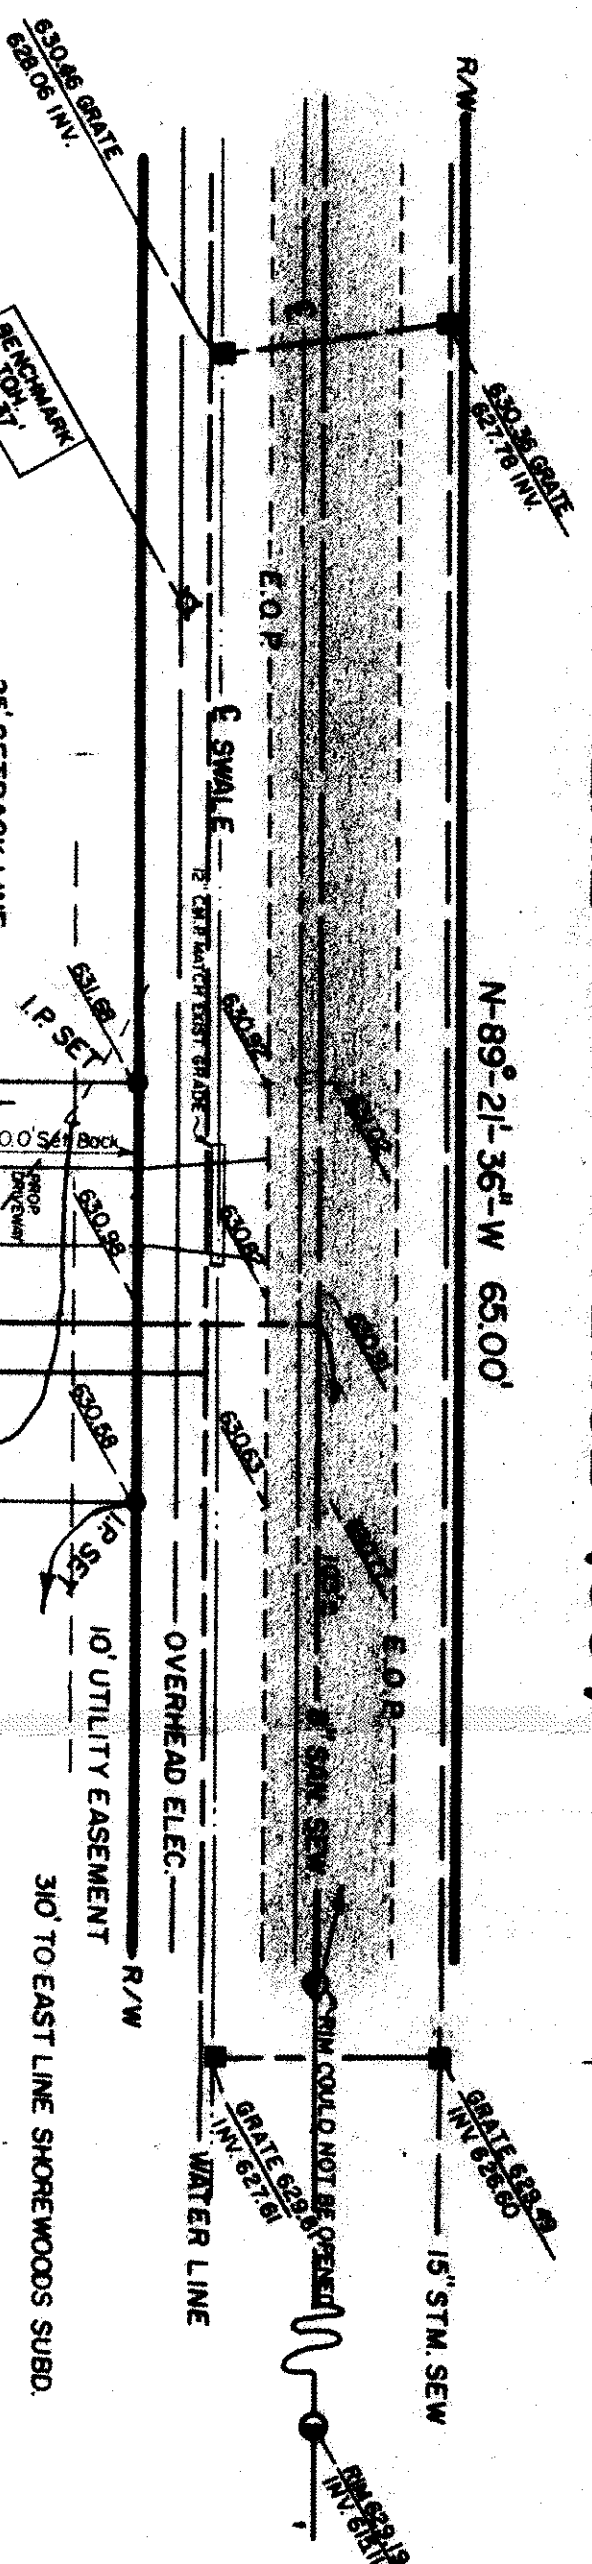

Grading Plan Approved
as shown and/or noted
THOMAS P. GILLES, P.E.
Lake County Engineer
By *[Signature]* Date 3.2.84

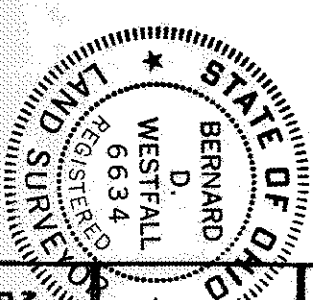

SITE PLAN

PAINESVILLE TOWNSHIP LAKE COUNTY, OHIO

for: JEFF OROZ

26 STYCAMORE DR. PAINESVILLE 44077
ADDRESS CITY ZIP

SHOREWOODS		LOT	
SUBDIVISION	6-27	NAME	TRACT
VOL. NO.	6	VOLUME	PAGE
SUBLOT NO.	6	PERM. PARCEL NO.	STREET

LEGEND

SANITARY MANHOLE	WATER VALVE (GAS)
STORM MANHOLE	WATER METER (GAS)
INLET OR CATCH BASIN	AS BUILT ELEVATION
HYDRANT	INDICATES DIRECTION OF SURFACE DRAINAGE
EXISTING CONTOURS	
PROPOSED CONTOURS	
EXIST. ELEV.	100.0
PROP. ELEV.	100.0

REMARKS

ALL BOUNDARY DATA SHOWN WAS OBTAINED FROM (IDEAS, RECORDED SUBDIVISION PLAT OR OTHER PUBLIC RECORDS)
LOCATIONS AS SHOWN OF ADJACENT WELLS AND SEPTIC TANKS OBTAINED FROM LAKE COUNTY HEALTH DEPARTMENT

DESIGN CERTIFICATION

THIS PLAT WAS PREPARED BY ME, AND IS CORRECT TO THE BEST OF MY KNOWLEDGE AND BELIEF.
NAME *Thomas P. Gilles* SURVEYOR REGISTRATION NO. 6634

CHECK LIST

NO. OF BEDROOMS		WATER MAIN SIZE, LOCATION	
1	DATE	BY	SCALE
2			
3			
4			
5			

PLAN PREPARED BY:

ATERRA Engineering & Surveying Inc.
170 NO. ST. CLAIR PAINESVILLE, OHIO

NO.	DATE	BY	SCALE	PHONE NO.
1			1" = 30'	352-9250
2				
3				
4				
5				

"AS BUILT" CERTIFICATION

I, HEREBY CERTIFY THAT THE CIRCLED GRADES ARE EXISTING FINISH GRADES CHECKED IN THE FIELD ON 19 19
AND ARE CORRECT TO THE BEST OF MY KNOWLEDGE AND BELIEF.

REGISTERED SURVEYOR REG. NO.

This Permit Expires
2-24-89

PAINESVILLE TOWNSHIP
ZONING APPROVED

6875
[Signature]
Zoning Inspector 2/24/89