
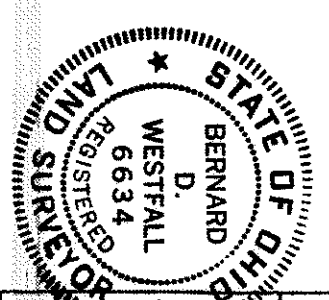
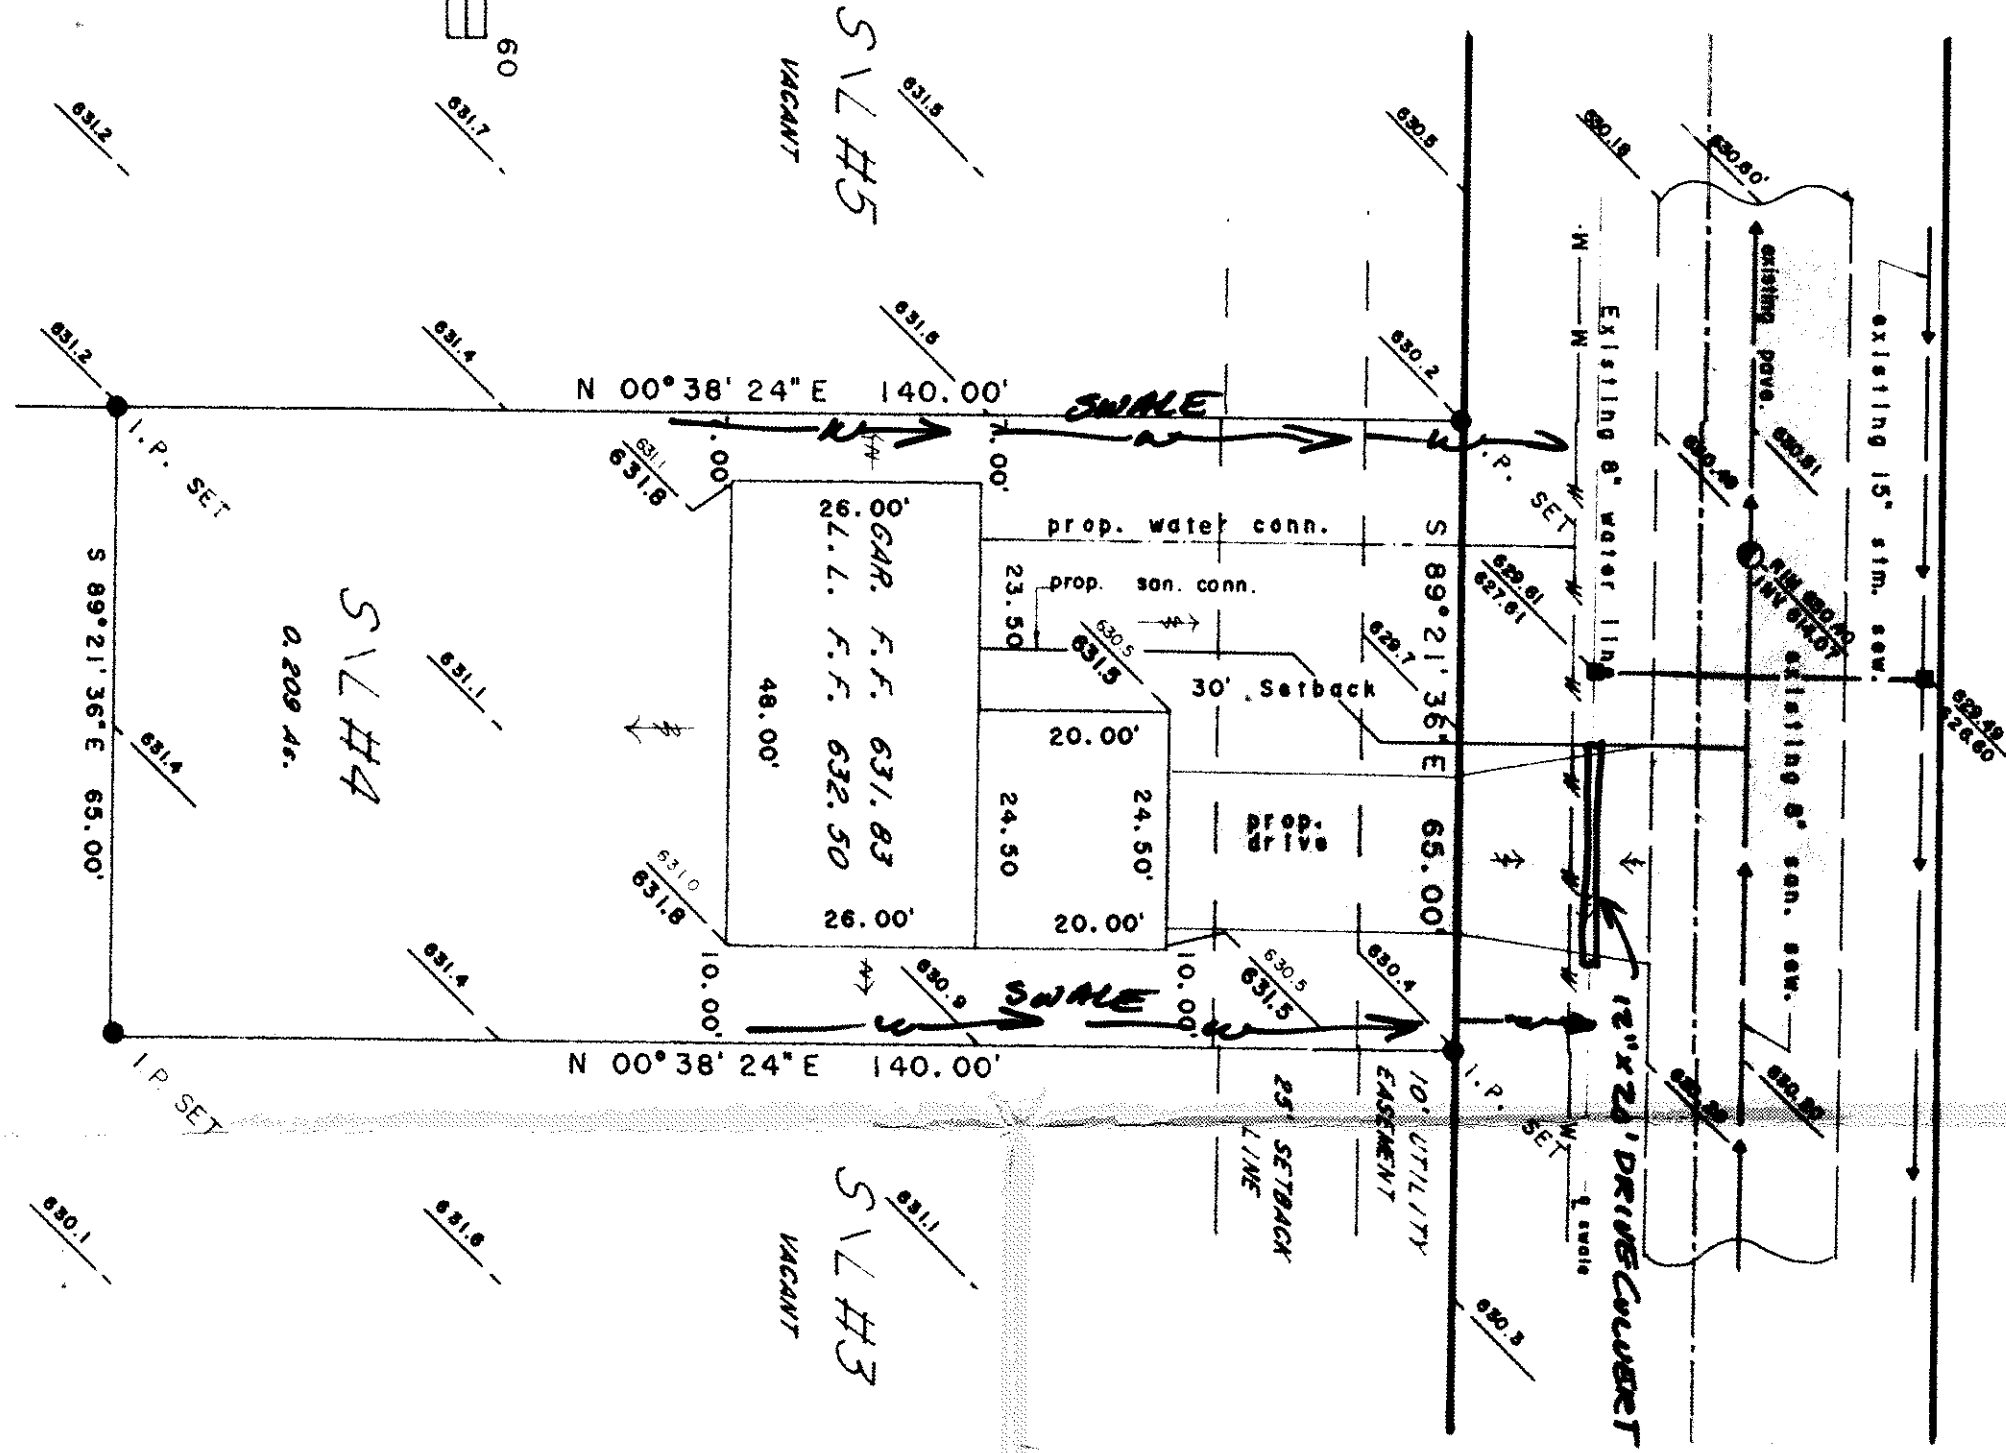
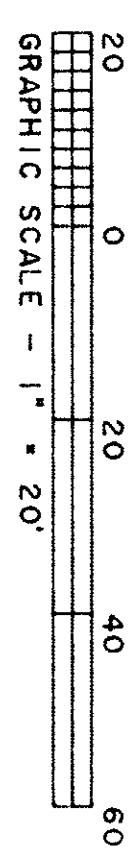


Grading Plan Approved
as shown and/or noted
THOMAS P. GILLES, P.E.
Lake County Engineer
By *Thomas P. Gilles* Date *5/5/89*

KENILWORTH AVE. 50'

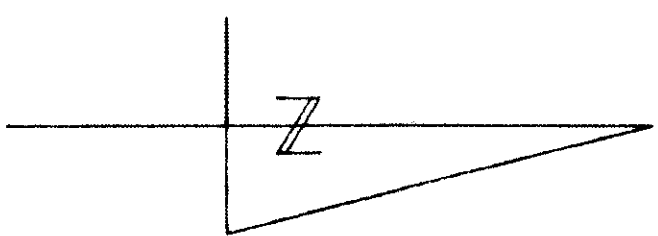

SITE PLAN

TOWNSHIP OF PAINESVILLE LAKE COUNTY, OHIO

FOR: JEFF OROSH

32 SYCAMORE ST., PAINESVILLE, OHIO

SHOREWOODS Vol. 6-Pg. 27	TOT	TRACT
SUBDIVISION NAME	VOLUME	PAGE
4 KENILWORTH STREET	P.D. #	STREET

SANITARY M.H.	LEGEND
STROM M.H.	WATER LINE — W —
INLET-CATCH BASIN	GAS LINE — G —
HYDRANT	EXIST. ELEV. 100.0
EXIST. CONTOURS	PROP. ELEV. 100.0
PROP. CONTOURS	100.0

REMARKS
All boundary data was obtained from (deeds, recorded subdivision plat or other public records.)

DESIGN CERTIFICATION

This plat was prepared by me, & is correct to the best of my knowledge and belief.

NAME *Bernard D. Westfall, P.S.* Ohio No. *6634*
OHIO REG. SURVEYOR #

REVISIONS	PLAN PREPARED BY:
No. date by	<i>A. TERRA</i>
1	ENGINEERING & SURVEYING
2	170 N. ST. CLAIR, PAINESVILLE
3	2 EAST JEFFERSON, JEFFERSON
4	DRAWN BY: SCALE: 1"=20'
5	DATE 4-88
	CREW CHIEF: E.W./G.N./A.W.
	JOB NO. # 86002300

1) All iron pins set & identified by a plastic cap (A TERRA 6634)
2) Benchmark top of hydrant @ the N.W. corner of S/L #7, ELEV. 633.37

This Permit Expires
5-3-89
PAINESVILLE TOWNSHIP
ZONING APPROVED
6947
William E. McArthur
Zoning Inspector 5/3/88