


EXISTING STORM SEWER
TO BE CUT AND STRUCTURE
TO BE CENTERED ON
INTERSECTION OF PIPE
CENTRALLINES.

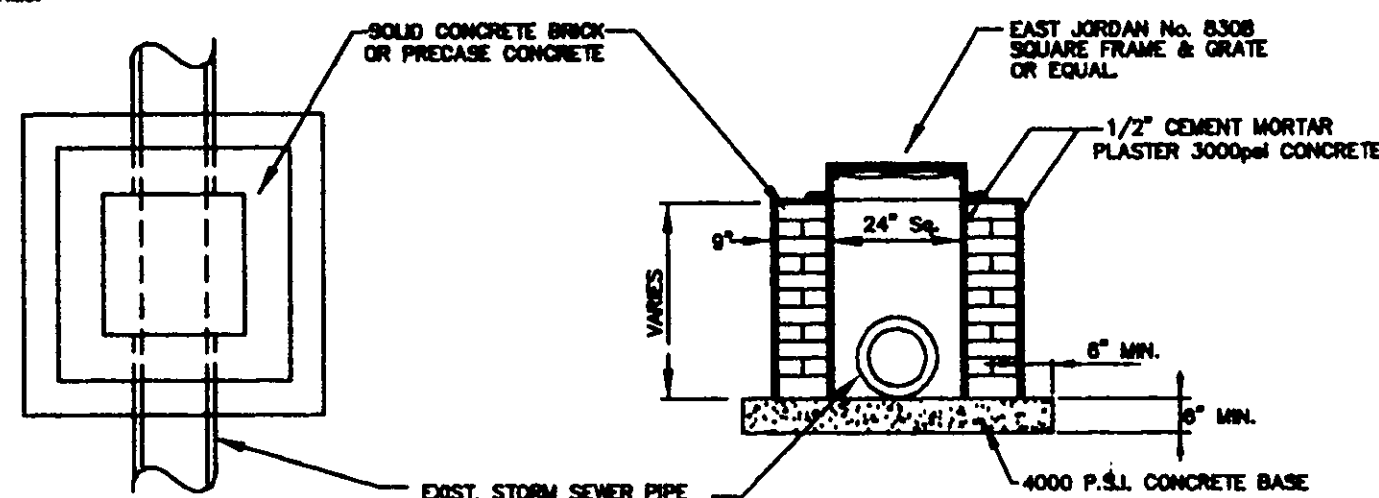

PLAN VIEW

SECTION A-A

DITCH INLET BASIN

GRAPHIC SCALE




(IN FEET)
1 inch = 20 ft.

Basis of Bearings is the Subdivision
Plat of Shorewoods Subdivision Phase No.1


NOTES: DRIVE APRON AND SIDEWALK
APRON TO BE 6" THICK CONCRETE;

- 4" CONC. WALK TO BE 4" THICK
- DOWNSPOUTS TO BE OUTLETED
TO SPLASHBLOCKS

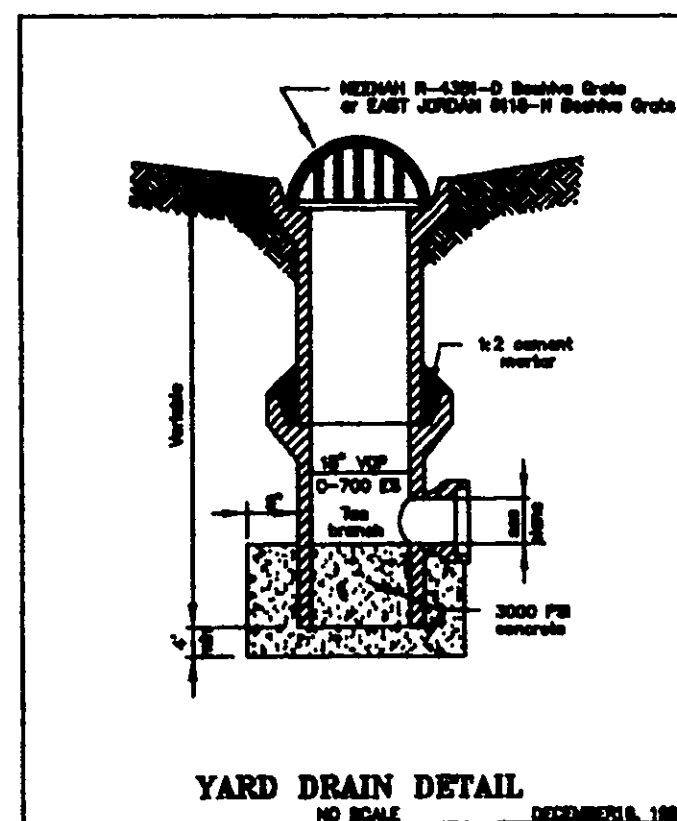

YARD DRAIN DETAIL
NO SCALE

Proposed
Yard Drain
w/Silt Fence
Rim 629.50
Inv 627.40

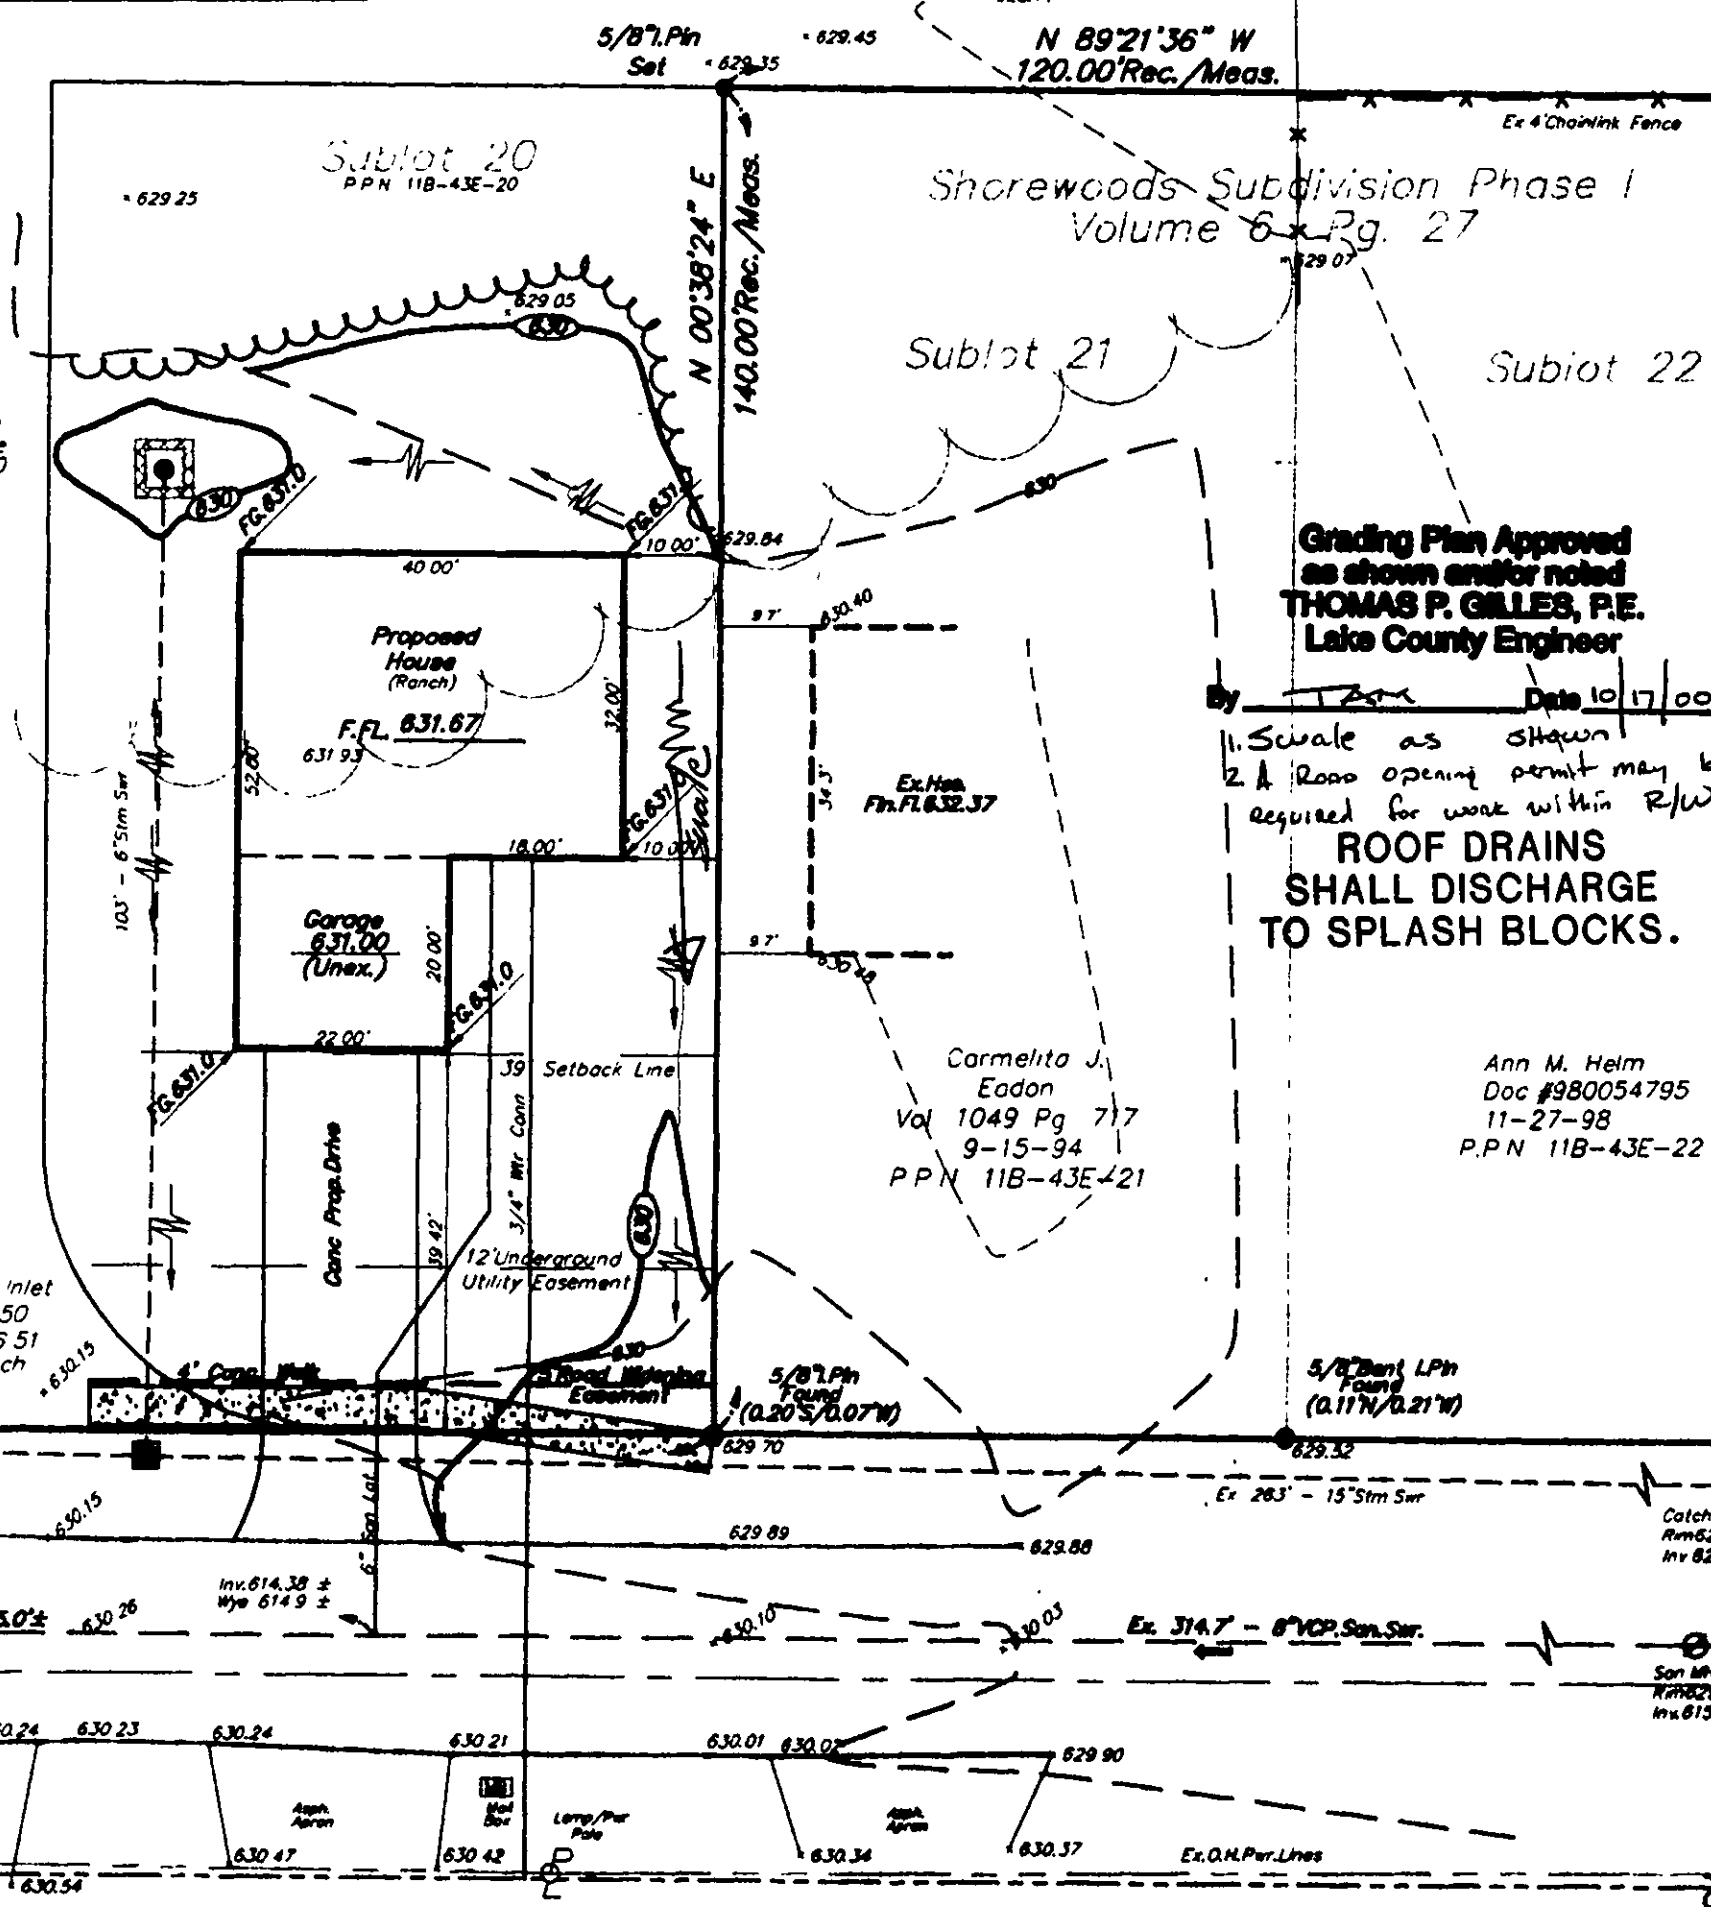


Grading Plan Approved
as shown and/or noted
THOMAS P. GILLES, P.E.
Lake County Engineer

By T.P. Gilles Date 10/17/00
1. Scale as shown
2. A road opening permit may be
required for work within R/W
**ROOF DRAINS
SHALL DISCHARGE
TO SPLASH BLOCKS.**

Ann M. Helm
Doc #980054795
11-27-98
P.P.N 11B-43E-22

5/8\"/>

N 89°21'36\"/>

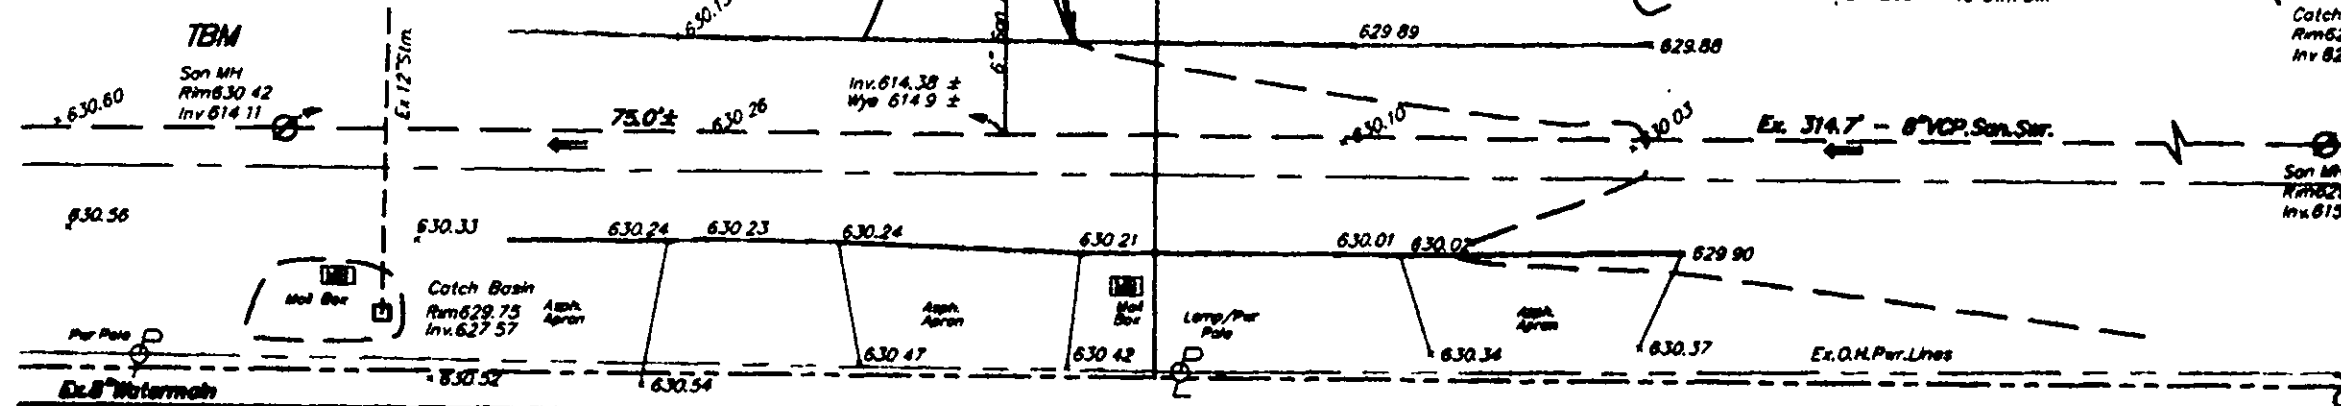

EXISTING UNDERGROUND UTILITIES NOTE:
THE SIZE & LOCATION, BOTH HORIZONTAL AND VERTICAL,
OF THE UNDERGROUND UTILITIES SHOWN HEREON, HAVE BEEN
OBTAINED BY A SEARCH OF AVAILABLE RECORDS.
VERIFICATION BY FIELD OBSERVATION HAS BEEN CONDUCTED
WHERE PRACTICAL. HOWEVER, LDC INC. DOES NOT
GUARANTEE THE COMPLETENESS NOR ACCURACY THEREOF.

Kenilworth Avenue 50'

SITE PLAN

for : Lake County Community Development
CLIENT

101 Carmody Drive Painesville
ADDRESS STREET CITY

20 Shorewoods Subd. Ph.1 6 27
SUBLOT No. SUBDIVISION NAME VOL. PAGE
Painesville Twp. OHIO

LDC Inc. d.b.a. **LAND DESIGN consultants**
Civil Engineers and Surveyors
8085 EAST AVENUE - MENTOR, OHIO 44060
TELEPHONE 225-8463 354-6638 861-LAND


DESIGN CERTIFICATION

THIS PLAN WAS PREPARED BY ME, AND IS CORRECT TO THE
BEST OF MY KNOWLEDGE AND BELIEF.

James R. Pegoraro
NAME

CHECK LIST

LOT DIMENSIONS & BEARINGS
TO NEAREST STREET
SUBLOT NO. (PAGE NO.)
EXISTING UTILITIES
EXISTING BUILDINGS
EXISTING SETBACKS
EXISTING FENCES
EXISTING DRIVEWAYS
EXISTING SIDEWALKS
EXISTING CURBS
EXISTING LIGHTS
EXISTING SIGNAGE
EXISTING LANDSCAPE
EXISTING SURVEY DATA
EXISTING RECORDS
EXISTING ELEVATIONS
EXISTING SURFACE DRAINAGE
EXISTING WELL LOCATION & ISOLATION RADIUS

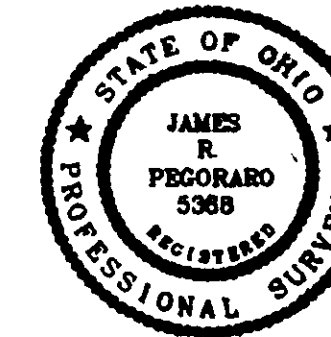

"AS BUILT" CERTIFICATION

I HEREBY CERTIFY THAT THE CIRCLED INFORMATION IS
EXISTING AS OBTAINED ON THE BEST SITE
20 AND IS CORRECT TO THE BEST OF MY KNOWLEDGE
AND BELIEF.

NAME

LEGEND

STORM MANHOLE
SANITARY MANHOLE
EXISTING CONTAINERS
PROPOSED CONTAINERS
DIRECTION OF
SURFACE DRAINAGE

DRAWN BY
Jrp/S'Plan1
SCALE
1"=20'
CHECKED BY
Rat
DATE
Sept. 2000
1 Rev. Per County 10/17/00
2

BENCHMARK

TEM: RIM OF SANITARY MANHOLE AS SHOWN
ELEVATION = 630.42

APPROVED
PAINESVILLE TOWNSHIP
ZONING DEPARTMENT
2000.327
W. Rust



Lakec2-9901