


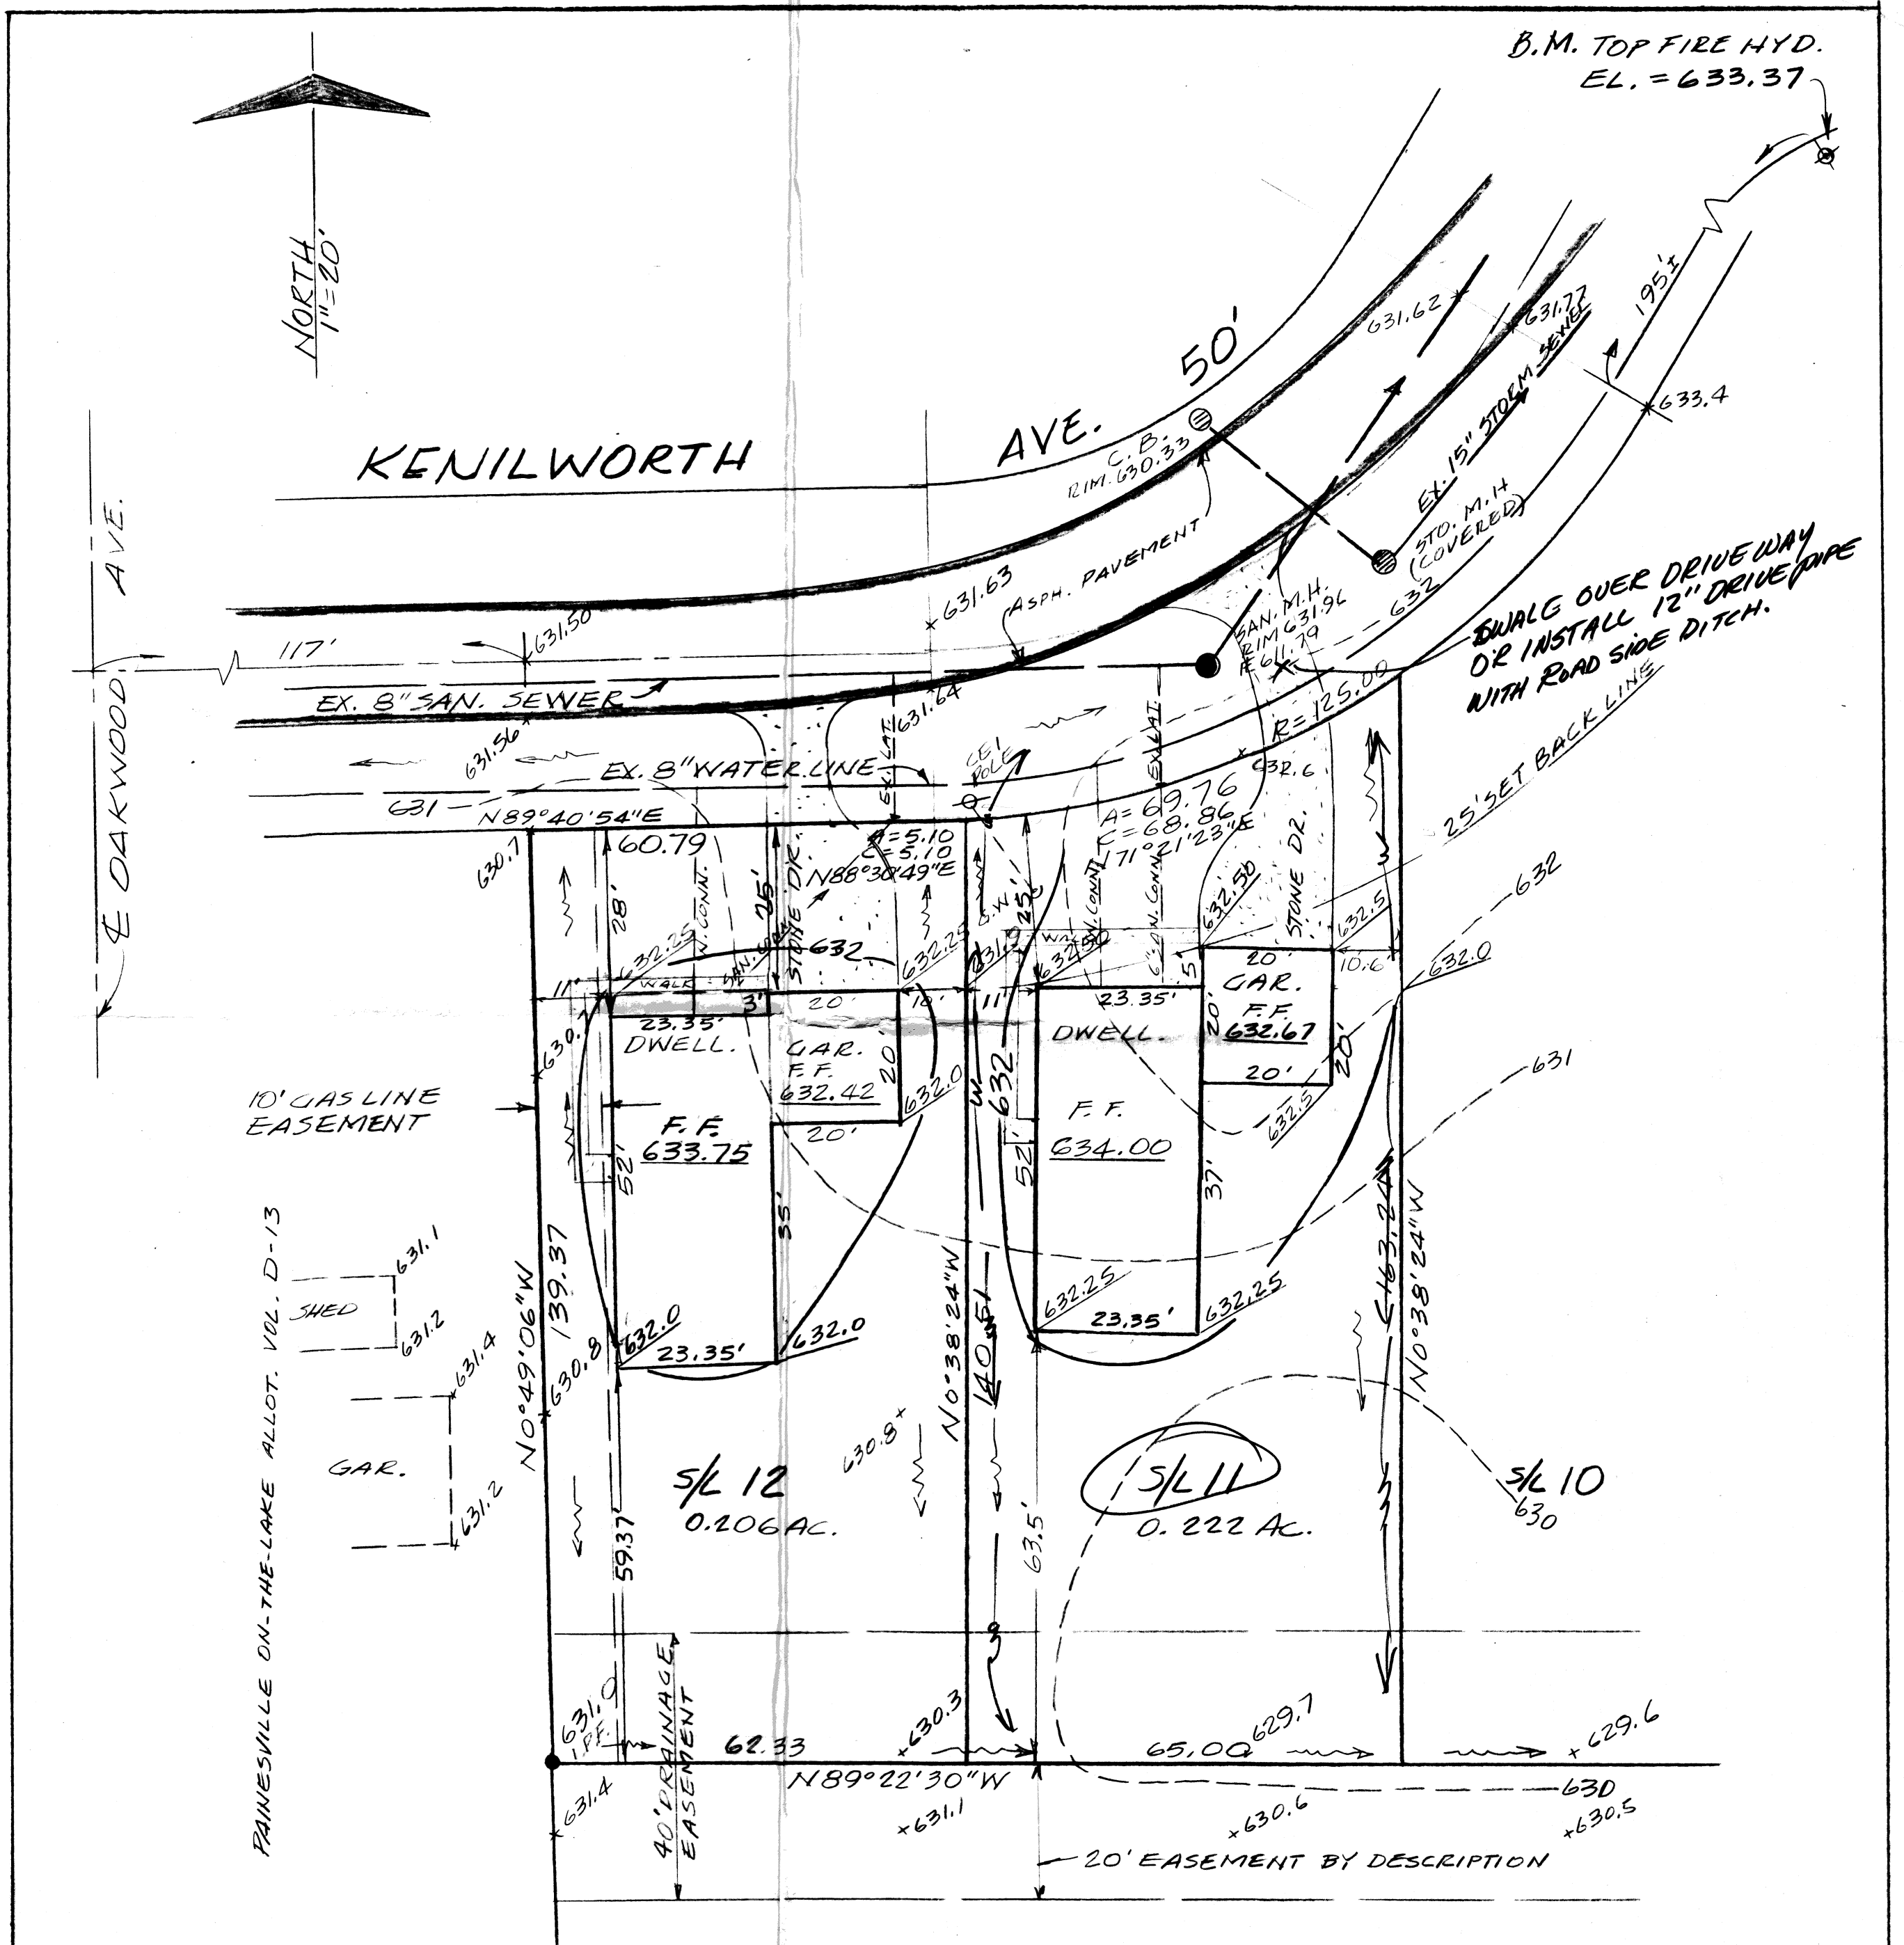

SITE PLAN OF S/L 10, 11, 12
SHOREWOOD SUBD. PHASE I
FOR
PAC-HOMES INC.
PAINESVILLE TOWNSHIP
LAKE COUNTY, OHIO
SCALE: 1"=20' MAY, 1987

DRILLEX INC. VOL. 63-315

This Permit Expires
5-27-88
PAINESVILLE TOWNSHIP
ZONING APPROVED
6700A
Willie E. Messinger
Inspector 5/27/87