

**SITE PLAN**

PAINESVILLE TOWNSHIP, LAKE COUNTY, OHIO

for: DERAL HARVEY 354-9238

CLIENT OWNER

ADDRESS STREET CITY ZIP

SUBSET POINT	NAME	LOT	TRACT
SUBDIVISION D-100			
Block 17	VOL. PG.	VOLUME	PAGE
118-430-146	118-430-146	118-430-146	118-430-146
SUBLOT NO.	STREET	PERM. PARCEL NO.	STREET

**LEGEND**

SANITARY MANHOLE	WATER VALVE (GAS)
STORM MANHOLE	WATER METER (GAS)
INLET OR CATCH BASIN	AS BUILT ELEVATION
HYDRANT	INDICATES
EXISTING CONTOURS	DIRECTION OF
PROPOSED CONTOURS	SURFACE DRAINAGE
EXIST. ELEV. 100.0	100.0
100.0	100.0
100.0	100.0

**REMARKS**

ALL BOUNDARY DATA SHOWN WAS OBTAINED FROM (DEEDS, RECORDED)  
SUBDIVISION PLAT OR OTHER PUBLIC RECORDS)  
LOCATIONS AS SHOWN OF ADJACENT WELLS AND SEPTIC TANKS OBTAINED FROM  
LAKE COUNTY HEALTH DEPARTMENT

**DESIGN CERTIFICATION**

THIS PLAT WAS PREPARED BY ME, AND IS CORRECT  
TO THE BEST OF MY KNOWLEDGE AND BELIEF

NAME SURVEYOR REGISTRATION NO.

**CHECK LIST**

NO. OF BEDROOMS	WATER MAIN SIZE, LOCATION
DIMENSIONS	SAN. SEWER SIZE, % GR. LOC.
BEARINGS	SAN. MH. CAST ELEV. INV. ELEV.
TIE TO NEAREST STREET	SAN. CONN. SIZE, % GR. LOC.
SUBLOT NO. PARCEL NO.	STORM SEWER SIZE, % GR. LOC.
SURROUNDING OWNERS	STORM MH. CAST ELEV. INV. ELEV.
BLDG. DIMENSIONS FIN. GR.	PART TYPE GRADE CURBS
BLOG. TIE FLTR. GRADES	GAS LINE LOC. SIZE PRESSURE
APPROX. TYPE WIDTH THICKNESS	SEPTIC TANK LOCATION & DUPLICATION AREA
SIDEWALK TYPE WIDTH THICKNESS	WELL LOCATION
CULVERT TYPE DIA. LENGTH	ISOLATION RADIUS FROM WELL
ROCK OUTCROPPINGS	

**PLAN PREPARED BY:**

BABCOCK • JONES & ASSOCIATES, INC.

PAINESVILLE, OHIO

NO.	DATE	BY	DRAWN BY	SCALE	PHONE NO.
1			HP	1" = 20'	357-1811
2			HP		
3			HP		
4			HP		
5			HP		


**"AS BUILT" CERTIFICATION**

I, HEREBY CERTIFY THAT THE CIRCLED GRADES ARE EXISTING  
FINISH GRADES CHECKED IN THE FIELD ON 19  
AND ARE CORRECT TO THE BEST OF MY KNOWLEDGE AND BELIEF.

REGISTERED SURVEYOR

REG. NO.

T.B.M. - T.S.F.H. - ELEV. - 630.80

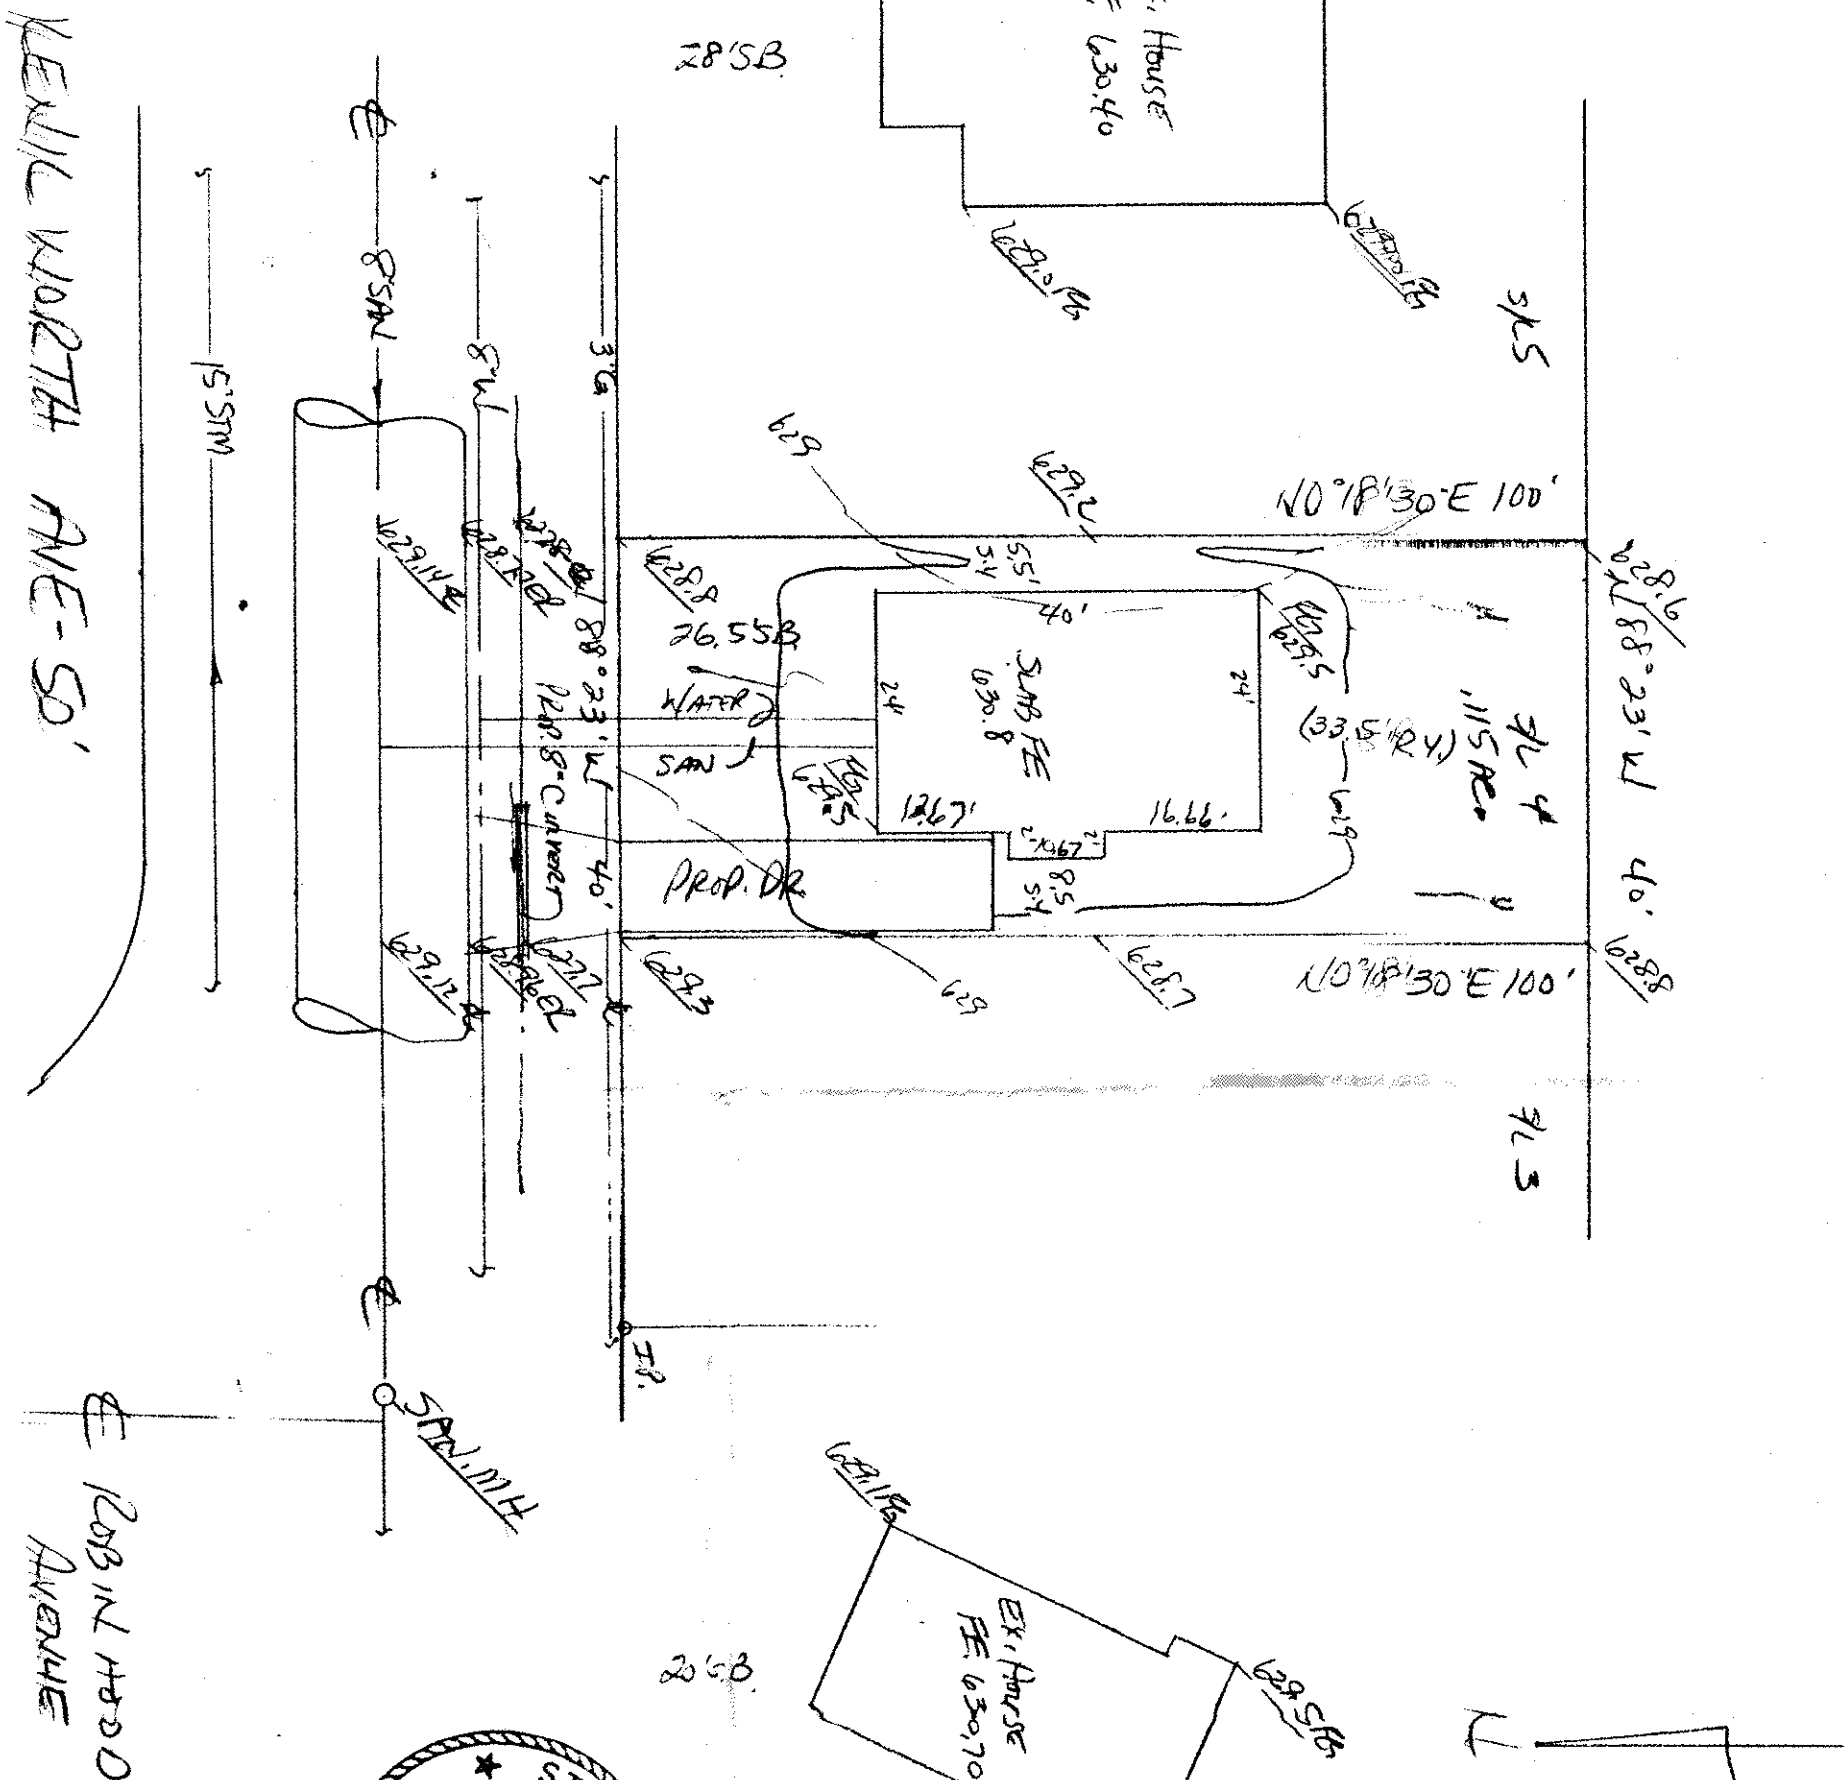

Grading Plan Approved  
as shown and/or noted  
THOMAS P. GILLES, P.E.  
Lake County Engineer

APPROVED  
PAINESVILLE TOWNSHIP  
ZONING DEPARTMENT  
#8703 JRG  
5/27/94

By 6 JH Date 6-3-94  
12" DRIVE CULVERT