


DESIGN CERTIFICATION
 THIS PLAT WAS PREPARED BY ME, AND IS CORRECT TO THE BEST OF MY KNOWLEDGE AND BELIEF.
[Signature]
 PS # 5244

AS BUILT CERTIFICATION
 I HEREBY CERTIFY THAT THE CIRCLED GRADES ARE EXISTING FINISH GRADES CHECKED IN THE FIELD ON SURVEY IS CORRECT TO THE BEST OF MY KNOWLEDGE AND BELIEF.
 REG. SURVEYOR NO. _____

COLPETZER • WOODS
 CONSULTANTS, INC.
 9470 MENTOR AVENUE • MENTOR, OHIO 44066 • (216) 357-7568

DATE: 4/23/82
 SCALE: 1" = 30'
 DRWN BY: [initials]
 CHKD BY: [initials]
 JOB NO: 82-118
 FB: 440 PG

SITE PLAN FOR:
J.W. BETTELEY BLDG CO., INC.
 BEING SUBLOT NO. 31 IN KINGSBOROUGH
 SUBD. NO. 1, IN PAINESVILLE TWP., OHIO.

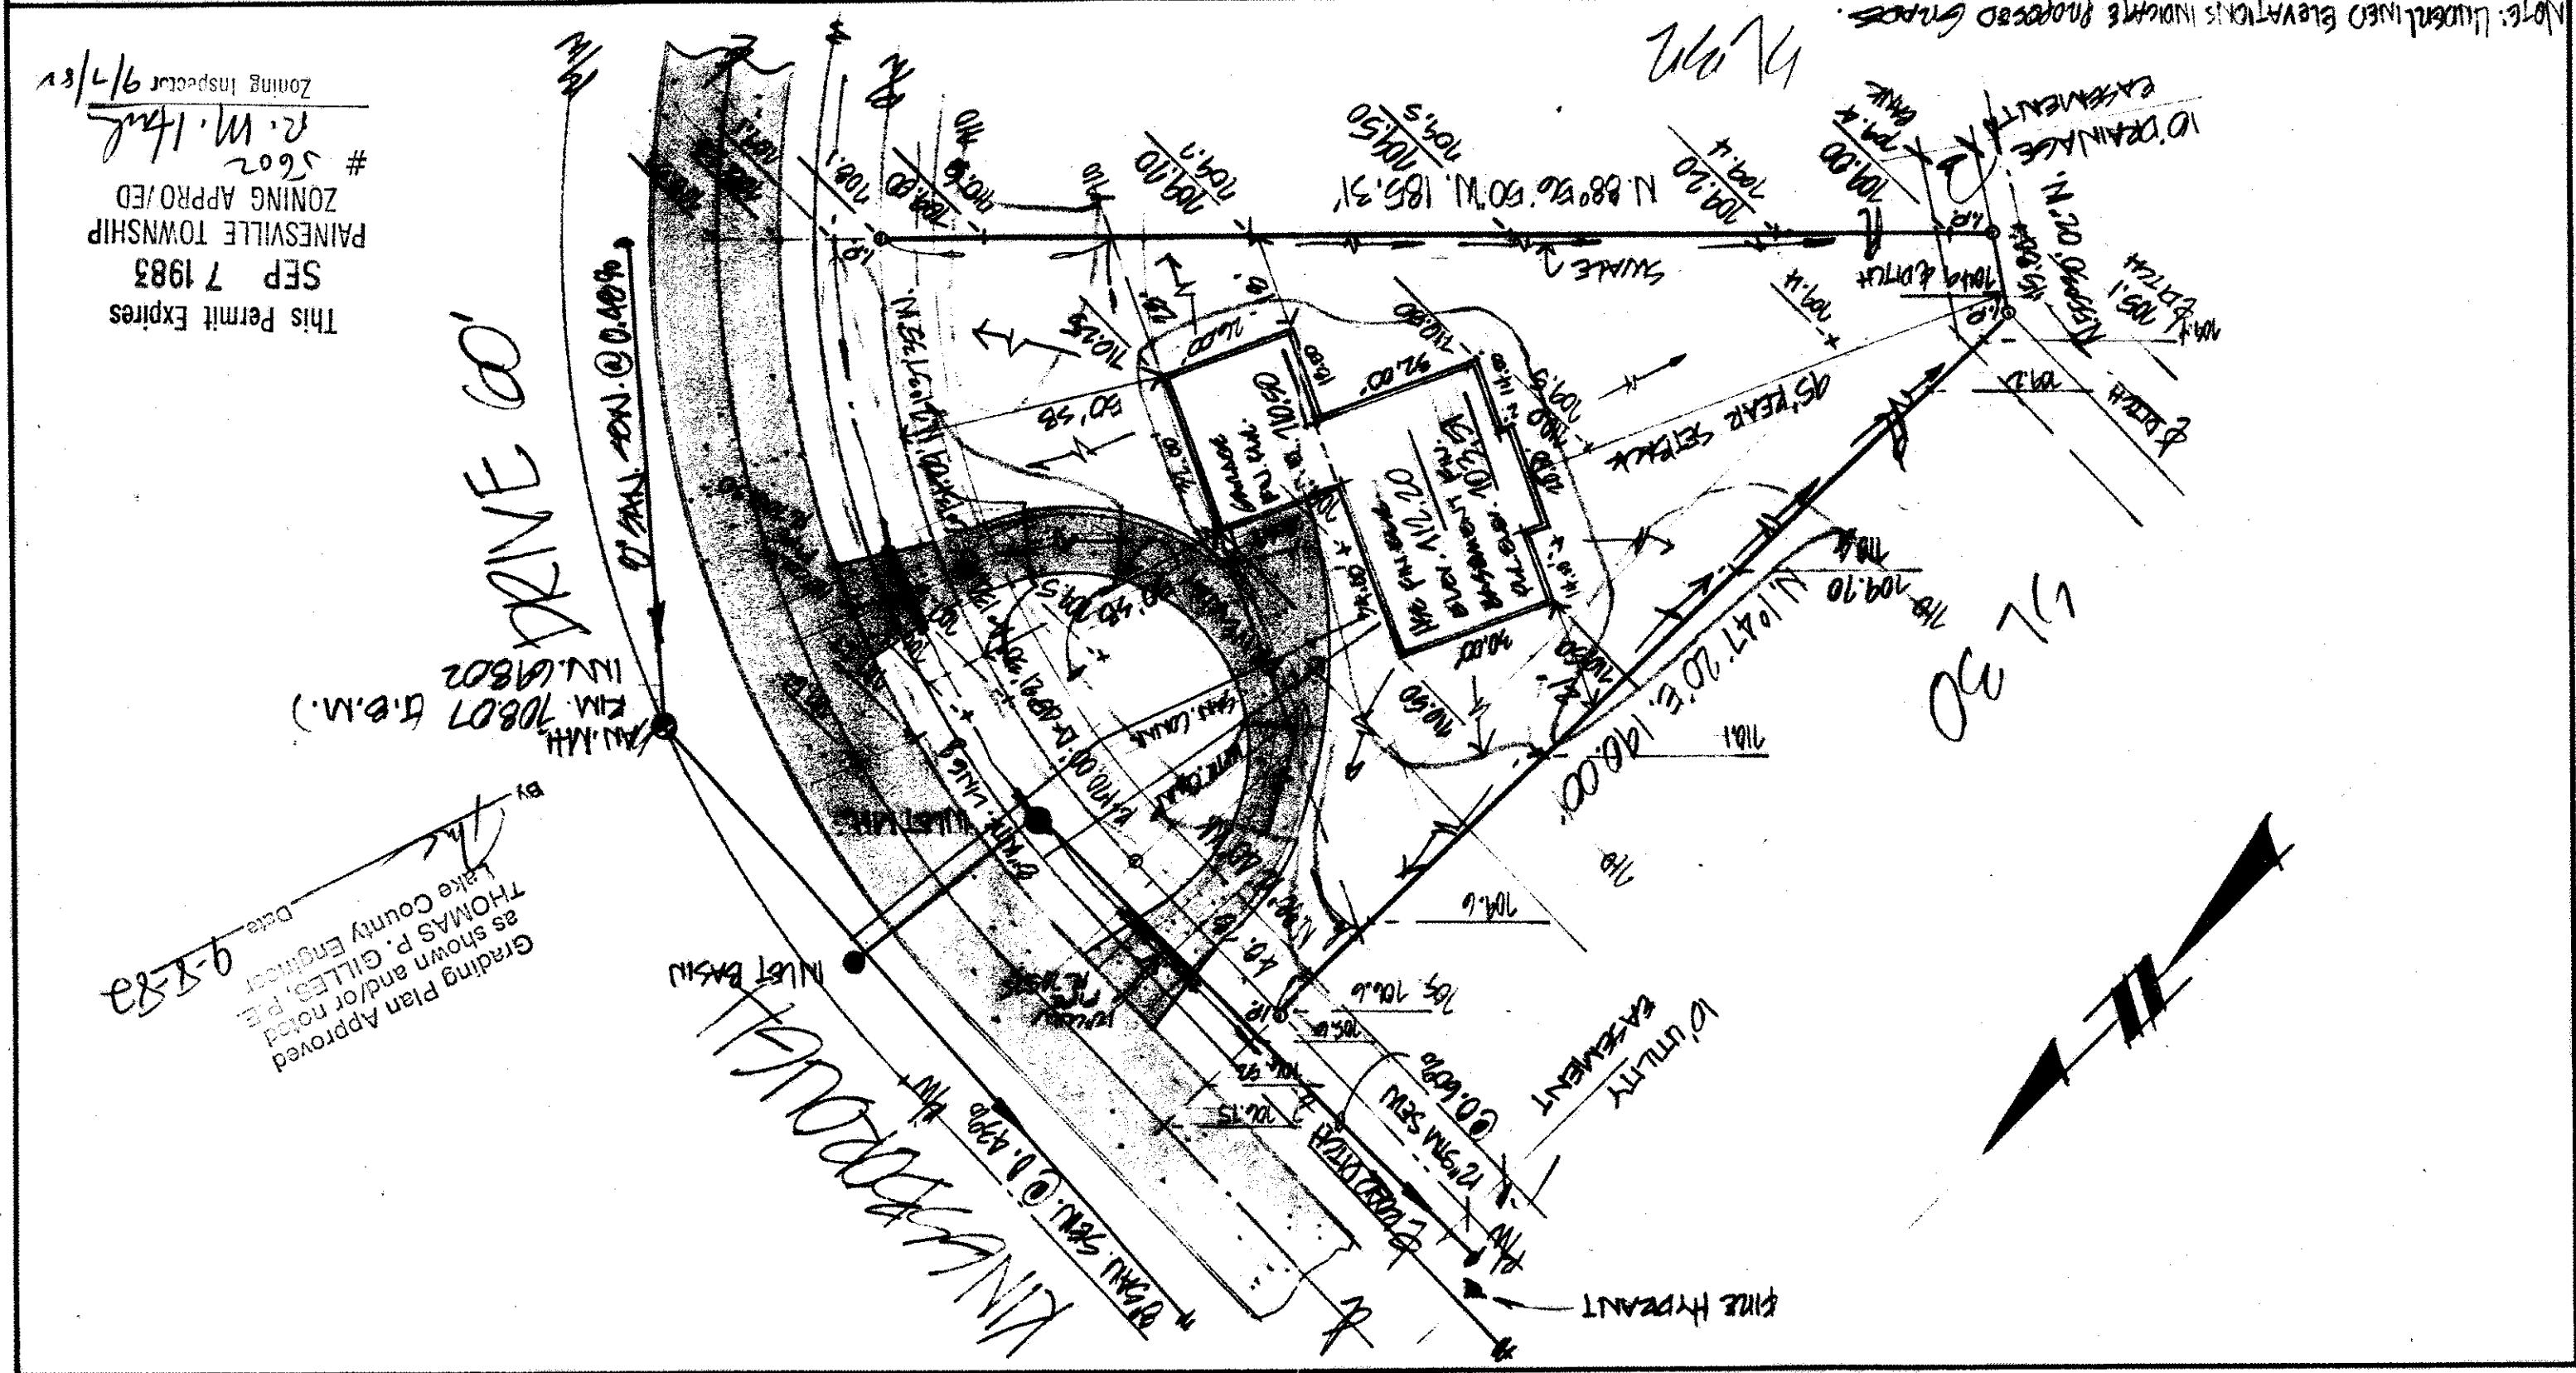

Grading Plan Approved
 as shown and/or noted
 THOMAS P. GILLES, P.E.
 Lake County Engineer
 Date: 9-8-82

This Permit Expires
 SEP 7 1983
 PAINESVILLE TOWNSHIP
 ZONING APPROVED
 # 5602
 R.M. 14th
 Zoning Inspector 9/7/82