


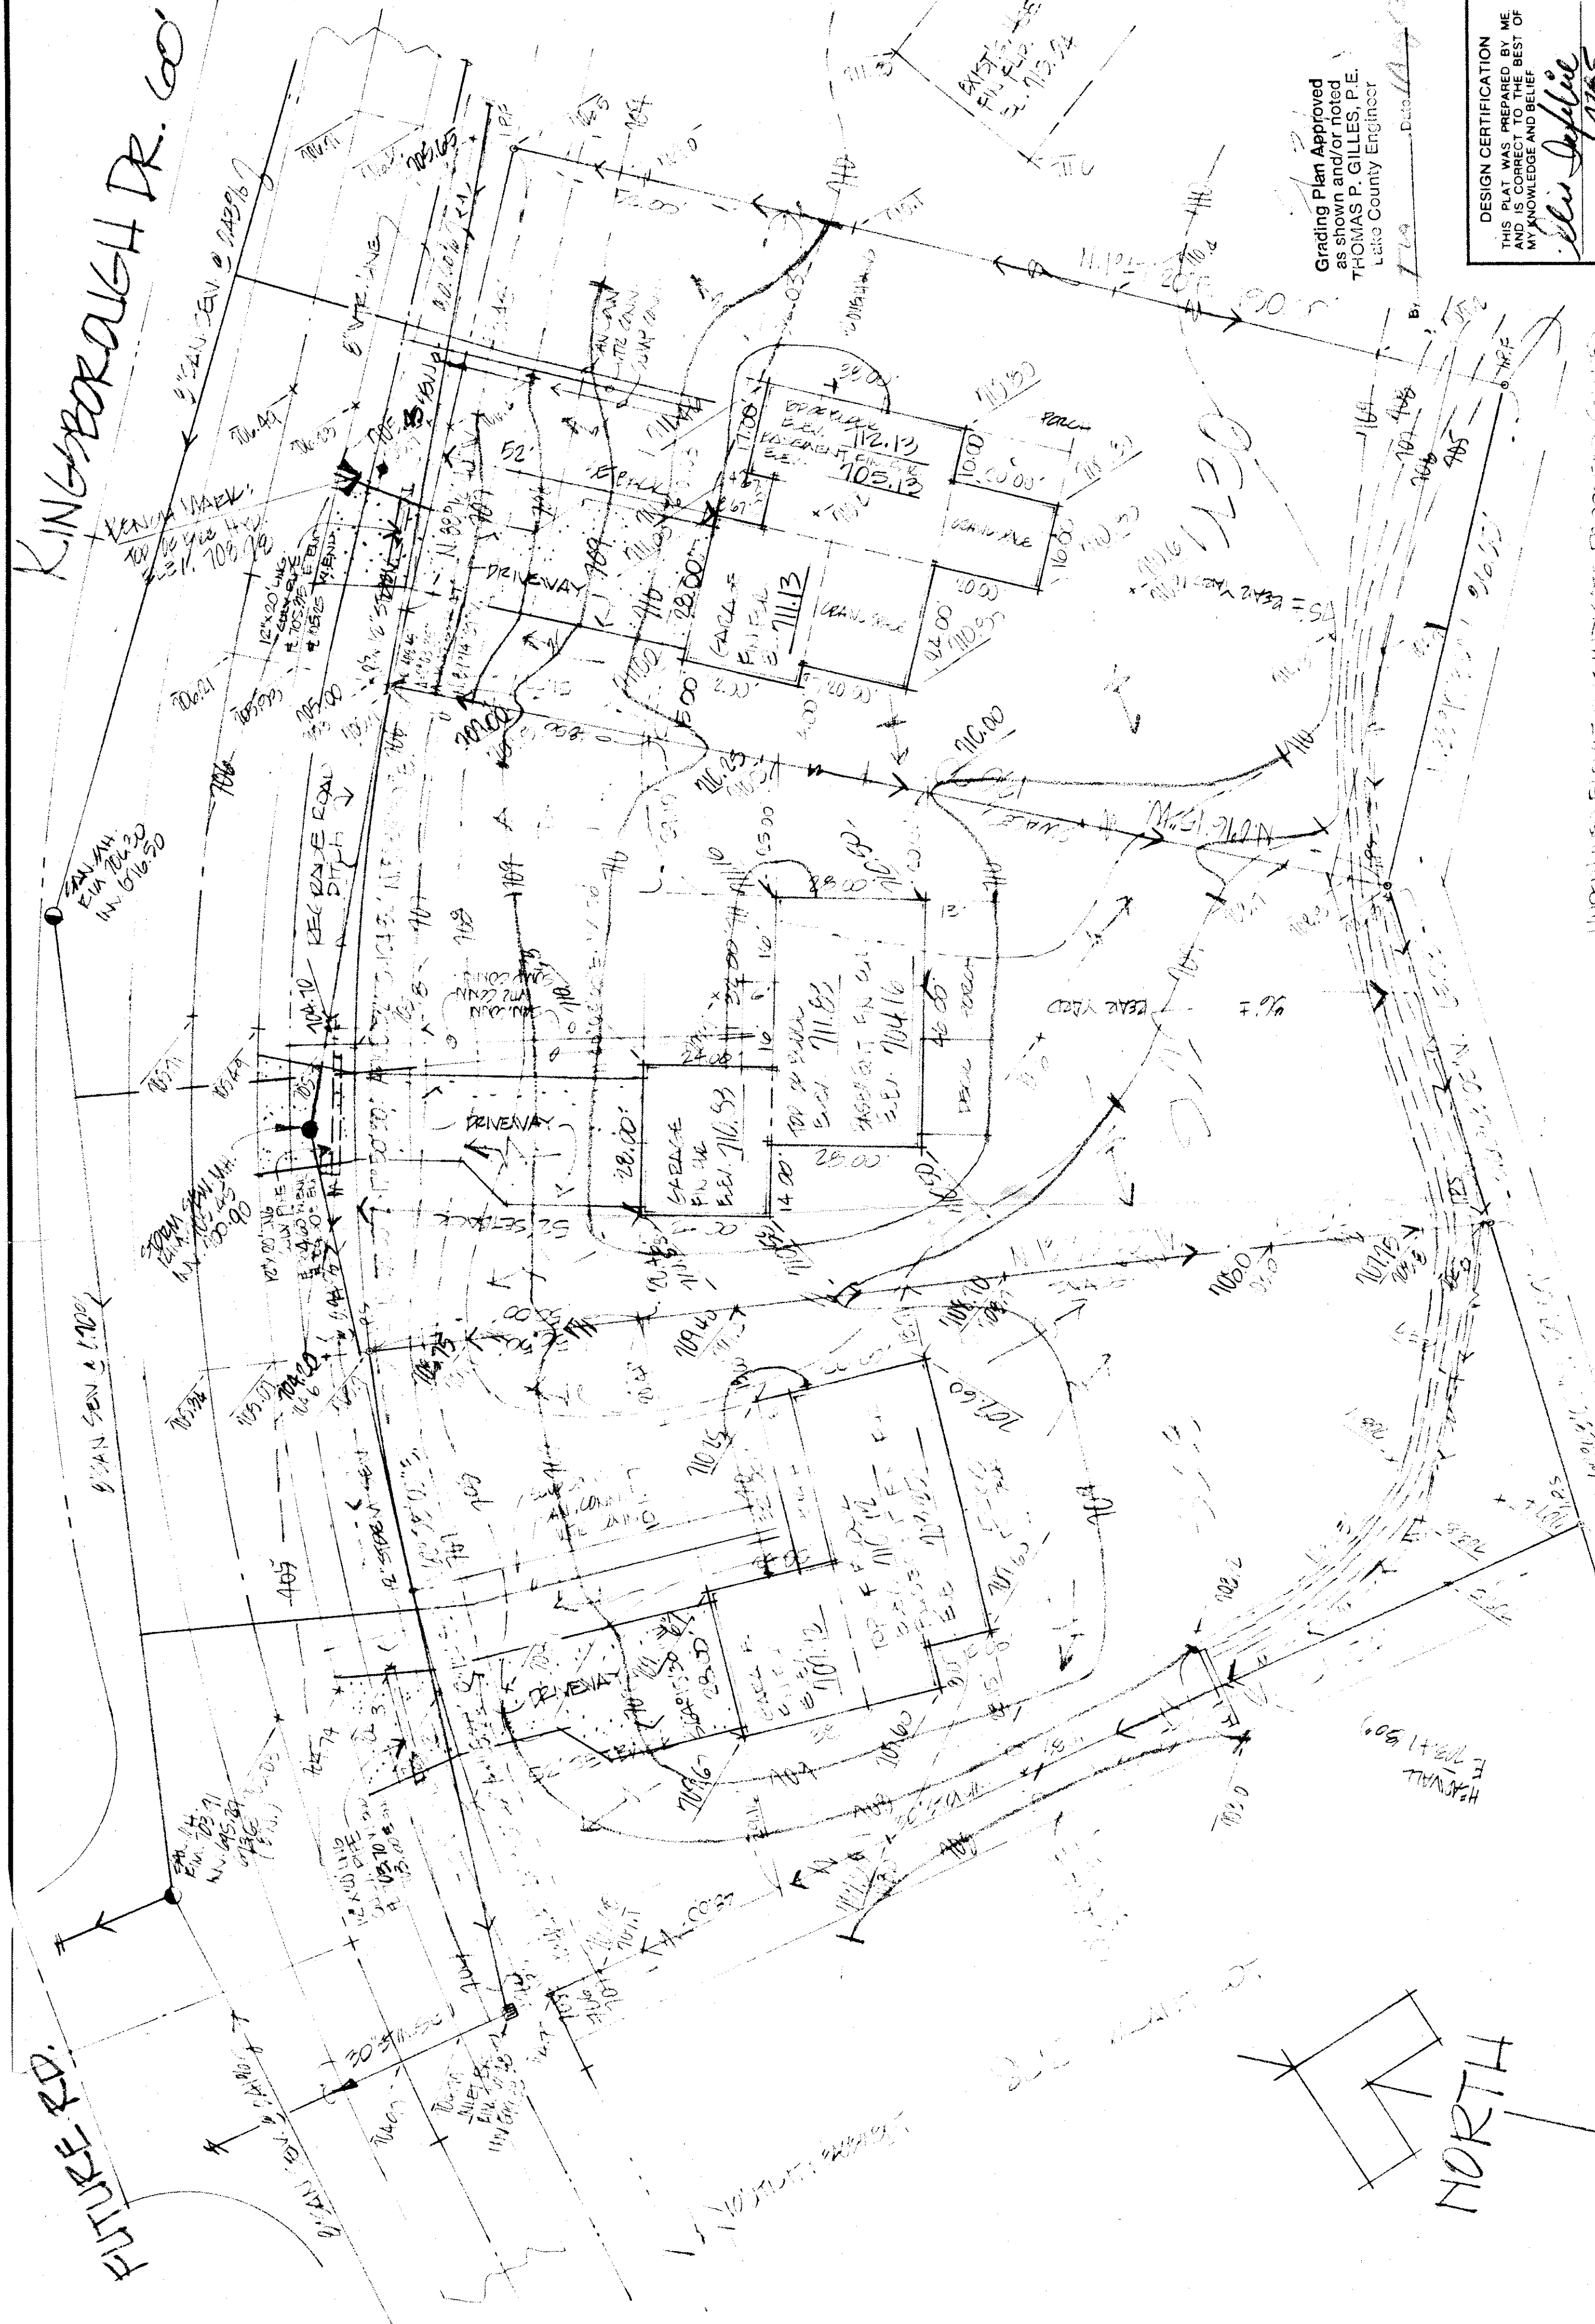

Grading Plan Approved
as shown and/or noted
THOMAS P. GILLES, P.E.
Lake County Engineer

DESIGN CERTIFICATION
THIS PLAN WAS PREPARED BY ME
AND IS CORRECT TO THE BEST OF
MY KNOWLEDGE AND BELIEF
Eli J. J. J.
REG. SURVEYOR NO. 10785

UNDERLINED ELEVATIONS INDICATE PROPOSED ELEVATIONS

SITE PLAN FOR CASELLENT HOMES
151 MADISON AVE., PINEVILLE, OHIO
PENDING SUBJECT TO 20% IN KINGBOROUGH HIGH SUBDIVISION PHASE I
AT PINEVILLE, OHIO. BEAR 110° 30' 00" S. 10° 30' 00" E. 100.00'

REVISED 7/25/83 - LOWERED DRIVEWAY CULVERTS
AND REGRADED ROAD DITCH. CB.

**COLPETZER · WOODS**
CONSULTANTS, INC.
MENTOR, OHIO 44060

DATE	July 1983
SCALE	1" = 20'
DRAWN BY	JD
CHECKED BY	JD
PLOT BY	JD
PAGE	5

SHEET 1 OF 1
CONTRACT NO. 15-008