


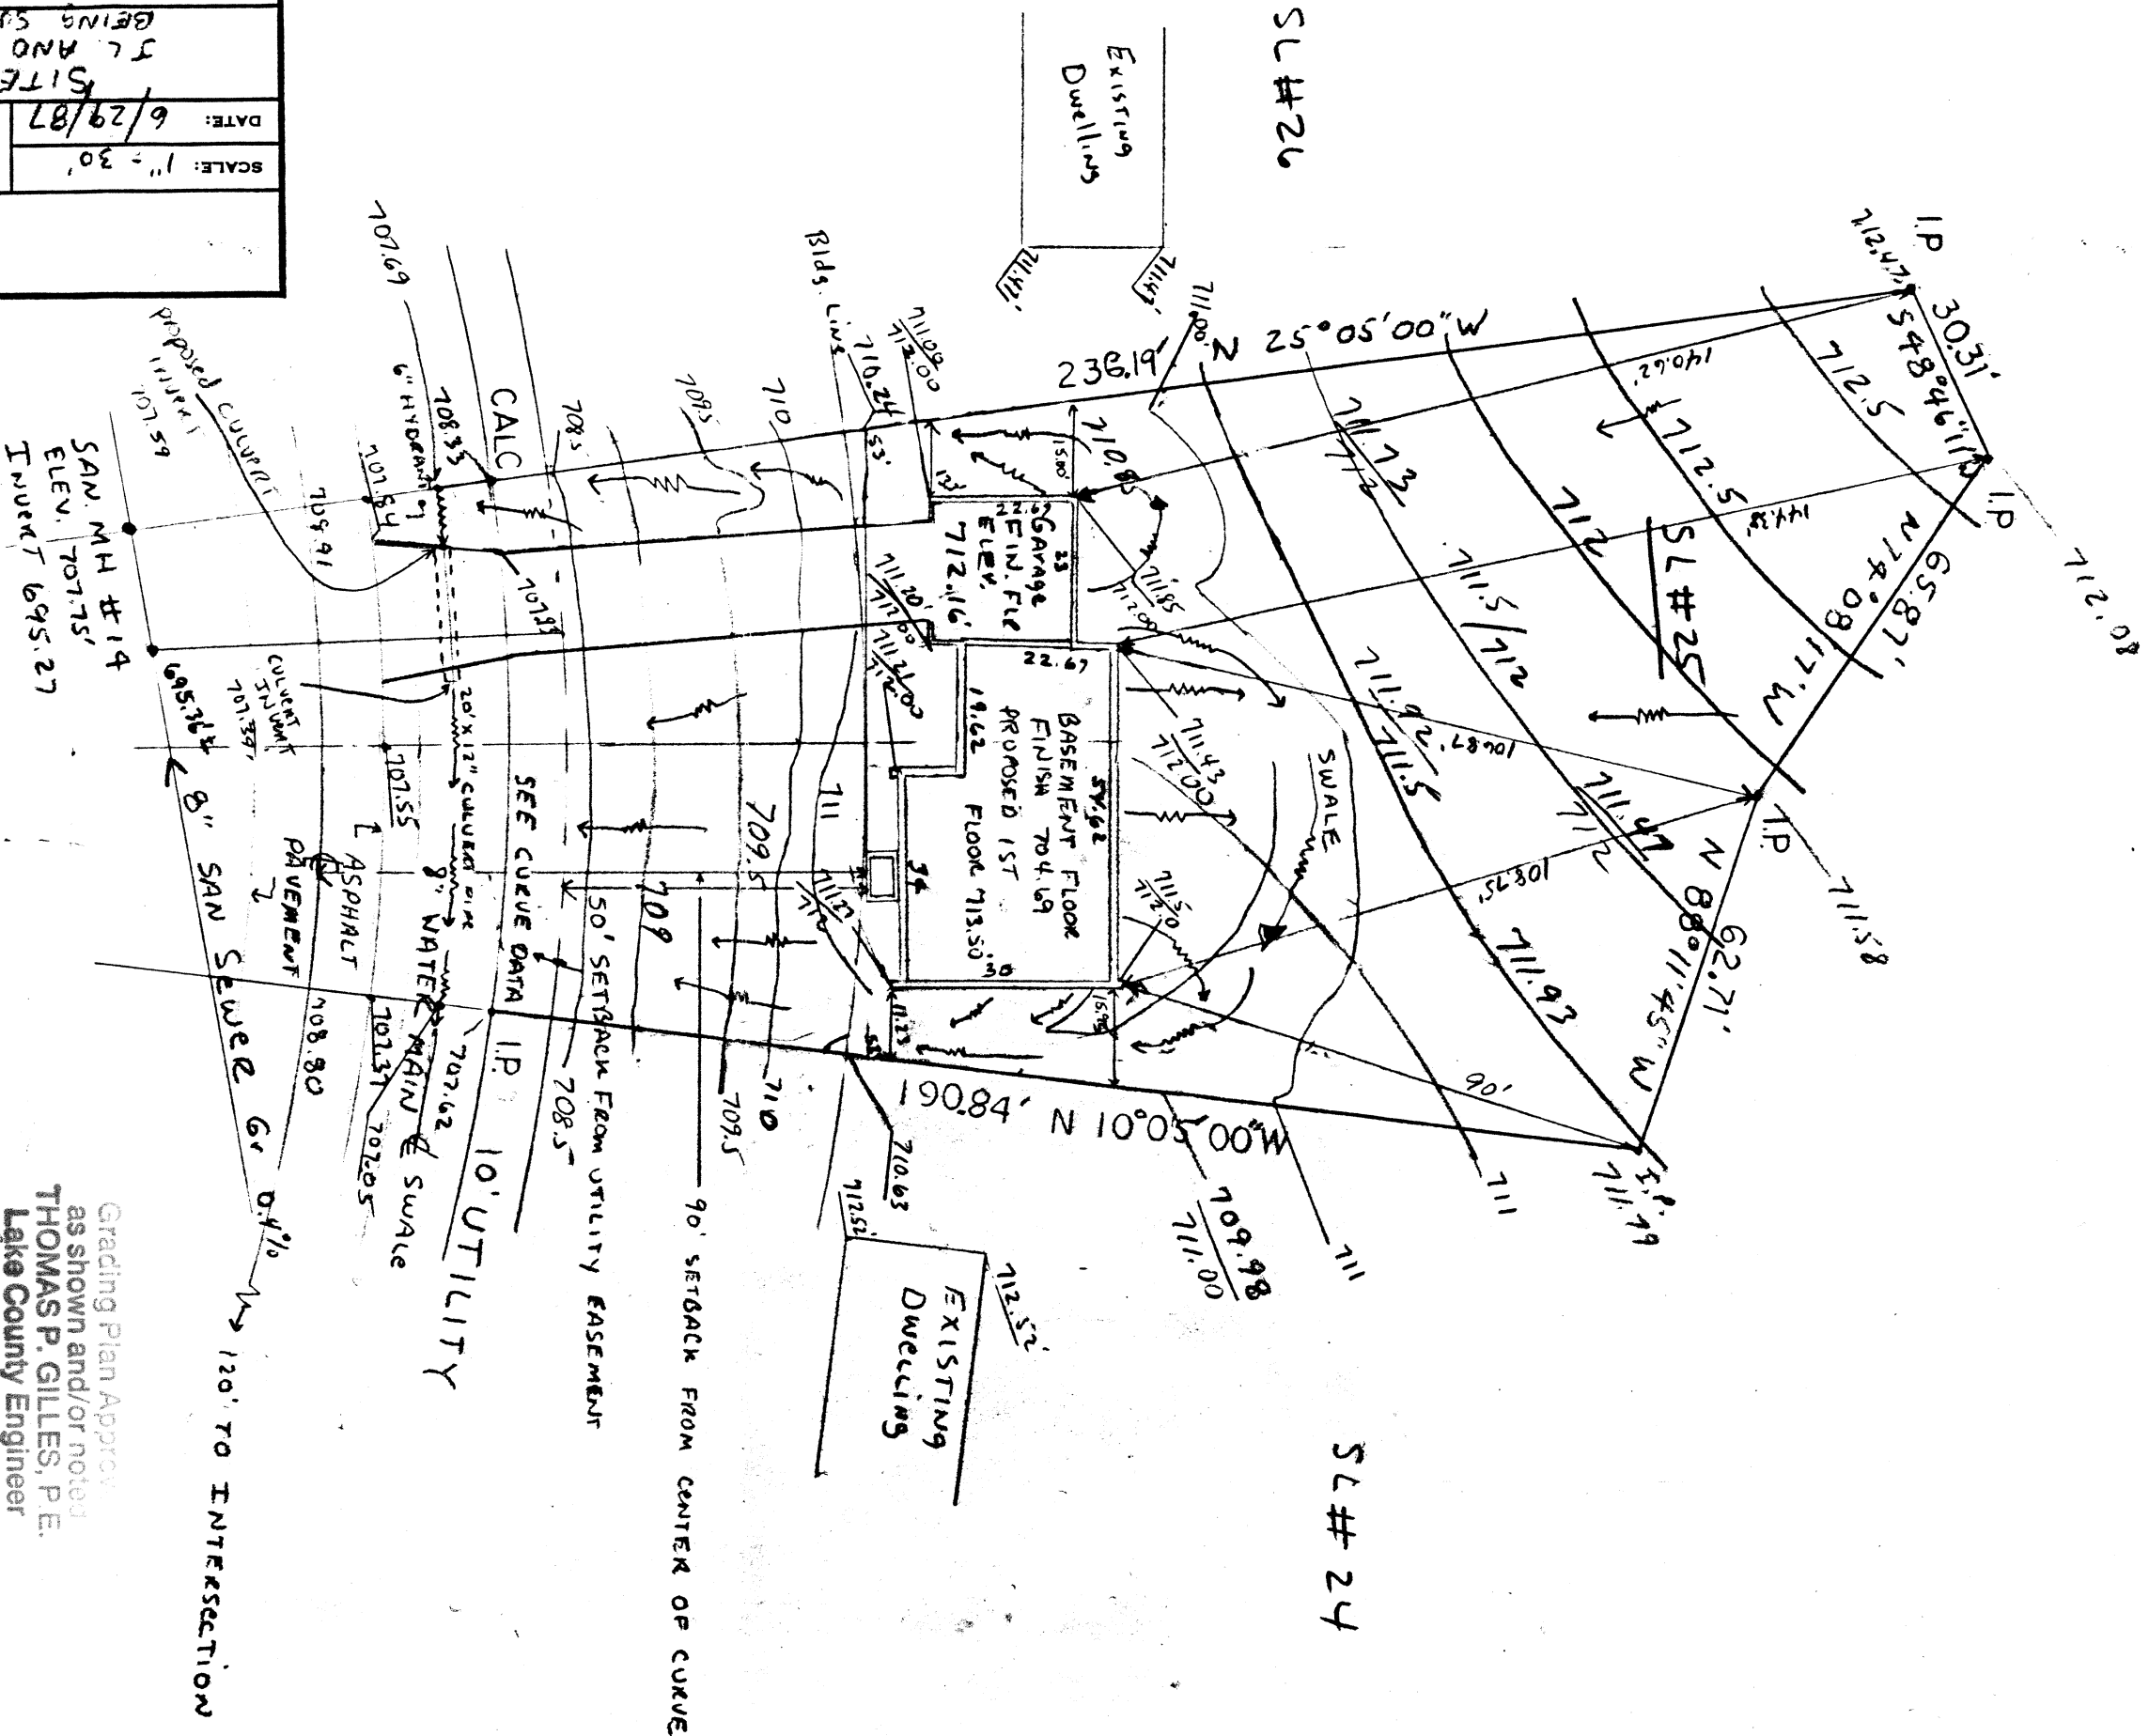

SCALE: 1" = 30'		APPROVED BY:		DRAWN BY J.L.V.	
DATE: 6/29/87		REVISED			
SITE PLAN FOR J.L. AND K.E. VAZZANA BEING SUBLOT A10.25 IN KINGSBOROUGH SUBDIVISION NO. 2, PAINEVILLE TWP LAKE COUNTY, OHIO					
DRAWING NUMBER					

NOTE: EXISTING
proposed

Design Certification:

THIS PLAT WAS PREPARED BY
ME AND IS CORRECT TO THE BEST
OF MY KNOWLEDGE AND BELIEF.

James W. Wynn, P.E.
Registered Engineer # 048308

AUDIT # 003807

BENCH MARK
TOP OF SANITARY
MANHOLE NO. 14
ELEVATION: 707.75'

CURVE DATA

A = 86.39'
Δ = 15°00'00"
C = 86.15'
R = 300'
N 72°25'00" E

Grading Plan Approved
as shown and/or noted
THOMAS P. GILLES, P.E.
Lake County Engineer

By THP Date 7-5-87

24# 6734