


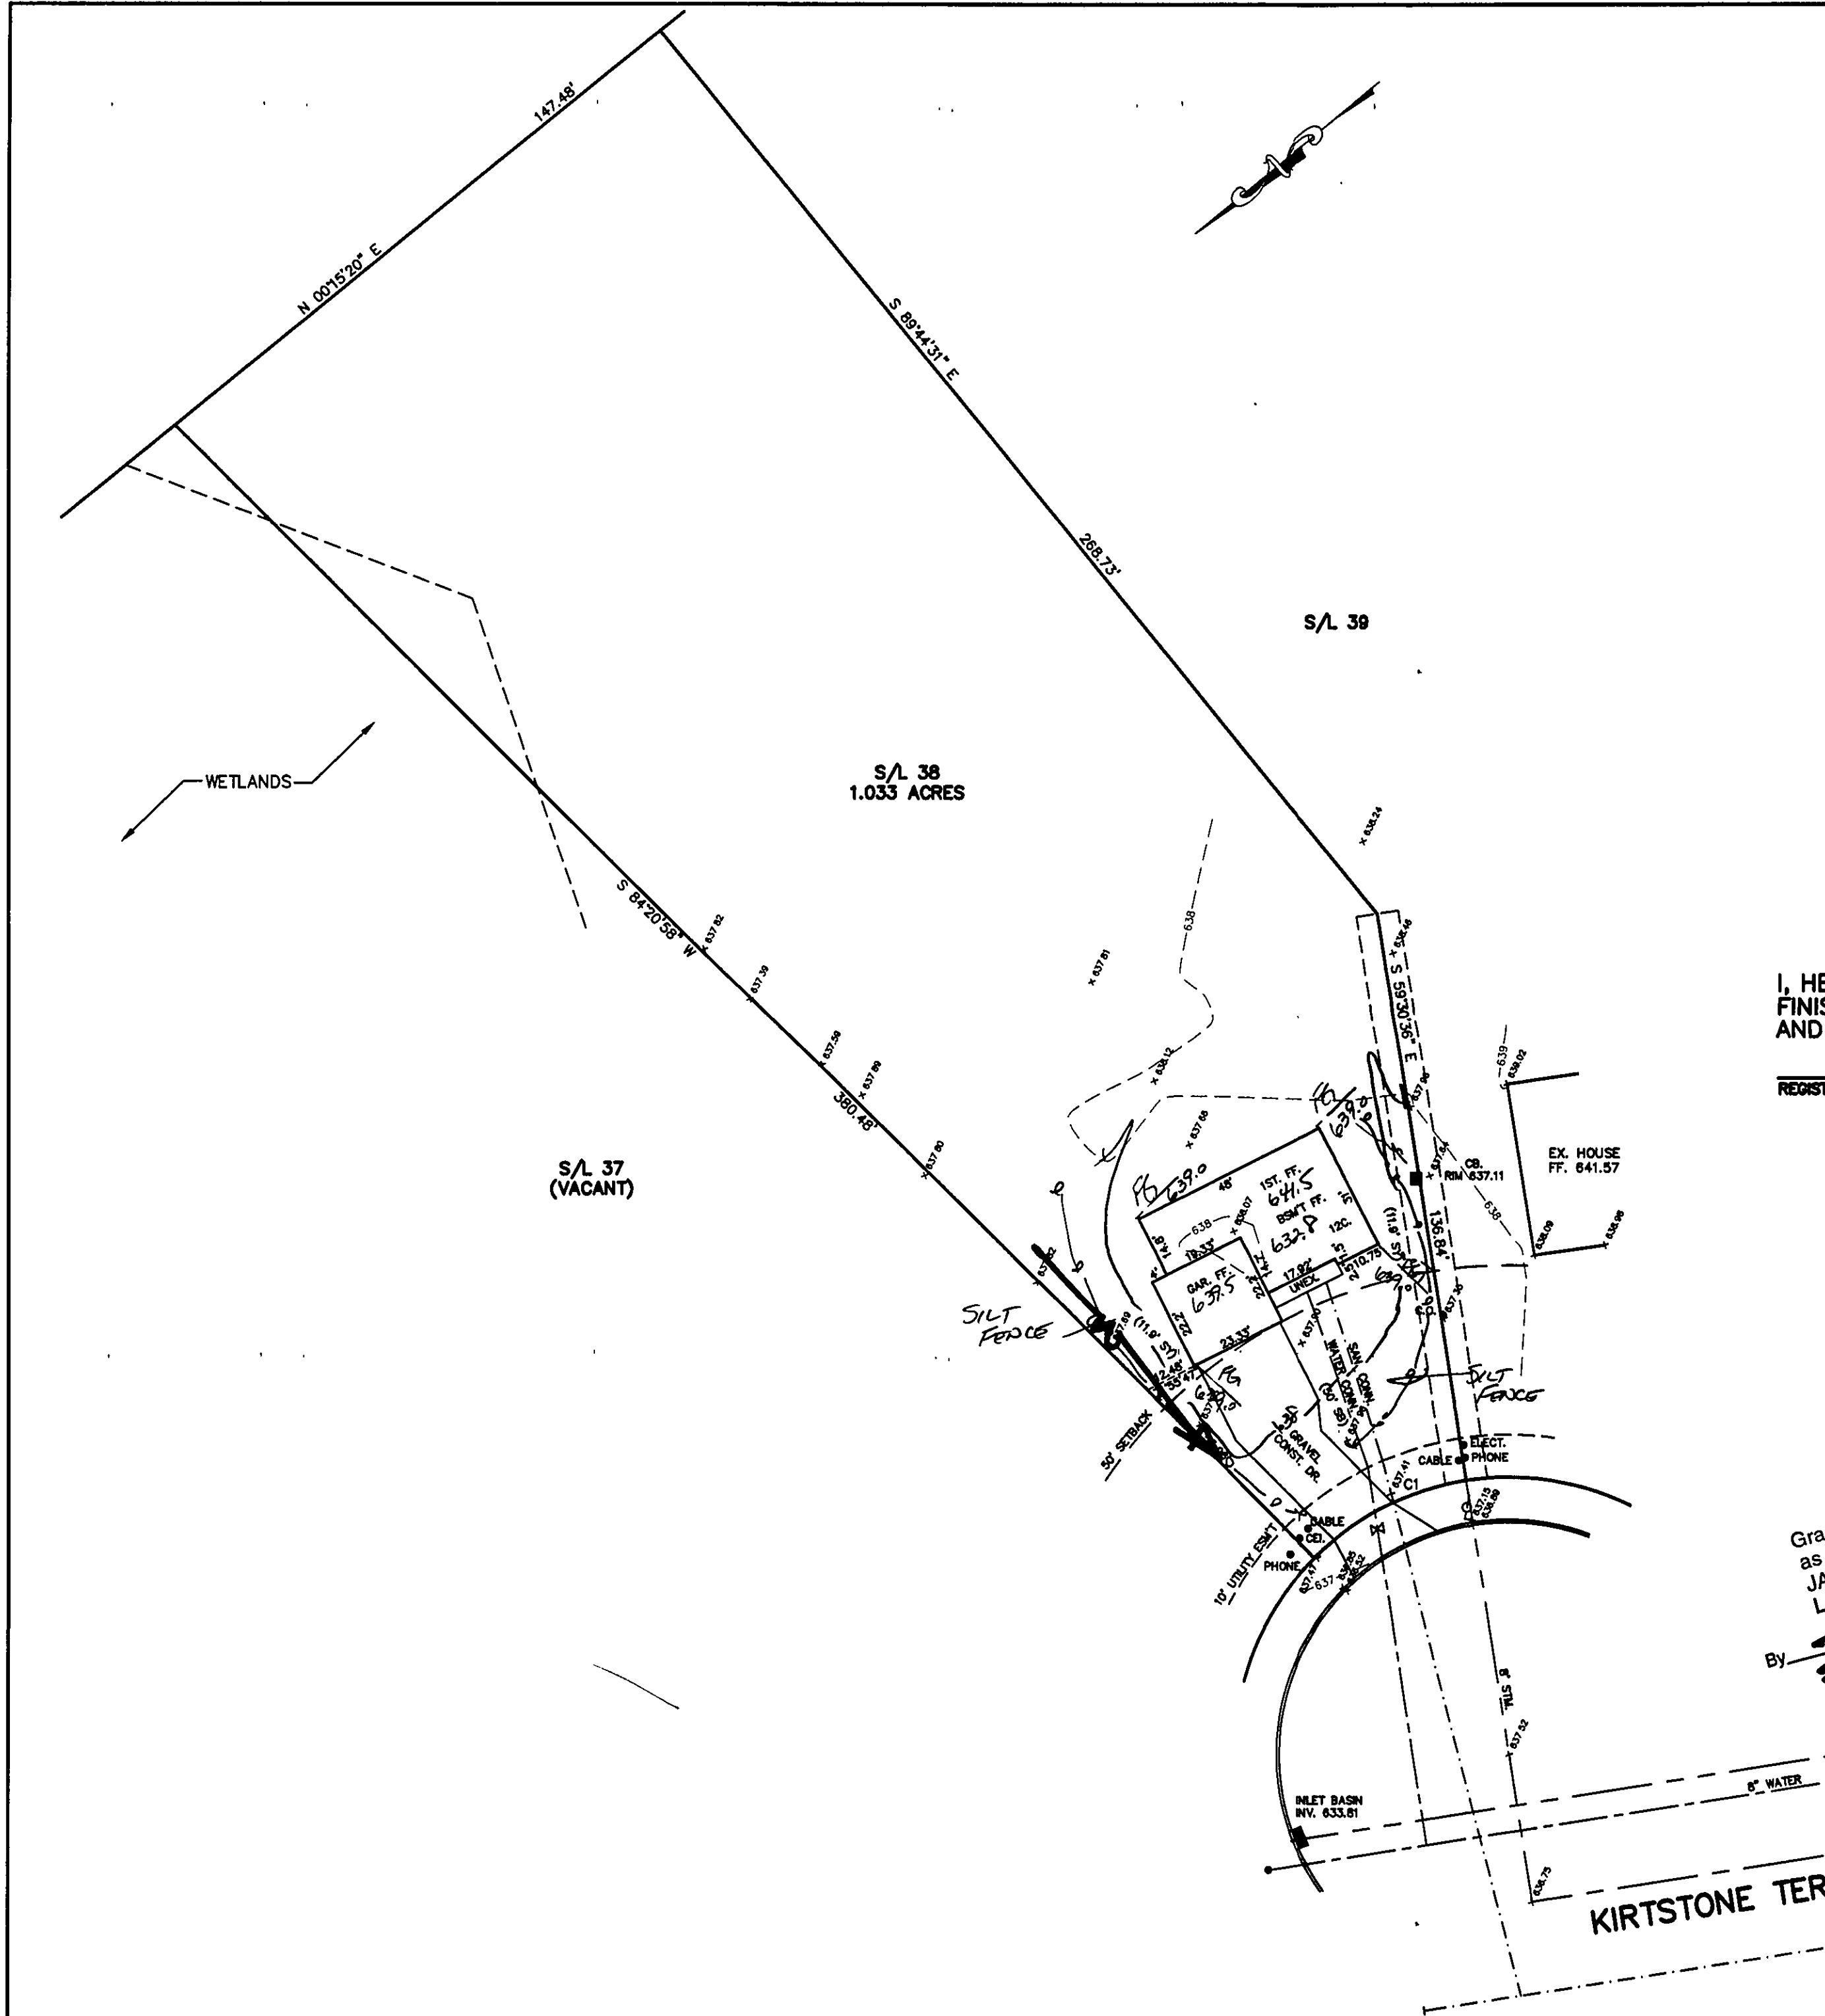

SITE PLAN

PAINESVILLE TWP., LAKE COUNTY, OHIO

for: CAPUTO

CLIENT

OWNER

ADDRESS

STREET

CITY

ZIP

THE PINES SUB. #5

SUBDIVISION

35-15

NAME

TRACT

STREET

38

VOL-PG

KIRTSTONE TERRACE

LOT

STREET

VOL-PG

PERM. PARCEL NO.

LEGEND

SANITARY MANHOLE

STORM MANHOLE

INLET OR CATCH BASIN

HYDRANT

EXISTING CONTOURS

PROPOSED CONTOURS

EXST. ELEV. 100.0

100.0 ± 2 PROP. ELEV.

AS BUILT ELEVATION

INDICATES DIRECTION OF SURFACE DRAINAGE

DESIGN CERTIFICATION

THIS PLAT WAS PREPARED BY ME, AND IS CORRECT TO THE BEST OF MY KNOWLEDGE AND BELIEF.

NAME

SURVEYOR

REGISTRATION NO.

REVISIONS

NO.	DATE	BY
1		
2		
3		
4		
5		

PLAN PREPARED BY:

BABCOCK JONES & ASSOCIATES, INC.

PAINESVILLE, OHIO

DRAWN BY

T.R.

SCALE

1" = 30'

PHONE NO.

440-357-1811

CHK'D.

H.J.

DATE

4/15/01

DRAWING NO.

00-064-38

CREW CHIEF

R.B.

APP'D

H.J.

"AS BUILT" CERTIFICATION
I, HEREBY CERTIFY THAT THE CIRCLED GRADES ARE EXISTING
FINISH GRADES CHECKED IN THE FIELD ON _____, 20____
AND ARE CORRECT TO THE BEST OF MY KNOWLEDGE AND BELIEF.

REGISTERED SURVEYOR	REG. NO.
BM-SANITARY MANHOLE #5 RIM=637.32	C1: R=65.00' L=40.99' T=21.20' D=36°08'08" C=40.32' N12°25'11"E

NOTE: TEMPORARY SEEDING REQUIRED
IN DISTURBED AREAS.

- HIGH WALL PLUMBING
REQUIRED

Grading Plan Approved
as shown and/or noted
JAMES R. GILLS, P.E.
Lake County Engineer
By: **TAM** Date: **7/26/01**
Swab as shown
ROOF DRAINS
SHALL DISCHARGE
TO SPLASH BLOCKS.

APPROVED
PAINESVILLE TOWNSHIP
ZONING DEPARTMENT
2001-194
D. H. H.

KIRTSTONE TERRACE - 60'

SAN. MH.
RIM 637.32
INV. 632.22