


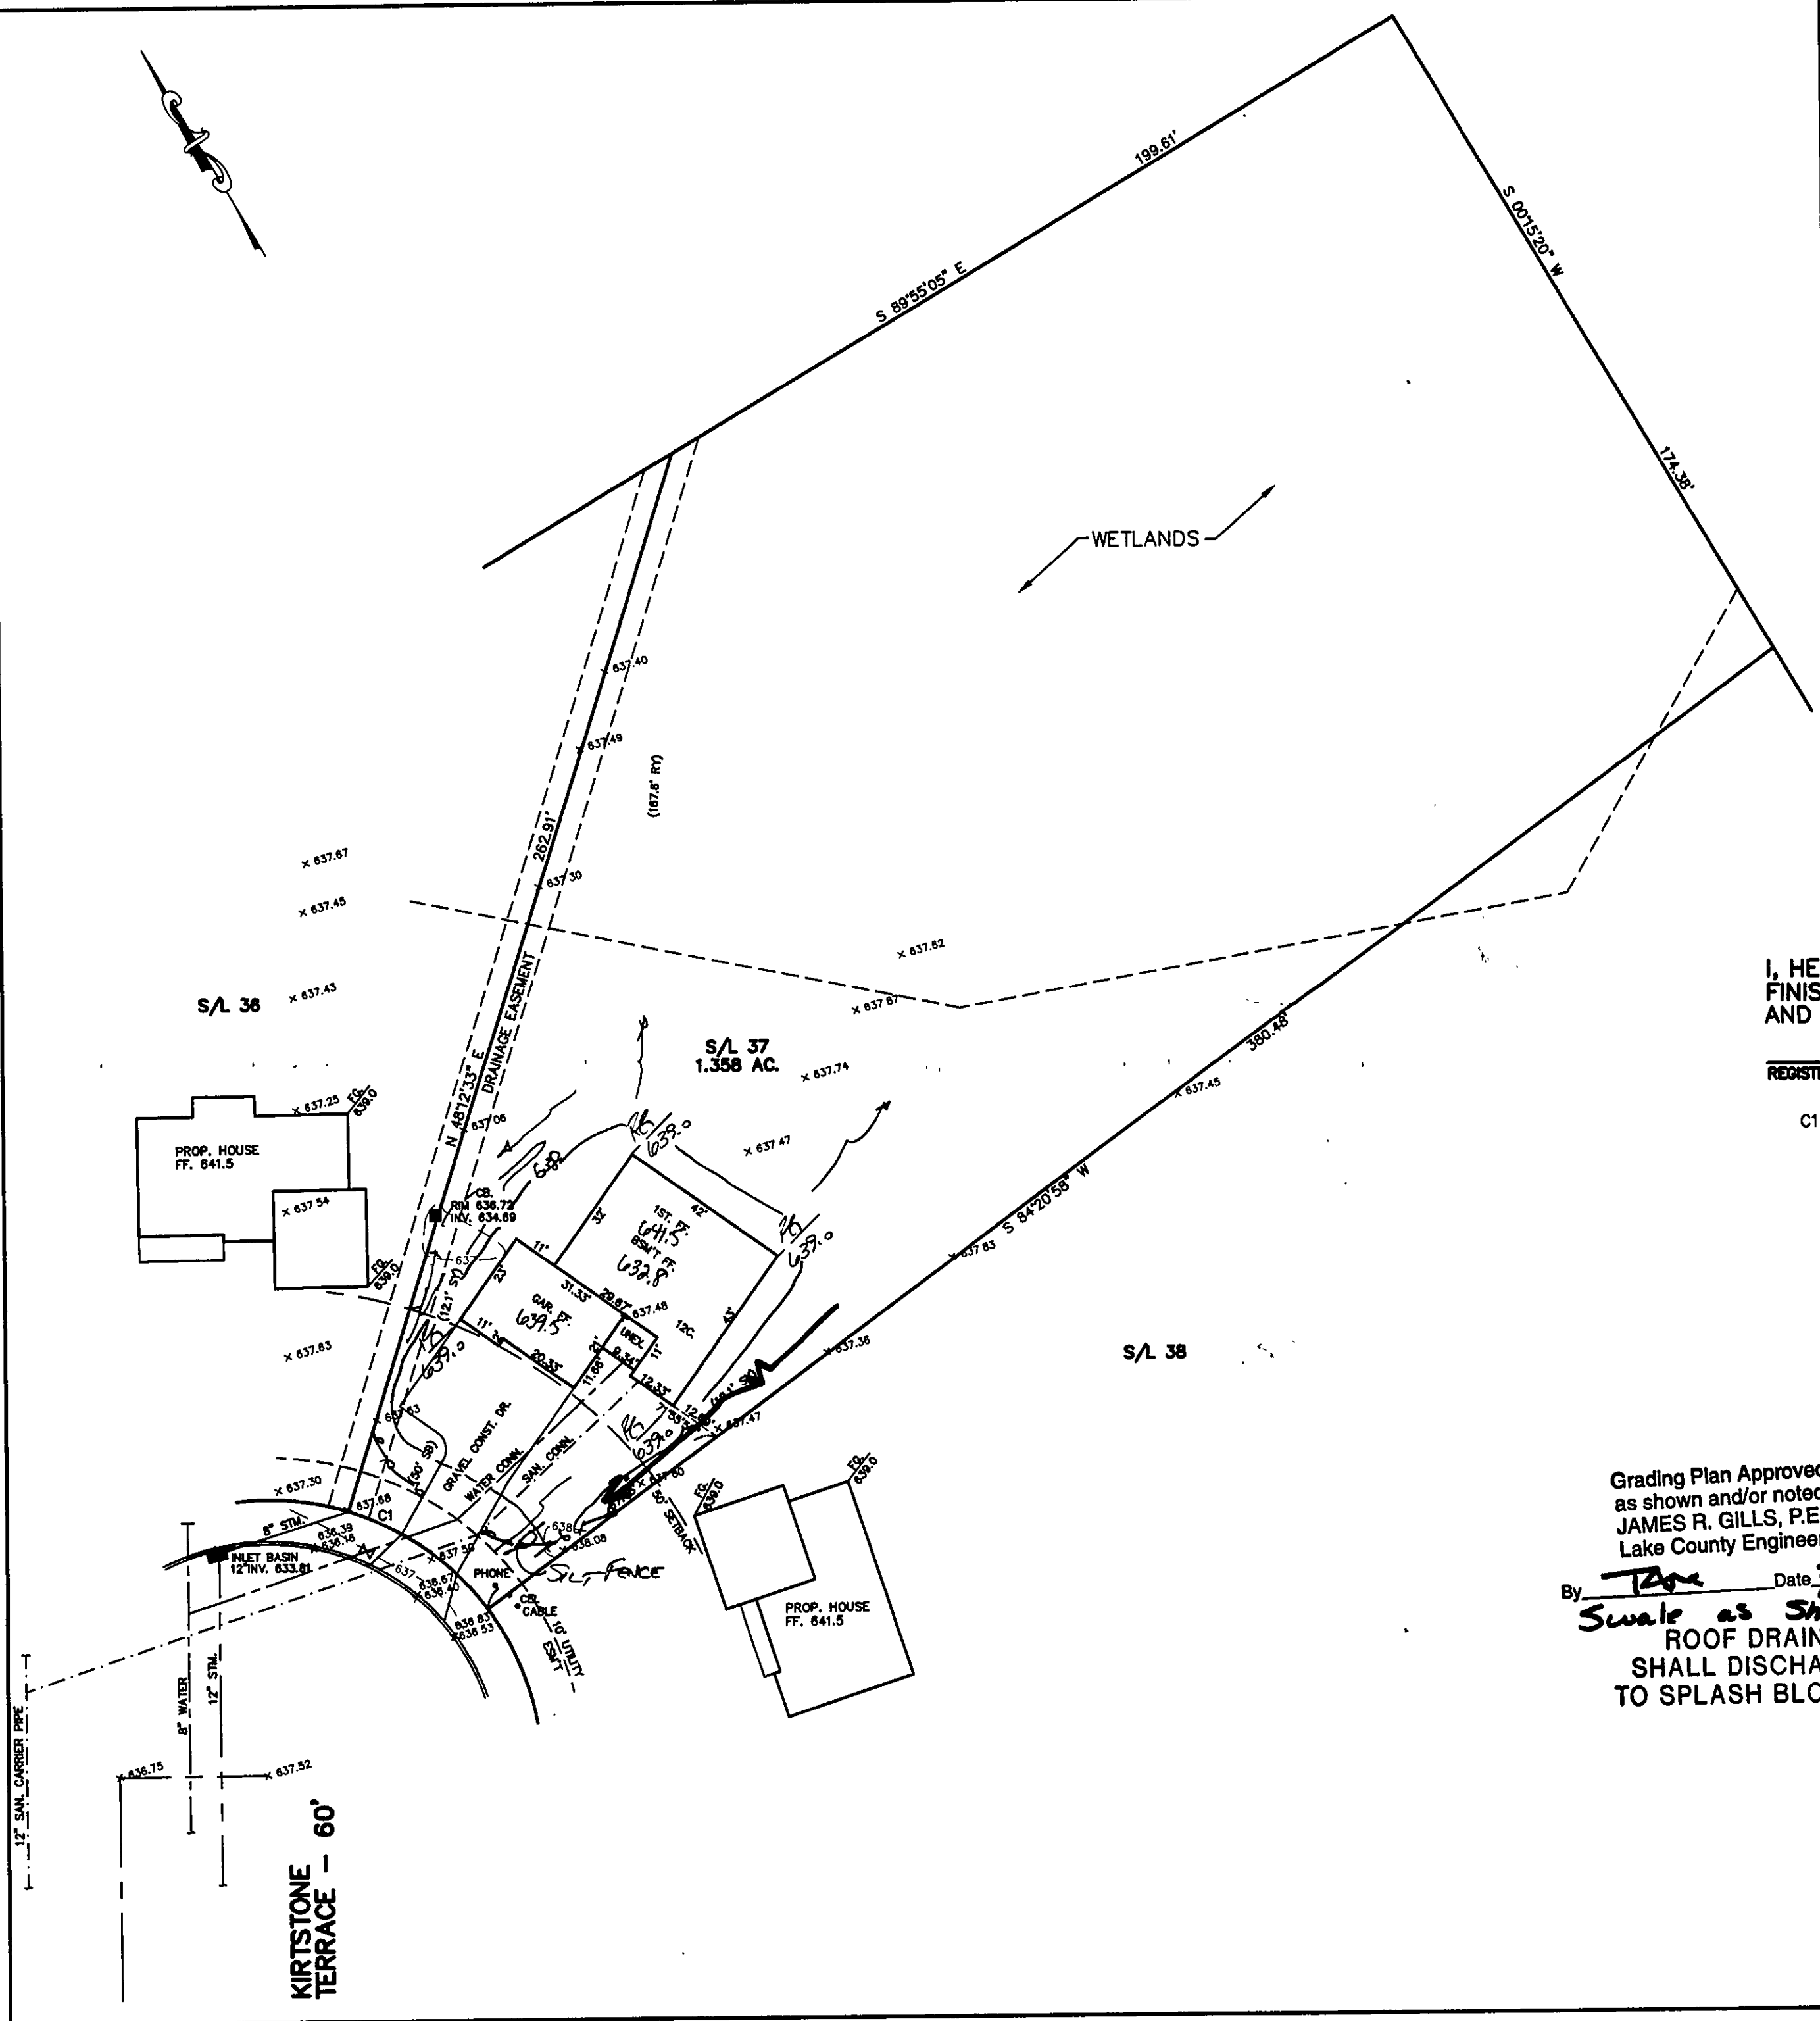

SITE PLAN

PAINESVILLE TWP., LAKE COUNTY, OHIO

for: CAPUTO

CLIENT	OWNER		
ADDRESS	STREET	CITY	ZIP

THE PINES SUB. PHASE V			
SUBDIVISION	NAME	TRACT	STREET
35-15			
37	KIRSTSTONE TERRACE	LOT	
SUBLOT NO.	STREET	VOL.-PG.	PERM. PARCEL NO.

LEGEND

SANITARY MANHOLE	---○---
STORM MANHOLE	---●---
INLET OR CATCH BASIN	---○---
HYDRANT	---○---
EXISTING CONTOURS	---○---
PROPOSED CONTOURS	---○---
EXIST. ELEV. 100.0	100.0 = 2' PROP. ELEV.
AS BUILT ELEVATION	100.0
INDICATES DIRECTION OF SURFACE DRAINAGE	100.0

DESIGN CERTIFICATION

THIS PLAT WAS PREPARED BY ME, AND IS CORRECT TO THE BEST OF MY KNOWLEDGE AND BELIEF.

NAME	SURVEYOR	REGISTRATION NO.

REVISIONS			PLAN PREPARED BY:		
NO.	DATE	BY	BABCOCK JONES & ASSOCIATES, INC.		
1			PAINESVILLE, OHIO		
2					
3			DRAWN BY T.R.	SCALE 1"=20'	PHONE NO. 440-357-1811
4			CHK'D. H.J.	DATE 6/22/01	DRAWING NO. 00-064-37
5			CREW R.B.	APP'D H.J.	

"AS BUILT" CERTIFICATION
I, HEREBY CERTIFY THAT THE CIRCLED GRADES ARE EXISTING FINISH GRADES CHECKED IN THE FIELD ON 20 AND ARE CORRECT TO THE BEST OF MY KNOWLEDGE AND BELIEF.

REGISTERED SURVEYOR

REG. NO.

C1: R=65.00'
L=41.00'
T=21.21'
D=36°08'34"
C=40.33'
N23°43'12"W

BM-SANITARY MANHOLE #5
RIM=637.32

NOTE: TEMPORARY SEEDING REQUIRED IN DISTURBED AREAS.

Grading Plan Approved as shown and/or noted JAMES R. GILLS, P.E. Lake County Engineer
By T.R. Date 7/24/01
Swale as Shown
ROOF DRAINS SHALL DISCHARGE TO SPLASH BLOCKS.

2001-195
APPROVED
PAINESVILLE TOWNSHIP ZONING DEPARTMENT

