


I, the undersigned hereby certify that
this topography, indicated by 1' contours,
and elevations shown hereon represent an
actual field survey made by me on DEC. 15, 1992
and that the elevations were taken at
appropriate intervals and that is of that
date they existed as indicated hereon.

J.M. Coffman PS
No. 6857

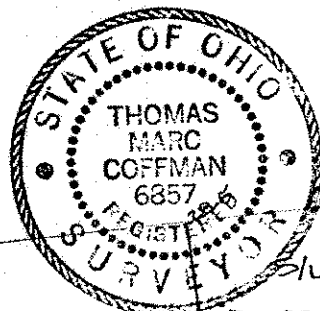


SITE PLAN

FOR

CROSS BLDG'S

BEING S/L 218 & THE NORTHERLY
HALF OF S/L 219. HARDY POINT
ALLOTMENT, PAINESVILLE TWP.,
LAKE COUNTY, OHIO.

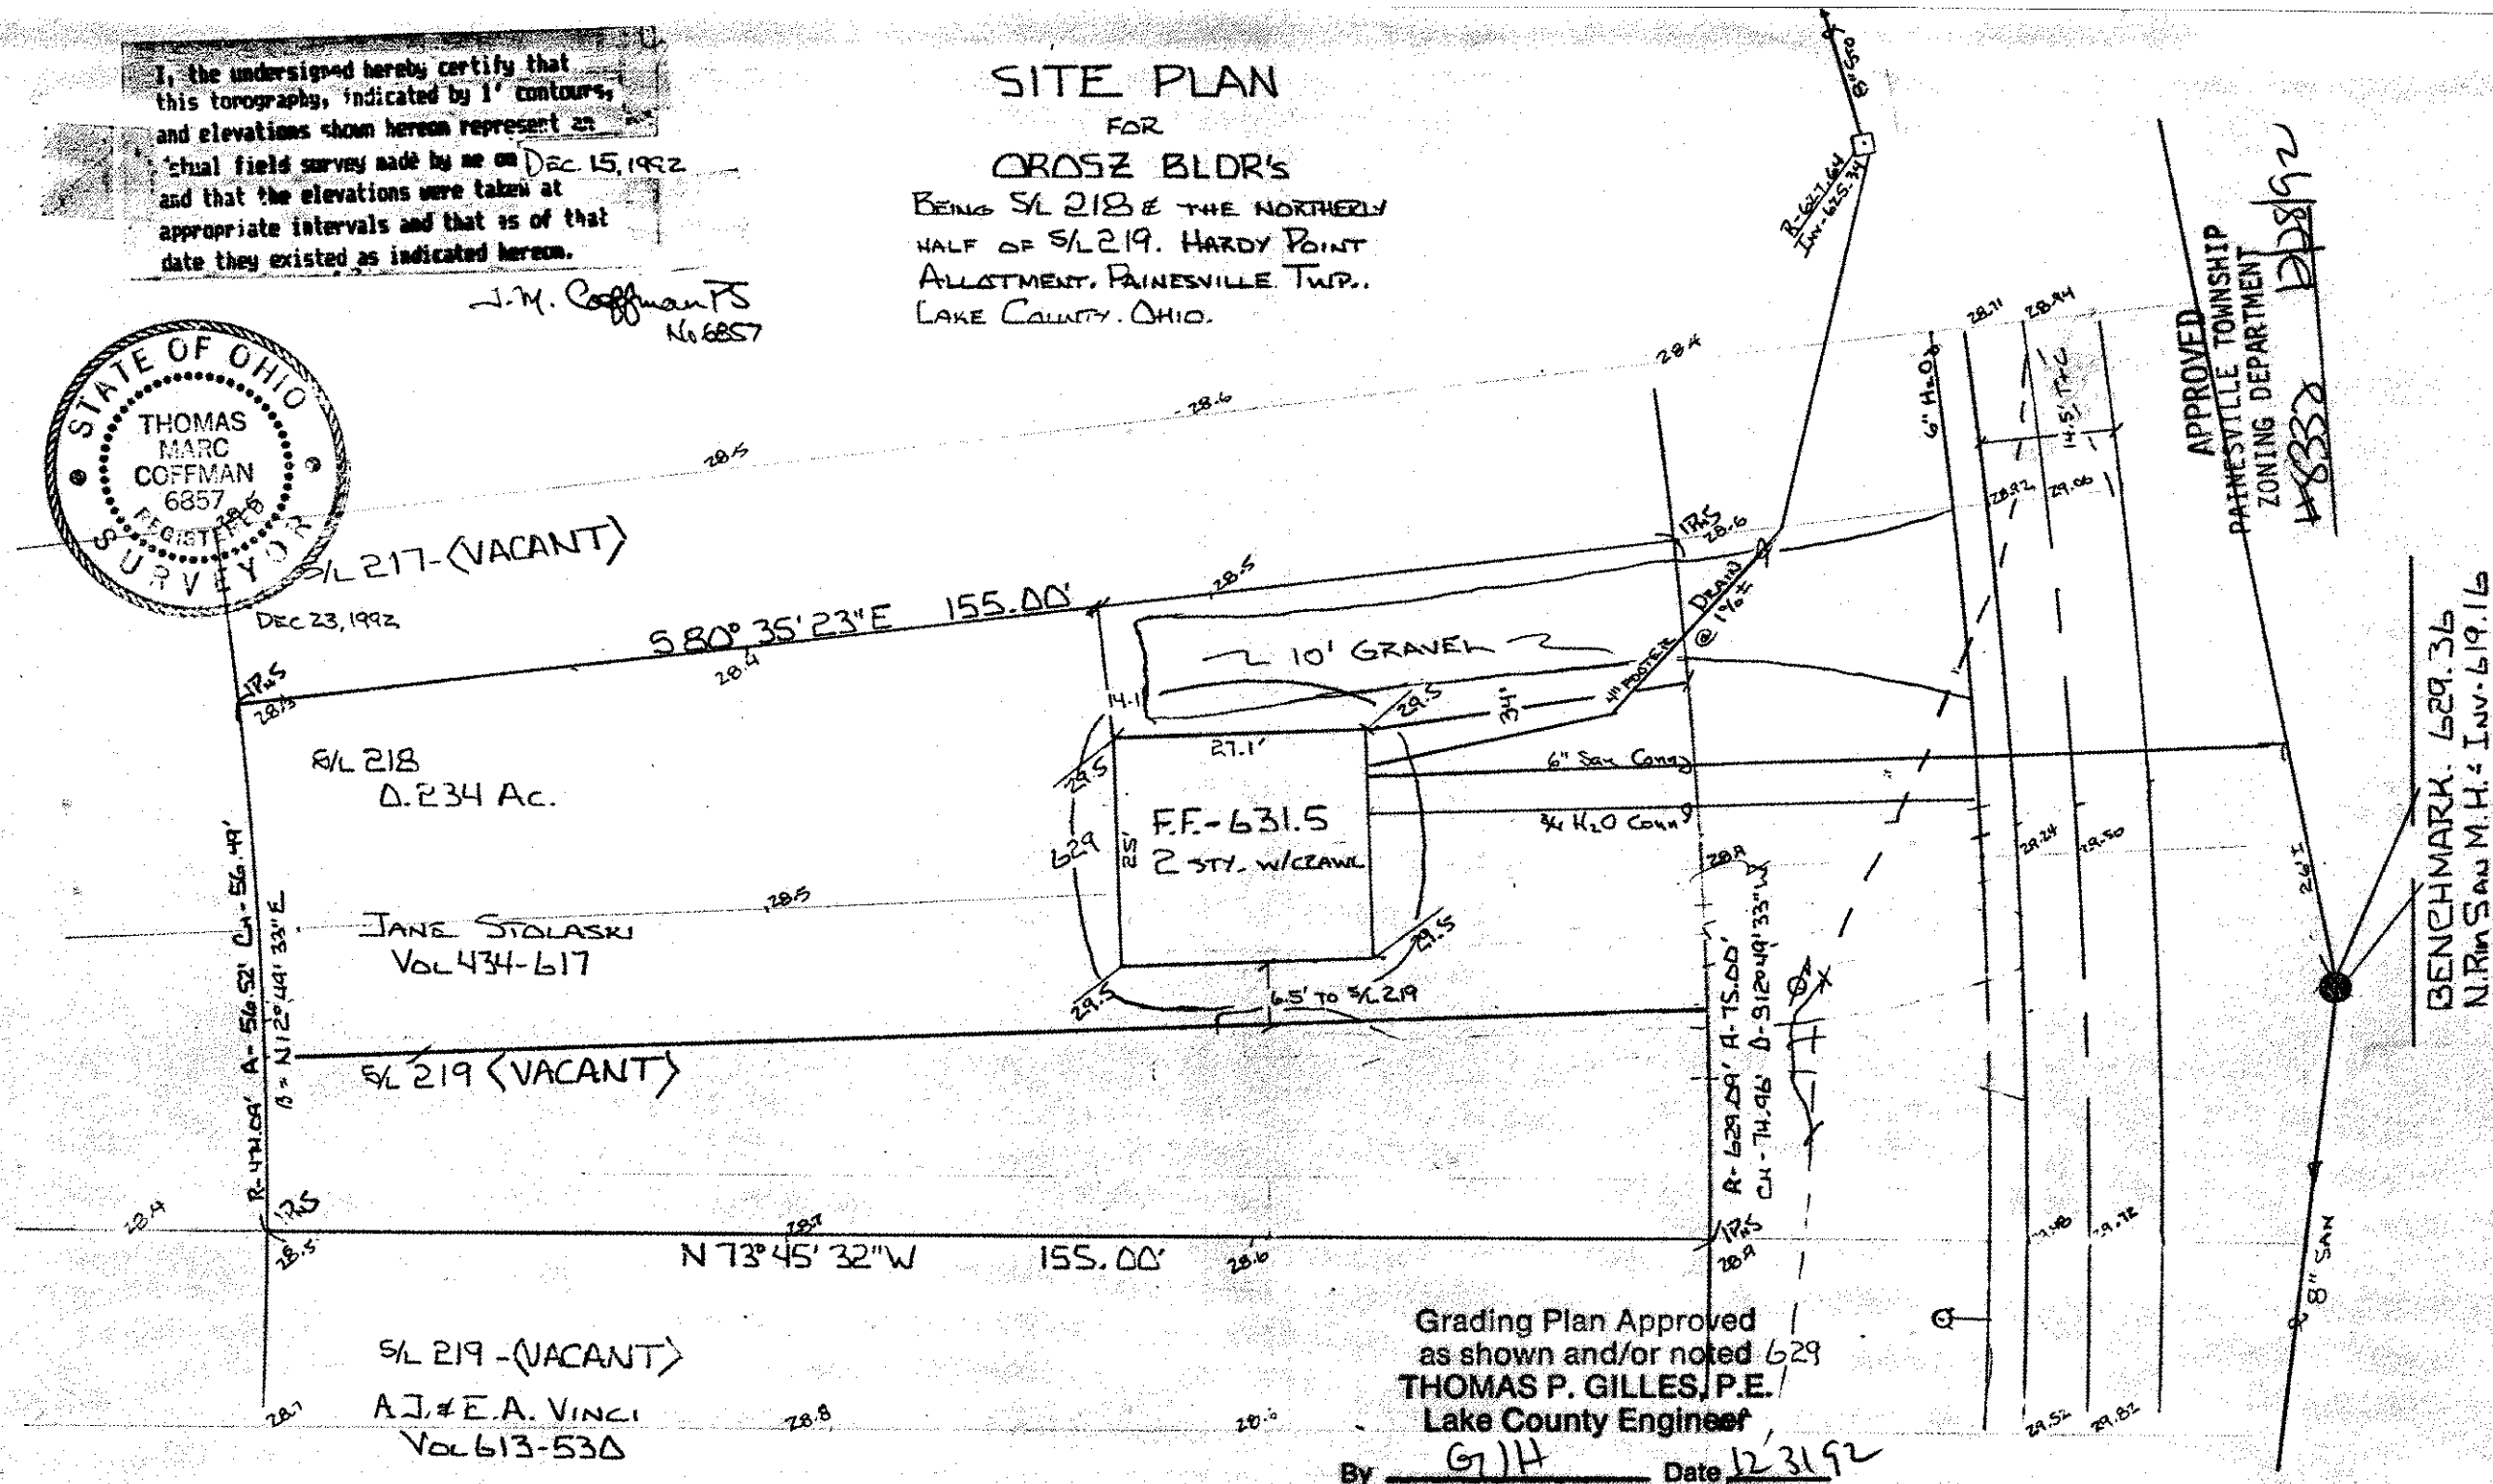

APPROVED
PAINESVILLE TOWNSHIP
ZONING DEPARTMENT

#8332 12/28/92

BENCHMARK. 629.36
N.R.M. SAN M.H. Inv. 619.16

Grading Plan Approved
as shown and/or noted 629
THOMAS P. GILLES, P.E.
Lake County Engineer

By GTH Date 12/31/92