


WICHAM LANE CO.

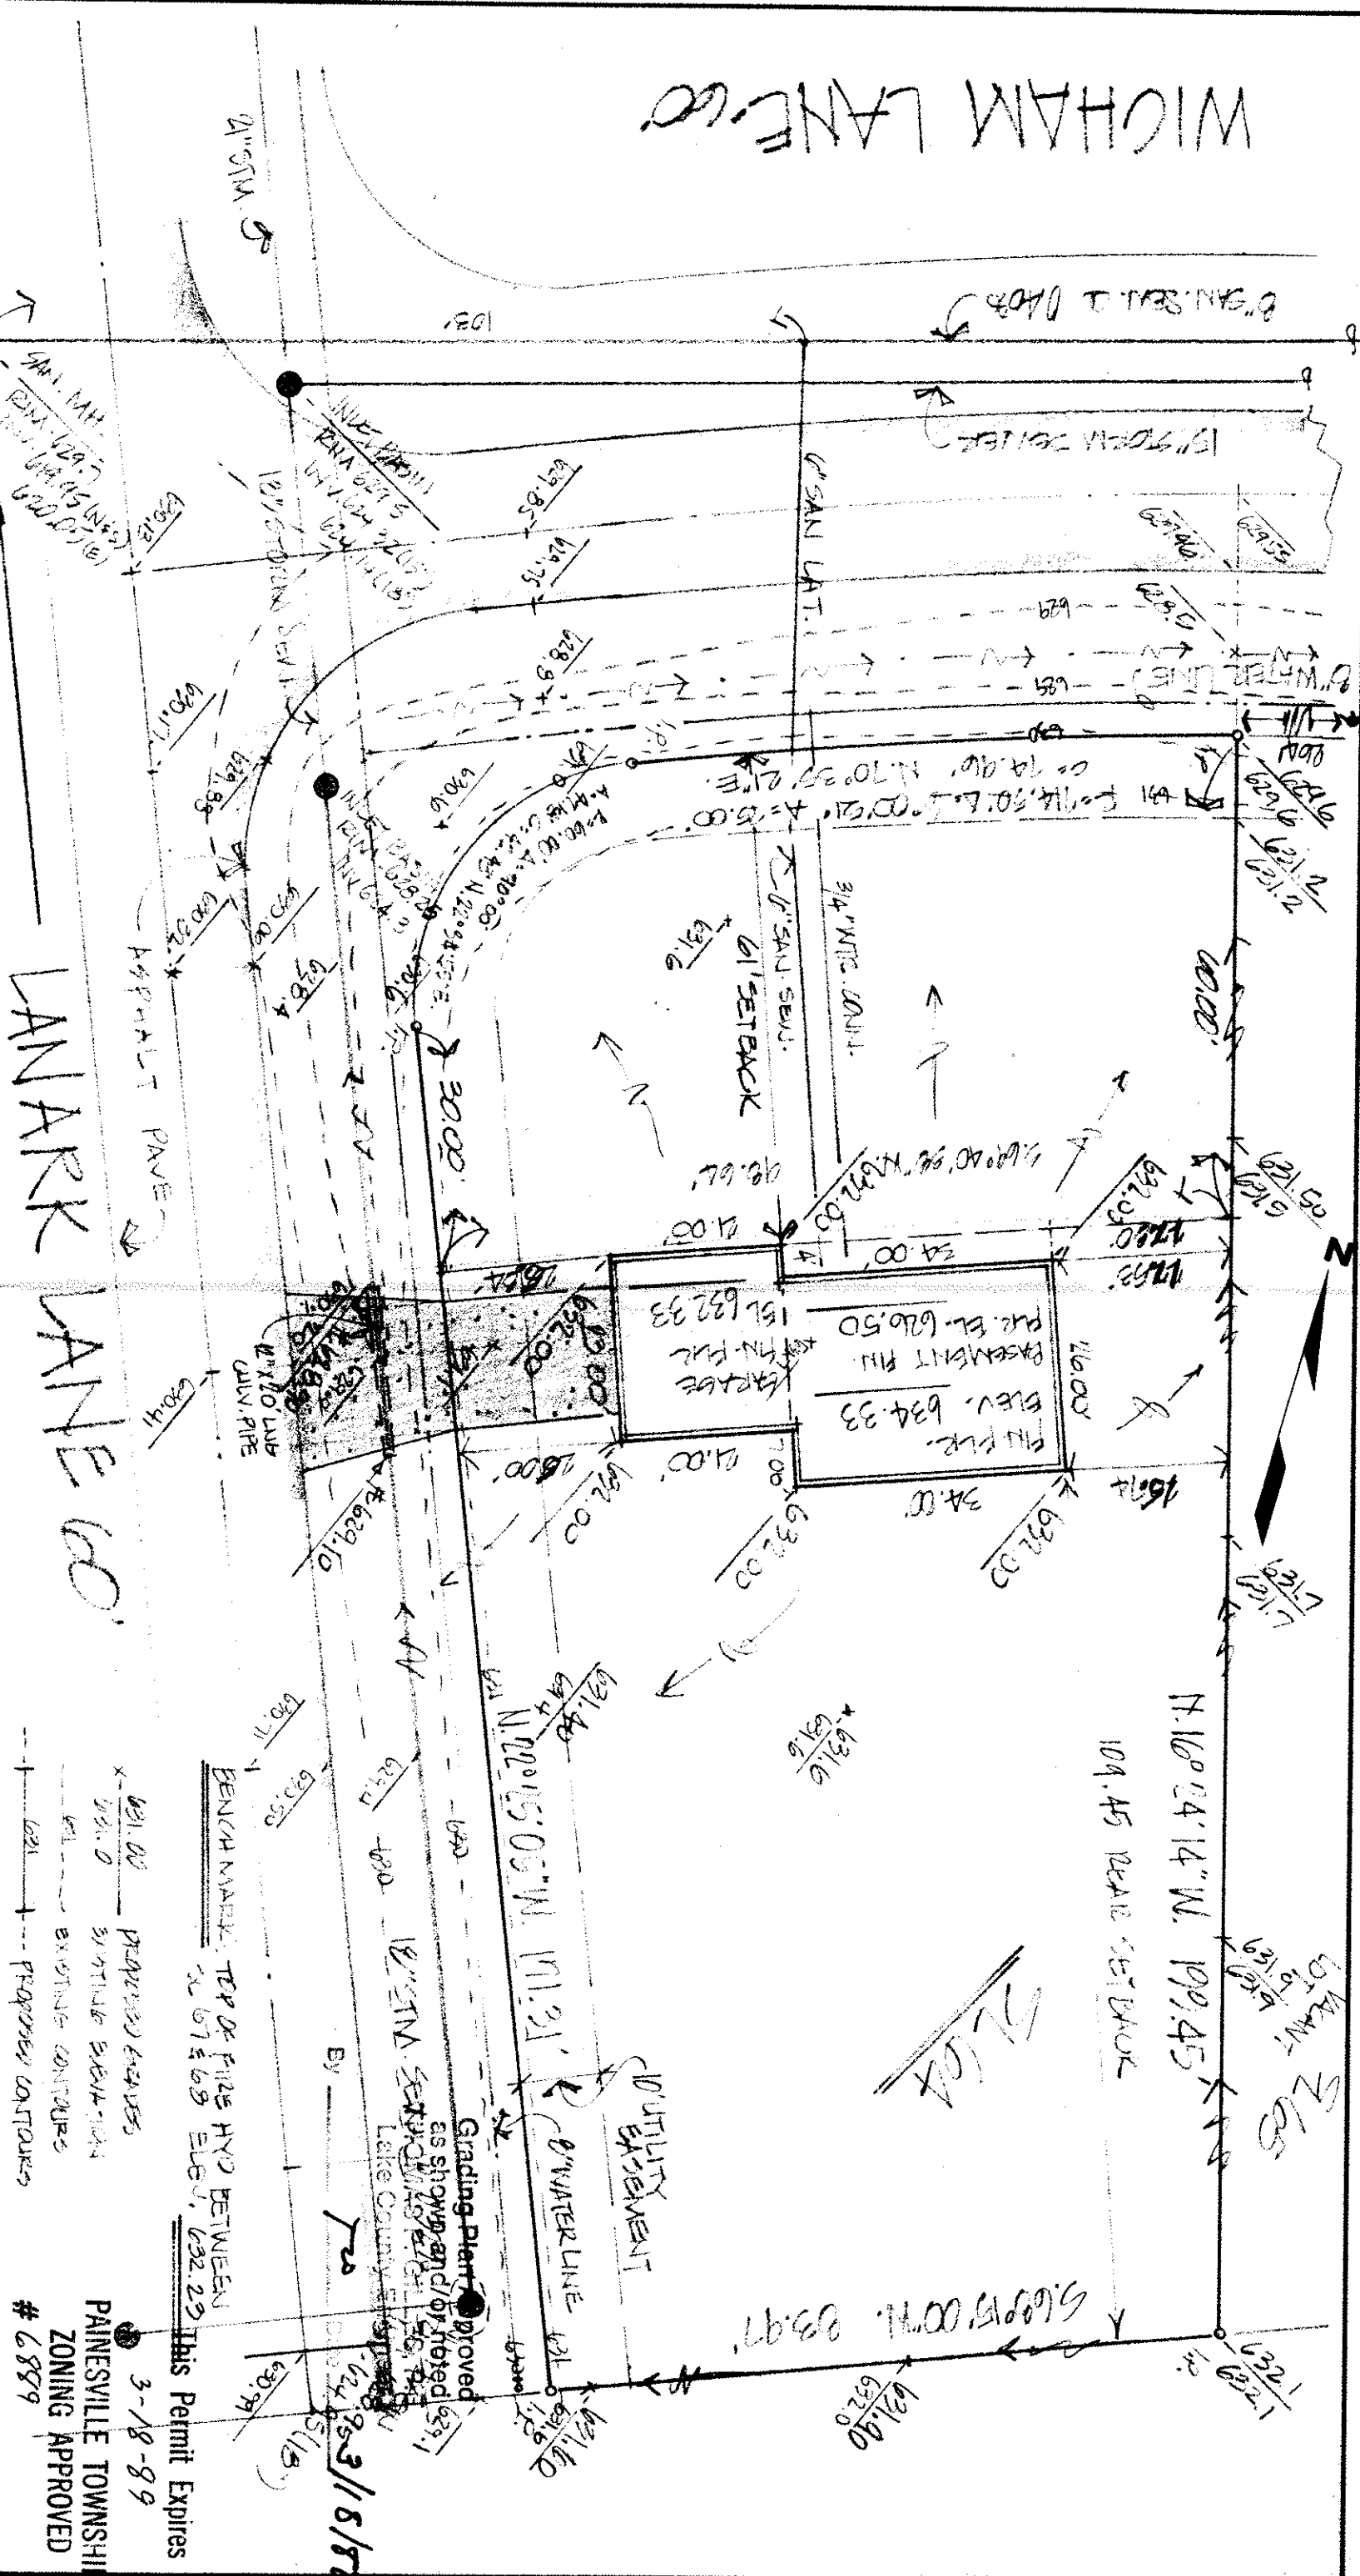

DESIGN CERTIFICATION

THIS PLAT WAS PREPARED BY ME, AND IS CORRECT TO THE BEST OF MY KNOWLEDGE AND BELIEF.

REG. SURVEYOR NO. 5244

AS BUILT CERTIFICATION

I HEREBY CERTIFY THAT THE CIRCLED GRADES ARE EXISTING FINISH GRADES CHECKED IN THE FIELD ON AND THAT SURVEY IS CORRECT TO THE BEST OF MY KNOWLEDGE AND BELIEF.

REG. SURVEYOR NO.



COLPETZER & WOODS
CONSULTANTS, INC.

9470 MENTOR AVENUE • MENTOR, OHIO 44060 • (216) 357-7569

DATE 3/10/85

SCALE 1" = 20'

DRAWN BY JWS

CHKD BY JWS

JOB NO. 18-150-64

PG.

SITE PLAN FOR:

EDWARD H. TRESEKER INC.

2100 DEEPWOOD BLVD., MENTOR, OHIO 44060
BEING SUBLOT NO. 64 IN THE DINES SUBDIVISION NO. 12 IN PAINEVILLE TOWNSHIP, OHIO.

Zoning Inspector

PAINEVILLE TOWNSHIP
ZONING APPROVED

6889

This Permit Expires 3-18-89

W. E. McLaughlin

BENCH MARK: TOP OF PIPE AND BETWEEN 2x67x68 ELEV. 632.29

Grading Plan as shown and/or noted

As shown and/or noted

As shown and/or noted

