


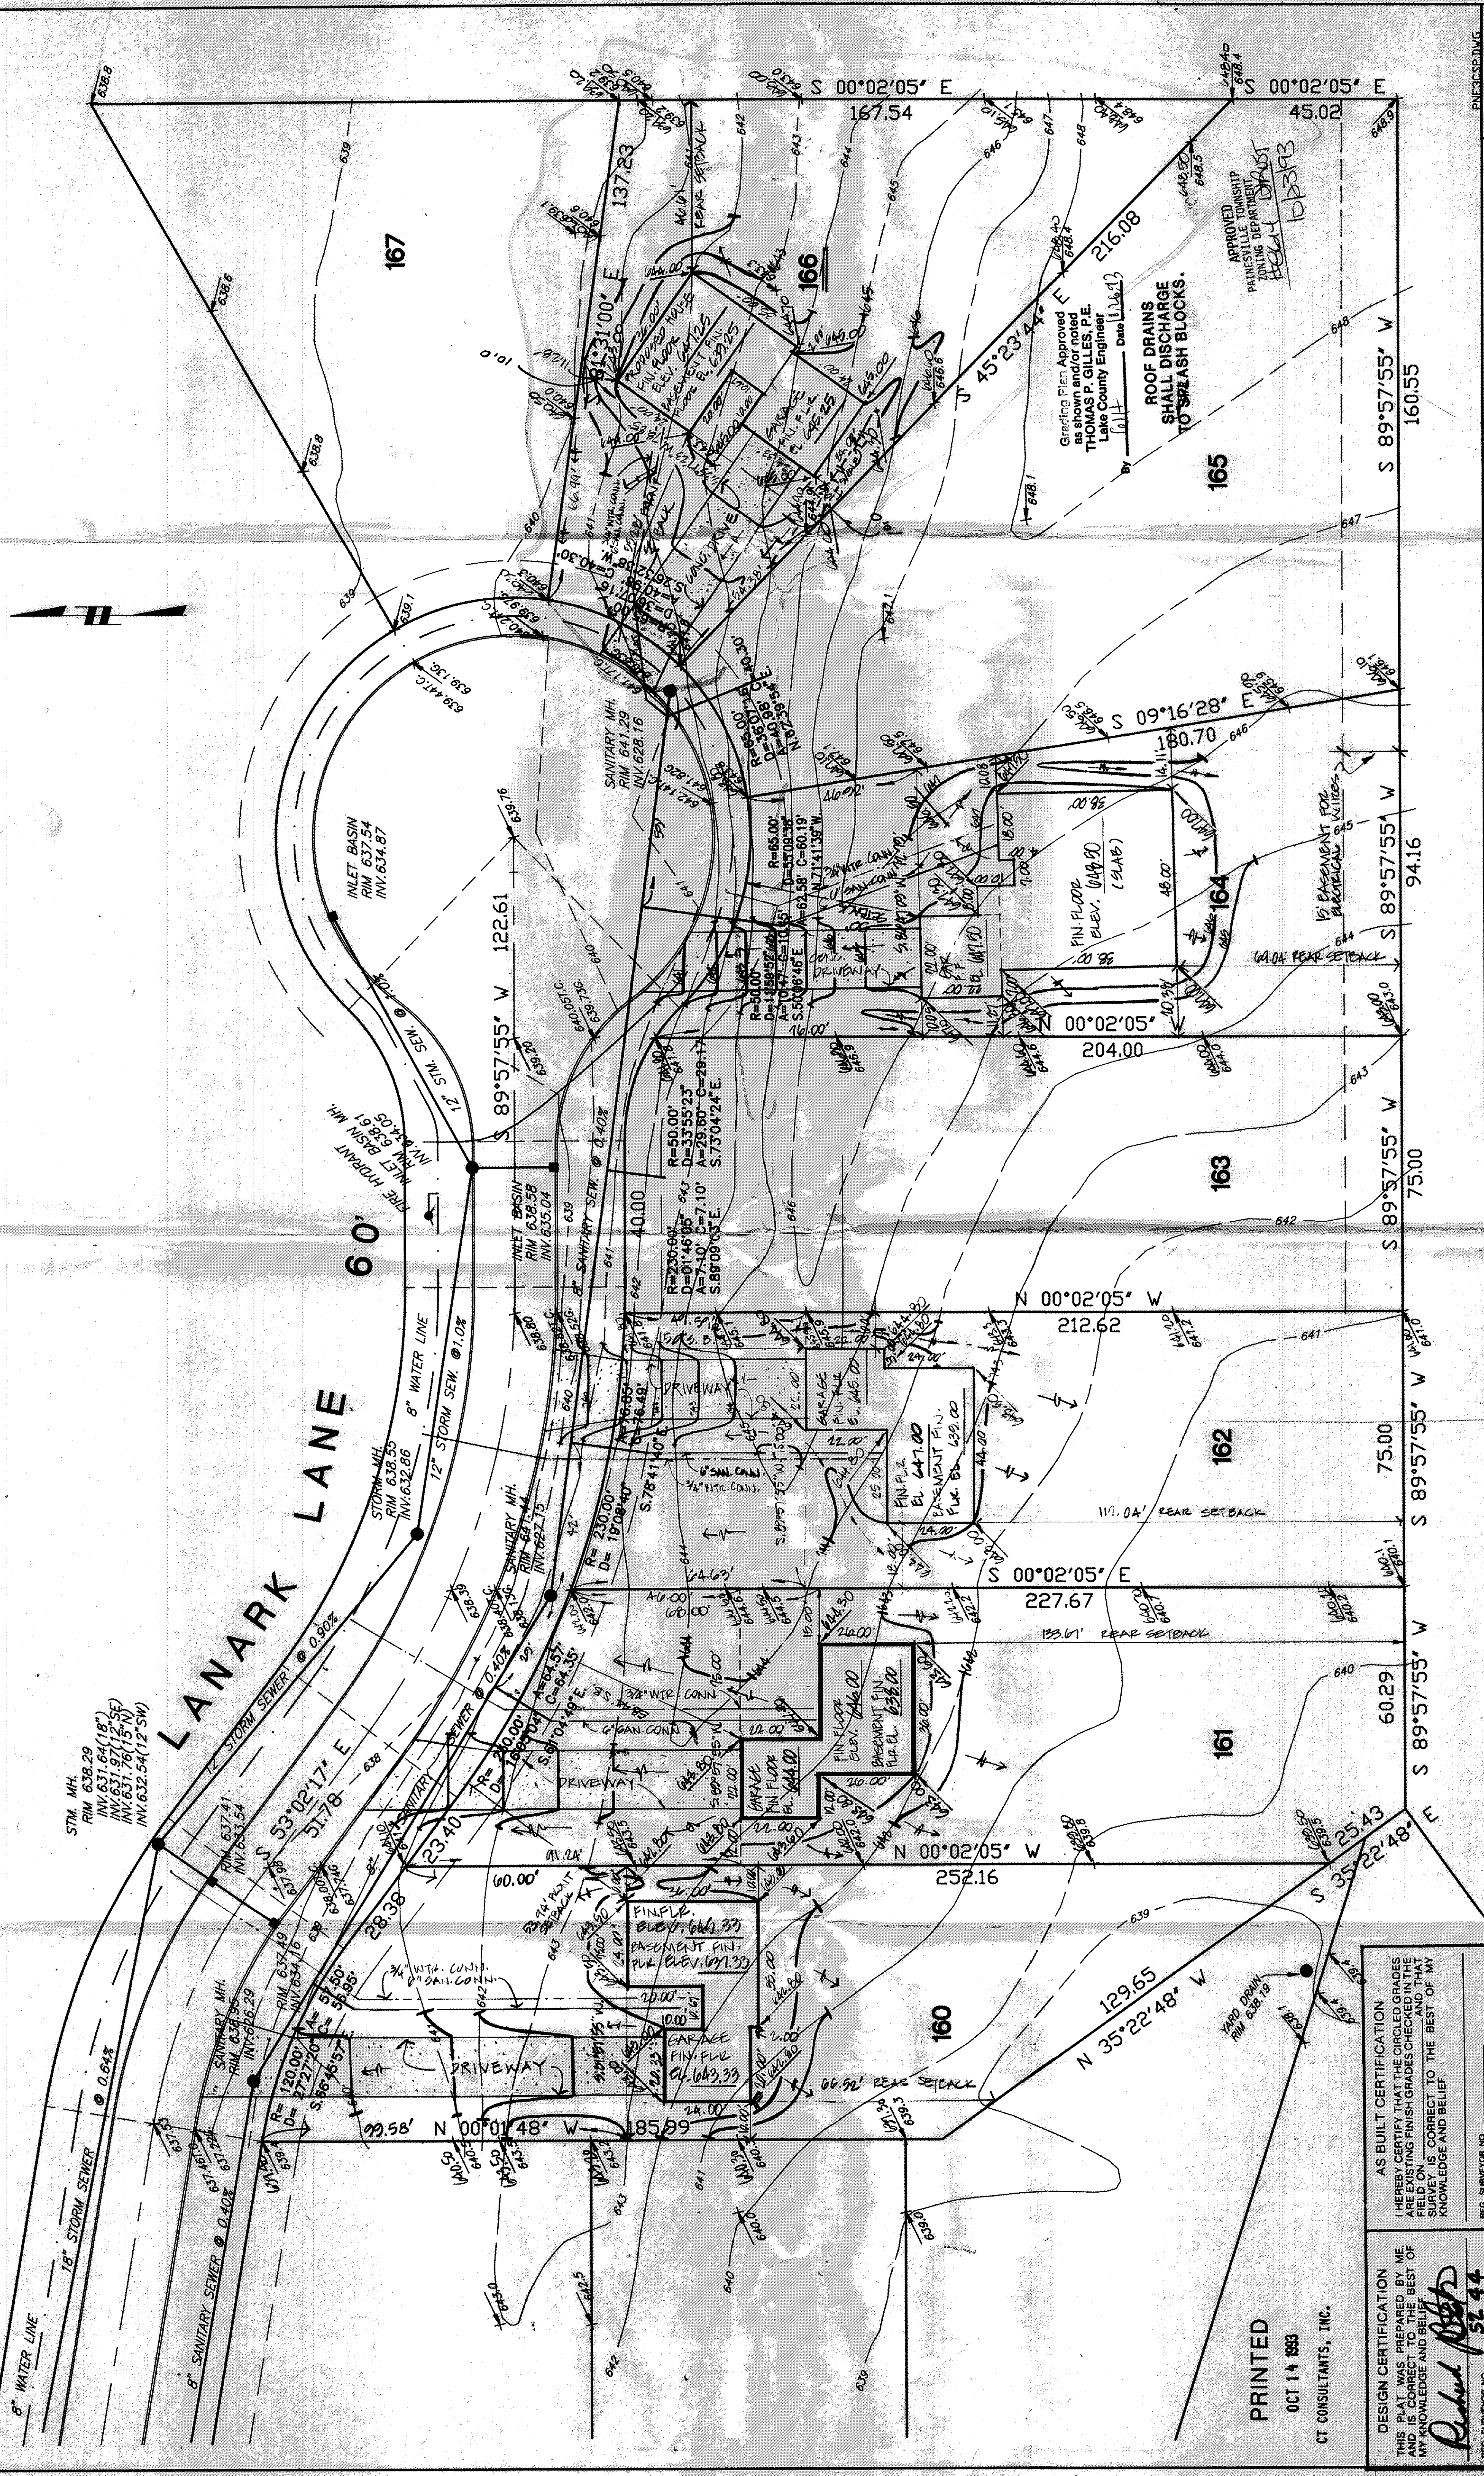

PRINTED
OCT 14 1993
CT CONSULTANTS, INC.

DESIGN CERTIFICATION
THIS PLAN WAS PREPARED BY ME,
AND IS CORRECT TO THE BEST OF
MY KNOWLEDGE AND BELIEF.

AS BUILT CERTIFICATION
I HEREBY CERTIFY THAT THE CIRCLED GRADES
ARE EXISTING FINISH GRADES CHECKED IN THE
FIELD ON 9/22/93 AND THAT
THE SURVEY IS CORRECT TO THE BEST OF MY
KNOWLEDGE AND BELIEF.

Richard B. B...
REG. SURVEYOR NO. 5144

CT Consultants, Inc.
Engineers • Architects • Planners

REV.	DESCRIPTION	DATE	BY	CHKD.
1	SITE PLAN FOR SL 162	10/22/93	C.S.	
2	SITE PLAN FOR SL 164	11/27/93	C.S.	
3	SITE PLAN FOR SL 160	9/22/93	C.S.	
4	SITE PLAN FOR SL 160	11/27/93	C.S.	

EDWARD H. TRESGER, INC.
8100 DEEPWOOD BOULEVARD

SITE PLAN FOR
SUBLOT NO. 160
IN THE PINES SUBDIVISION PHASE III-C

DATE:	JAN. 1992
DRAWN BY:	C.D.B.
CHECKED BY:	

PN3332.DWG
SCALE:
HORIZ. 1" = 20'
VERT. 1" = 20'
CONTRACT NO.
89-160
SHEET NO.