


CT Consultants, Inc.
Engineers • Architects • Planners
Milwaukee • Mentor • Columbus • Lorain • North Canton • Youngstown

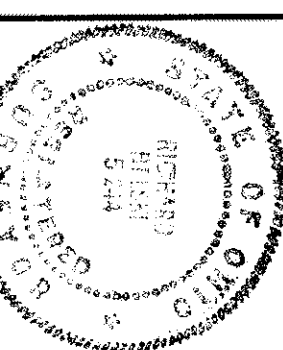

REV.	DESCRIPTION	DATE	BY	CHK'D.
1	SITE PLAN FOR SUB 162	6/26/92	CT	CT
2	SITE PLAN FOR SUB 164	7/15/92	CT	CT
3	SITE PLAN FOR SUB 160	9/25/92	CT	CT
4	SITE PLAN FOR SUB 160	7/15/93	CT	CT
5	SITE PLAN FOR SUB 166	10/14/93	CT	CT

EDWARD H. TRESGGER, INC.
8100 DEEPWOOD BOULEVARD
MENTOR, OHIO 44060

**SITE PLAN FOR
SUBLOT NO. 165**
IN THE PINES SUBDIVISION PHASE III-C
IN PAINESVILLE TOWNSHIP, OHIO.

SCALE	DATE	BY	CHK'D.
1" = 20'	JAN. 1992	CT	CT
CONTRACT NO.	2-7-479		
SHEET NO.	2		

DESIGN CERTIFICATION
THIS PLAN WAS PREPARED BY ME
OR UNDER MY CLOSE PERSONAL
SUPERVISION AND I AM A
REGISTERED PROFESSIONAL
ENGINEER IN THE STATE OF OHIO.
I HEREBY CERTIFY THAT THE
EXISTING FINISH GRADES
CHECKED IN THE
FIELD ON
SURVEY IS CORRECT TO THE
BEST OF MY
KNOWLEDGE AND BELIEF.

AS BUILT CERTIFICATION
I HEREBY CERTIFY THAT THE
EXISTING FINISH GRADES
CHECKED IN THE
FIELD ON
SURVEY IS CORRECT TO THE
BEST OF MY
KNOWLEDGE AND BELIEF.

REG. SURVEYOR NO. 52,44
REG. SURVEYOR NO.

REG. SURVEYOR NO. 52,44
REG. SURVEYOR NO.

REG. SURVEYOR NO. 52,44
REG. SURVEYOR NO.

