


CT Consultants, Inc.
Engineers • Architects • Planners
Milwaukee • Kansas • Columbus • Toledo • North Canton • Youngstown

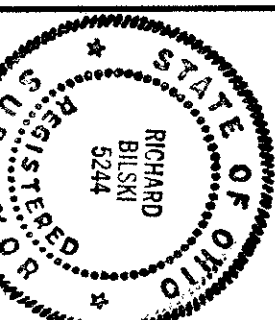

REV.	DESCRIPTION	DATE	BY	CHK'D.
1.	SITE PLAN FOR BL 162	6-26-92	C.B.	

EDWARD H. TRESGER, INC.
8100 DEEPWOOD BOULEVARD
MENTOR OHIO 44060

DATE	INT'D.
JAN. 1992	


SITE PLAN FOR
SUBLOT NO. 162
IN THE PINES SUBDIVISION PHASE III-C
IN PAINESVILLE TOWNSHIP, OHIO

DATE	SCALE
JAN. 1992	1" = 20'

DESIGN CERTIFICATION
THIS PLAN WAS PREPARED BY ME
AND IS CORRECT TO THE BEST OF
MY KNOWLEDGE AND BELIEF.

AS BUILT CERTIFICATION
I HEREBY CERTIFY THAT THE CIRCLED GRADES
ARE EXISTING FINISH GRADES CHECKED IN THE
FIELD ON _____ AND THAT
SURVEY IS CORRECT TO THE BEST OF MY
KNOWLEDGE AND BELIEF.

REG. SURVEYOR NO. _____
REG. SURVEYOR NO. _____

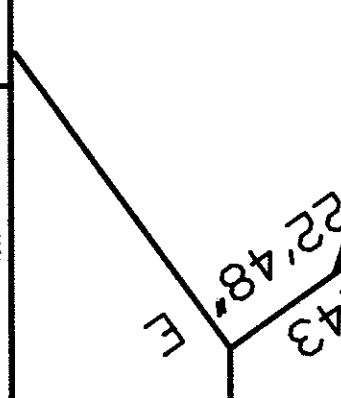

REV.	DESCRIPTION	DATE	BY	CHK'D.
1.	SITE PLAN FOR BL 162	6-26-92	C.B.	

EDWARD H. TRESGER, INC.
8100 DEEPWOOD BOULEVARD
MENTOR OHIO 44060

DATE	INT'D.
JAN. 1992	

SITE PLAN FOR
SUBLOT NO. 162
IN THE PINES SUBDIVISION PHASE III-C
IN PAINESVILLE TOWNSHIP, OHIO

DATE	SCALE
JAN. 1992	1" = 20'

