


APPROVED
PAINESVILLE TOWNSHIP
ZONING DEPARTMENT

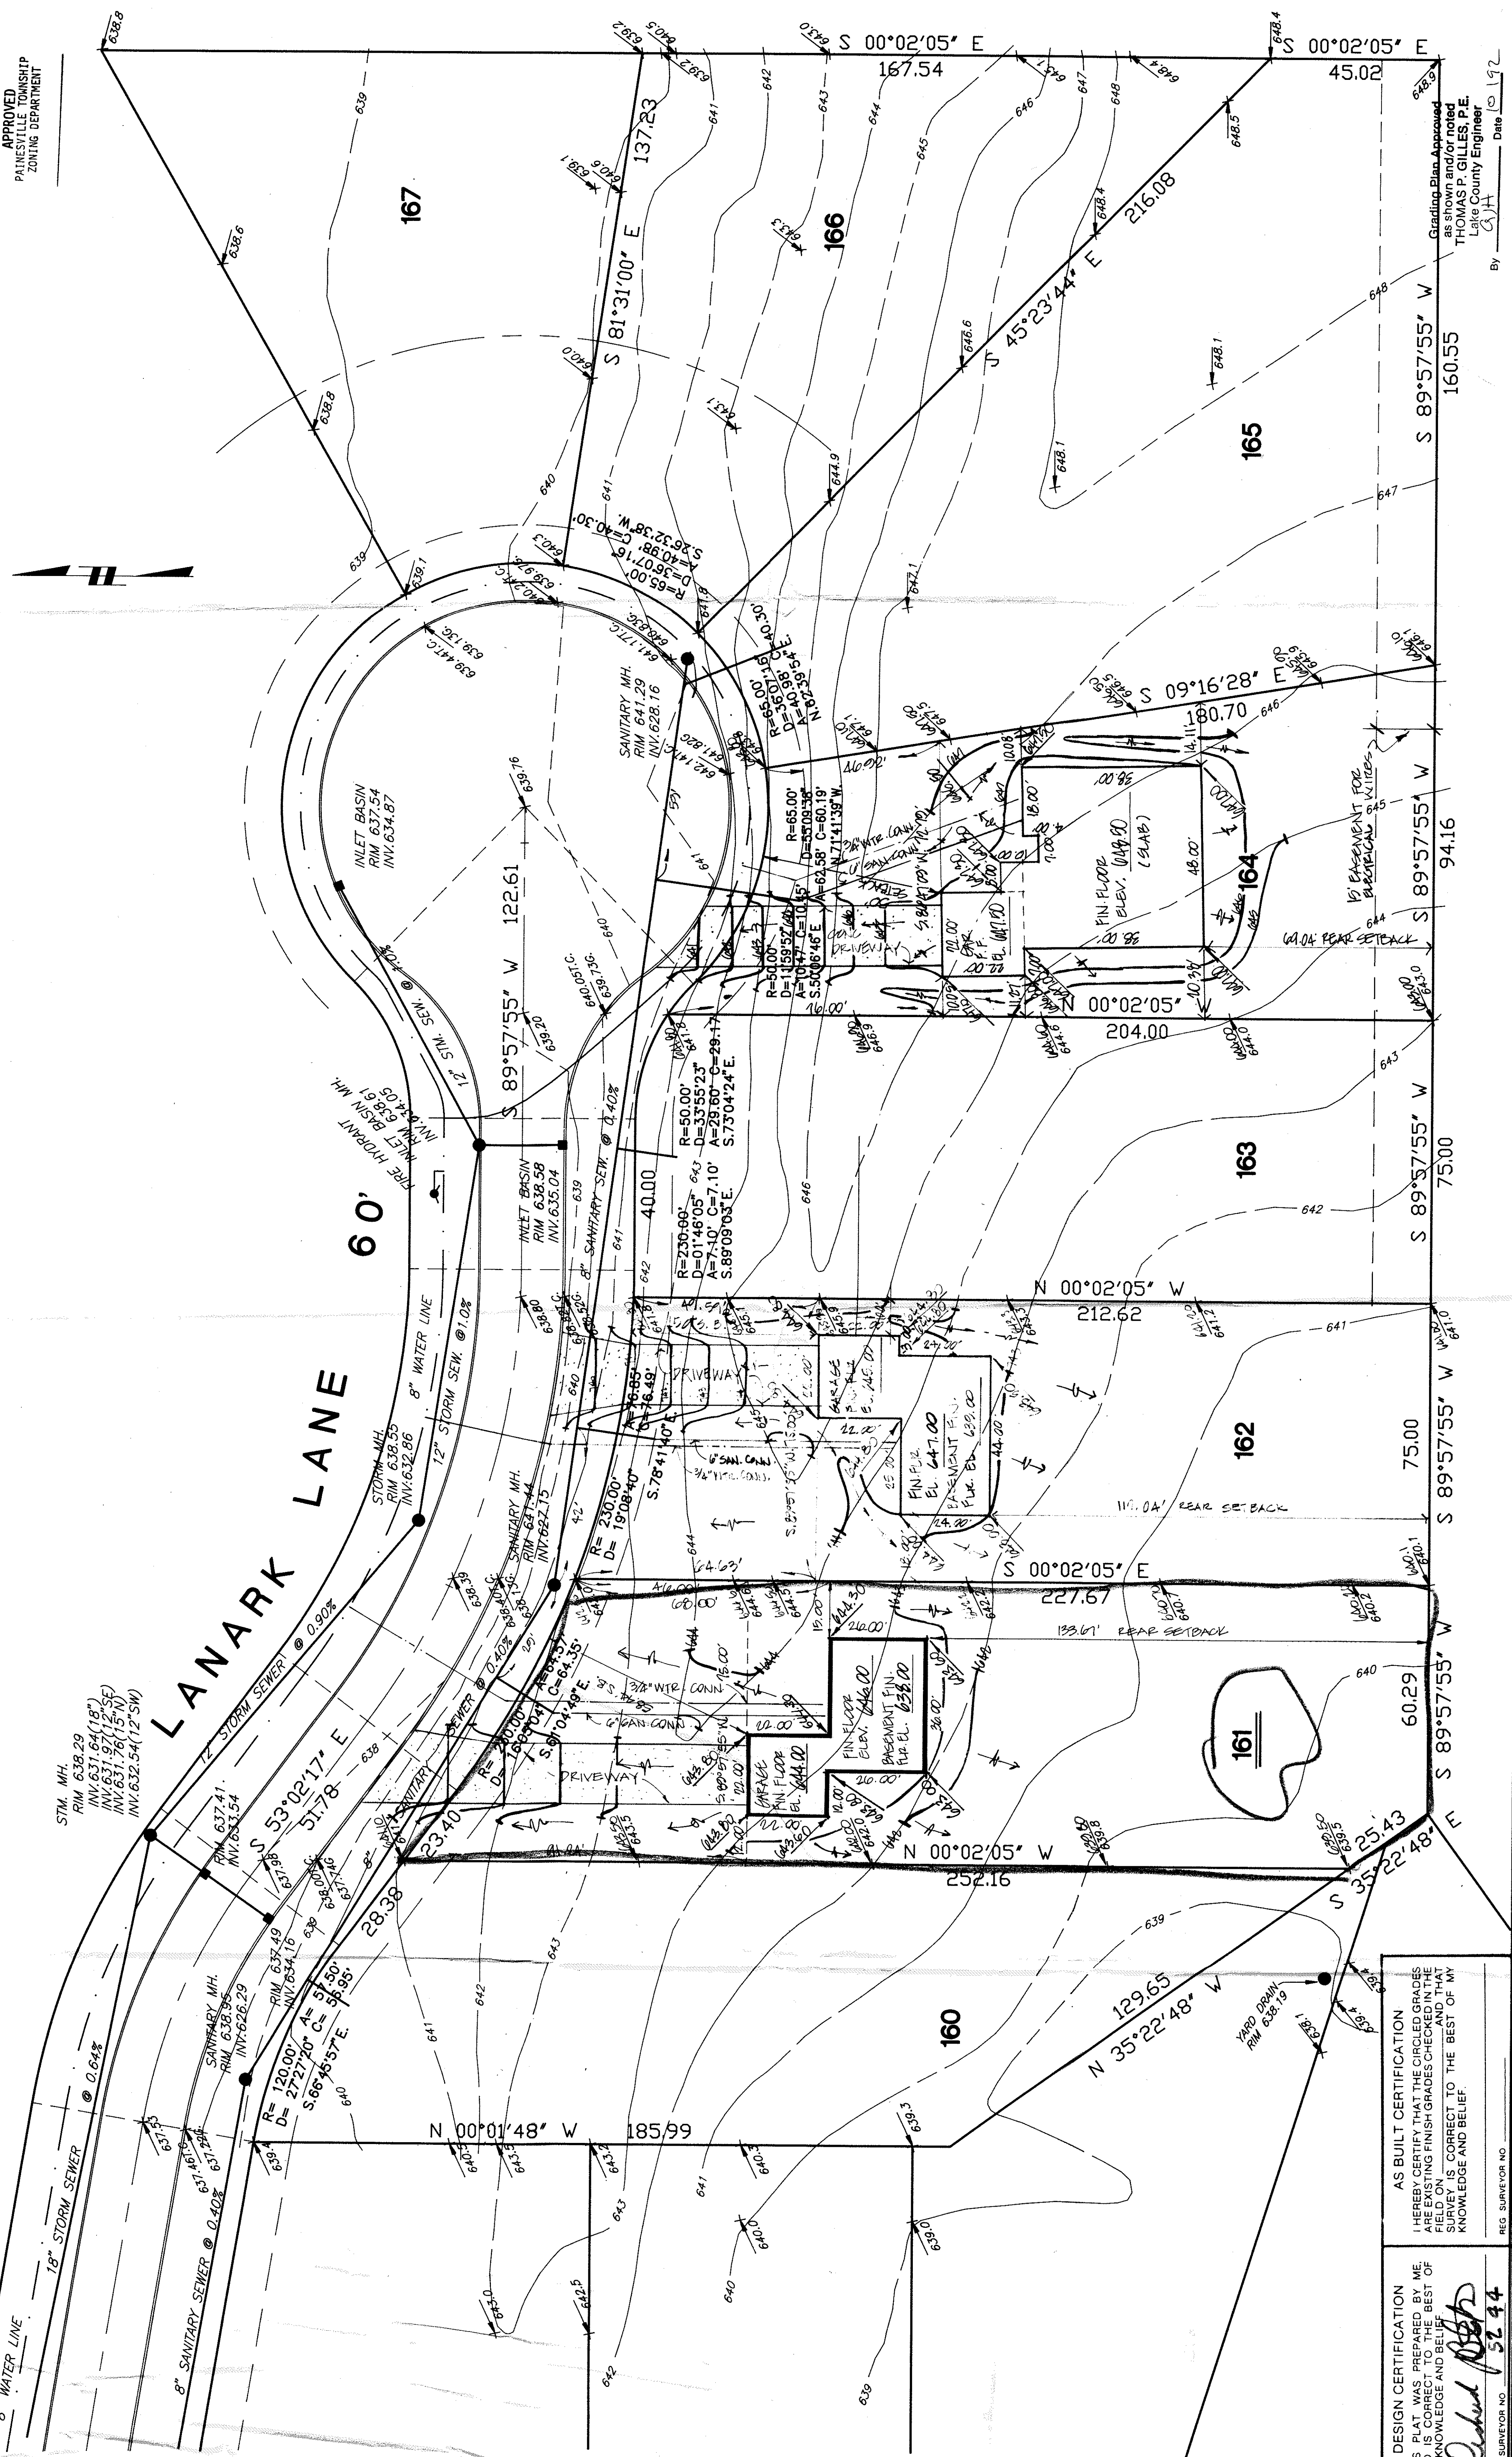


DESIGN CERTIFICATION
THIS PLAN WAS PREPARED BY ME
AND IS CORRECT TO THE BEST OF
MY KNOWLEDGE AND BELIEF.

AS BUILT CERTIFICATION
I HEREBY CERTIFY THAT THE CIRCLED GRADES
ARE EXISTING FINISH GRADES CHECKED IN THE
FIELD ON CORRECTED TO THE BEST OF MY
KNOWLEDGE AND BELIEF.

REG. SURVEYOR NO. 5244
Richard B. Bick

CT Consultants, Inc.
Engineers • Architects • Planners
Willoughby • Mentor • Columbus • Lorain • North Canton • Youngstown

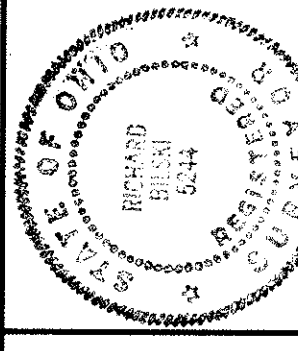

REV.	DESCRIPTION	DATE	BY	CHKD.
1	DATE PLAN FOR SUB 162	6-26-92	C.B.	
2	SITE PLAN FOR LOT 164	7-23-92	C.B.	
3	SITE PLAN FOR LOT 161	9-20-92	C.B.	

EDWARD H. TRESGER, INC.
8100 DEEPWOOD BOULEVARD
MENTOR, OHIO 44060

DATE: JAN. 1992
DRAWN BY: C.D.B.
CHECKED BY:
APPROVED BY:

**SITE PLAN FOR
SUBLOT NO. 161
IN THE PINES SUBDIVISION PHASE III-C**

Grading Plan Approved
as shown and/or noted
THOMAS P. GILLES, P.E.
Lake County Engineer

By: *TPG* Date: 1-19-92

PN-323SR.DWG
SHEET NO. 161 OF 161