


BY: Timothy P. Hadden
I HEREBY CERTIFY THAT THIS PLAN WAS PREPARED BY ME AND IS CORRECT TO THE BEST OF MY KNOWLEDGE AND BELIEF.

CERTIFICATION:

This Permit Expires 4-2-92
PAINESVILLE TOWNSHIP
ZONING APPROVED LANK
7738
Zoning Inspector DPH

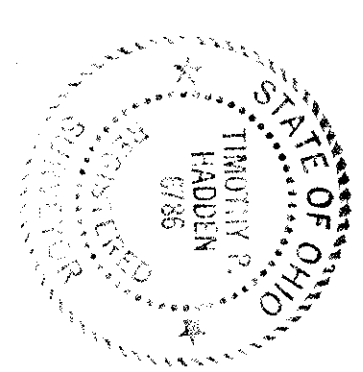


LANK LANE
60'

Grading Plan Approved

as shown and
THOMAS D. C.
Leban County Engineer

DATE 4-2-92
Discharge Sump pump
to storm sewer

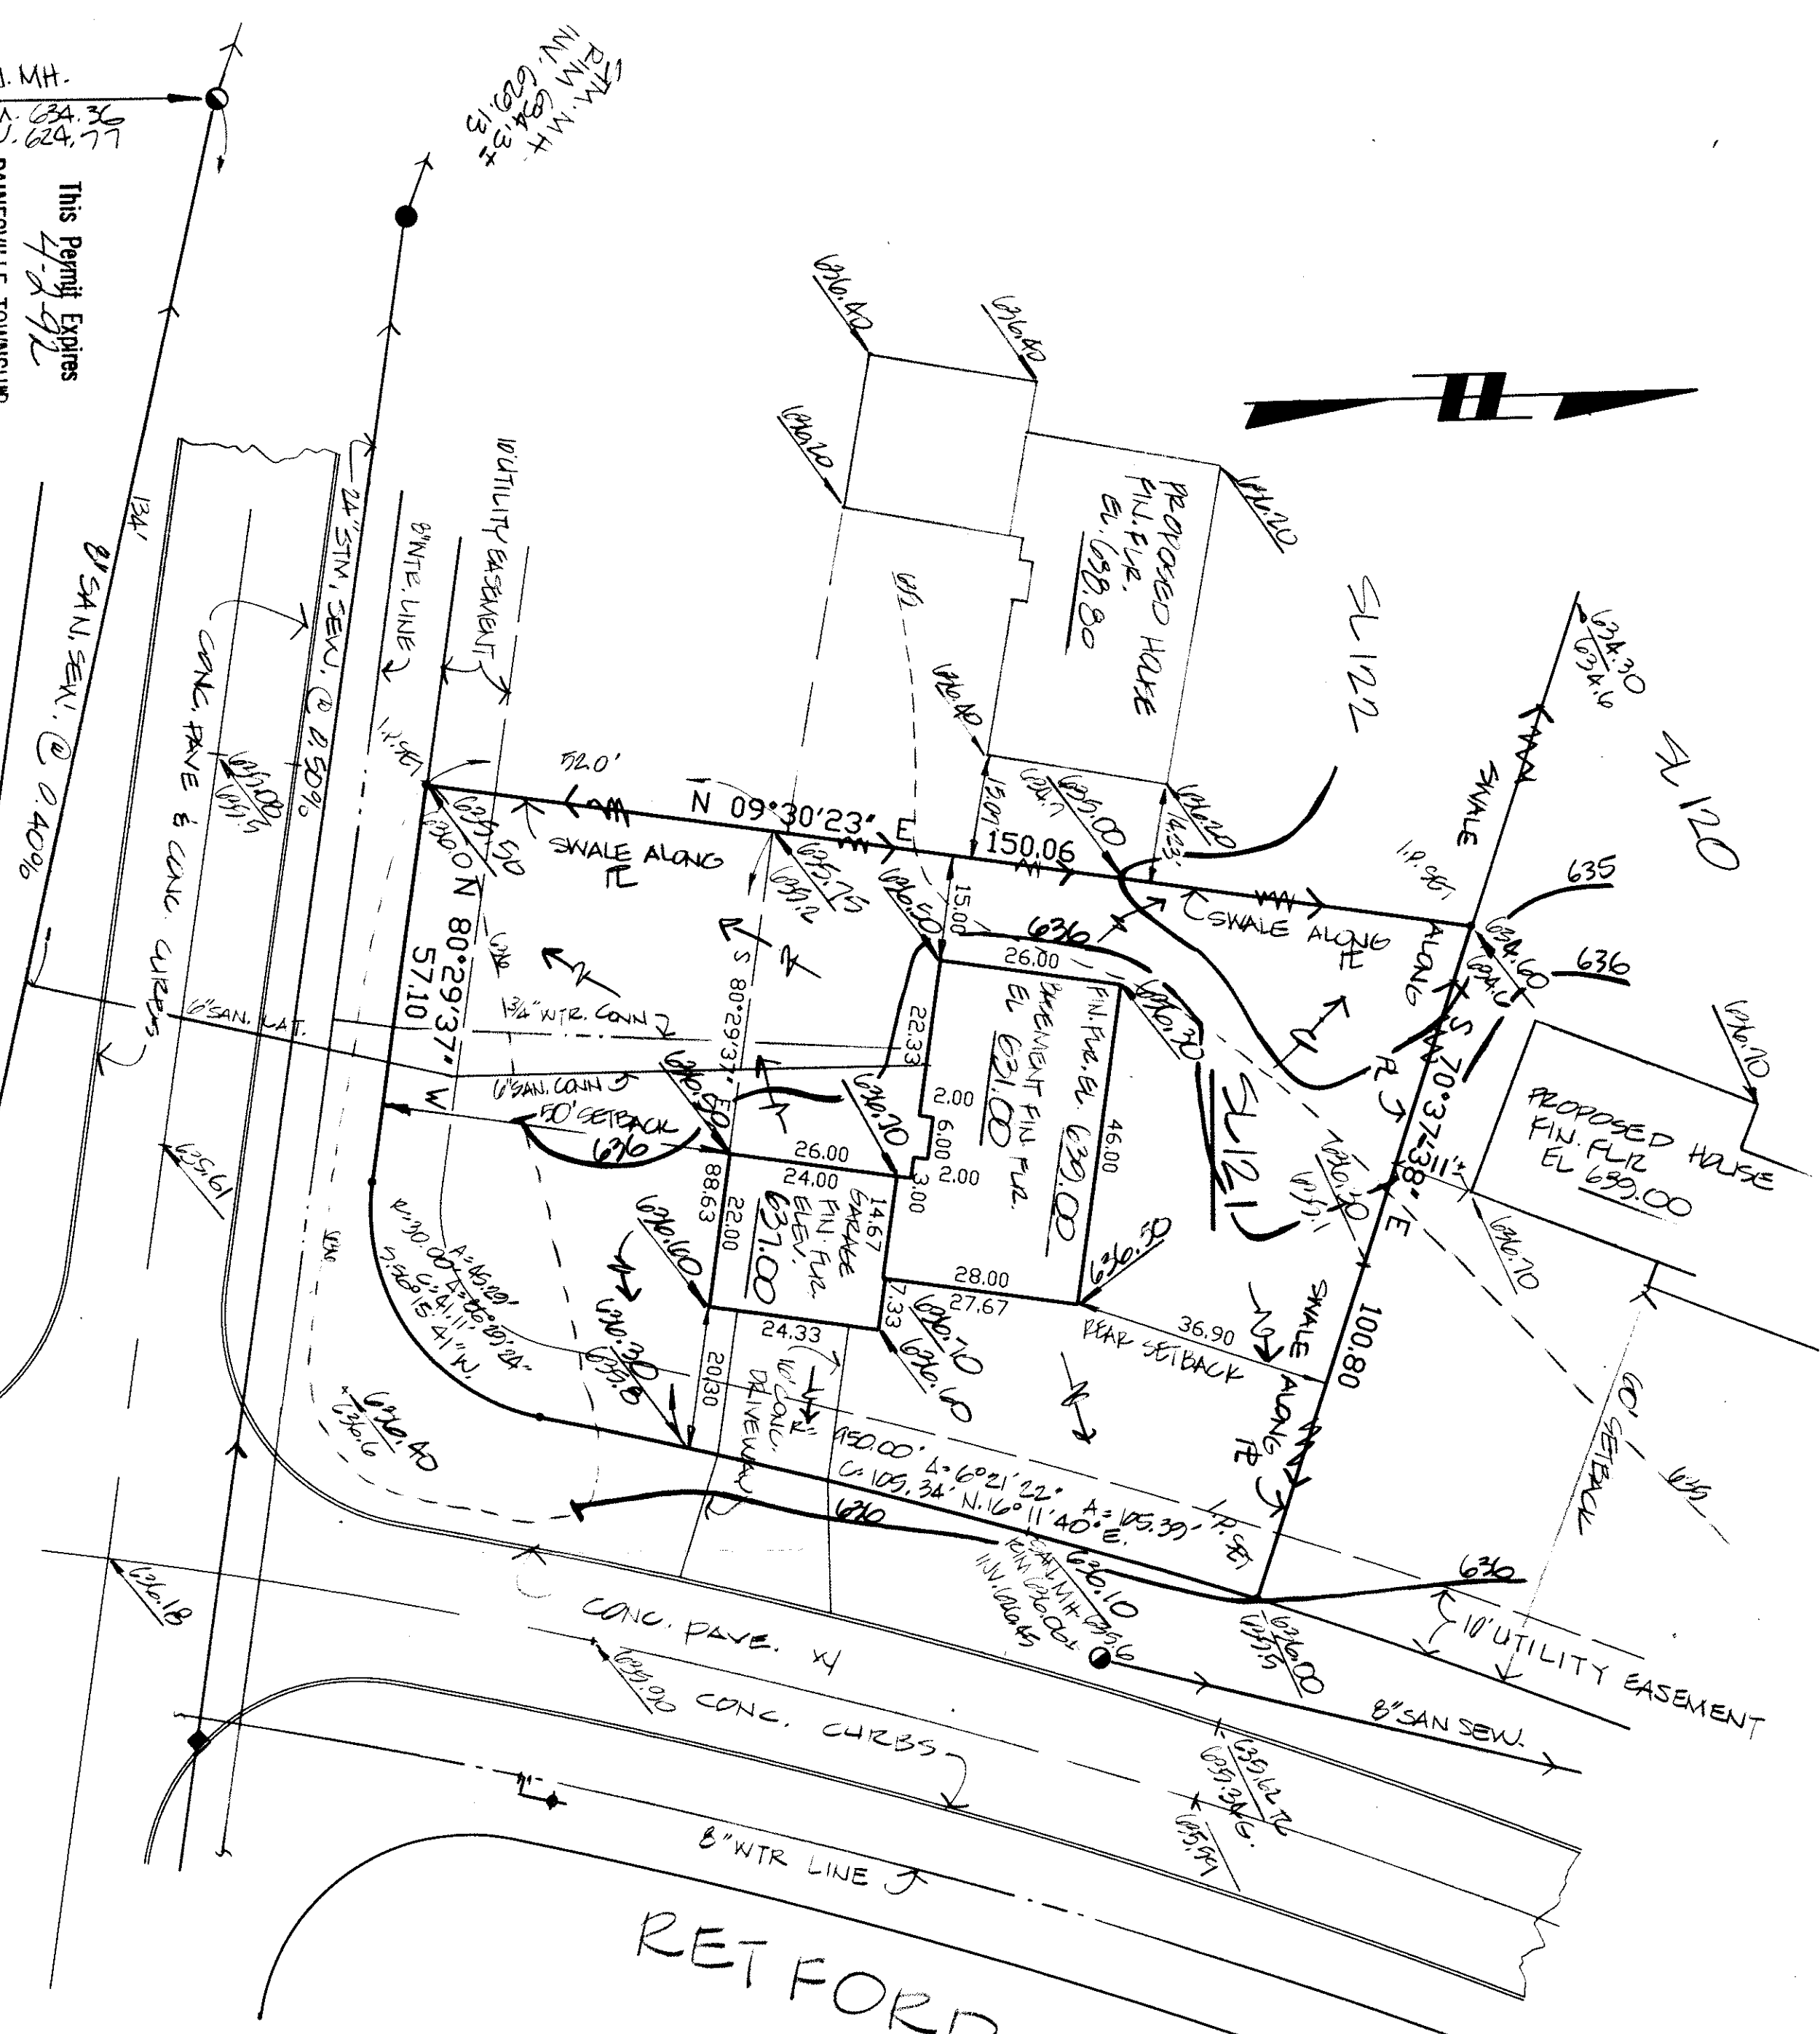

RET FORD PARKWAY 60'

636.00 PROPOSED GRADES
636.00 EXISTING ELEVATIONS
636.00 EXISTING CONTOURS
636.00 PROPOSED CONTOURS

BENCH MARK:
DEIN MARK AT
INTERSECTION OF RET FORD PARKWAY
AND SHEPHERD TRL.
E.L. 634.14

SITE PLAN FOR **EDWARD H. TRESSELER, INC.**
6100 DESPOND BLVD. MENTOR, OHIO 44060
PAINESVILLE TOWNSHIP, OHIO

CT Consultants, Inc.
Engineers • Architects • Planners
Millsburg • Mentor • Columbus • Lorain • North Canton • Steubenville

DATE 4-2-92
SCALE 1"=20'
DRAWN BY DB
CHECKED BY DB
F&E 1071, pg. 915

SHEET **1** OF 1
CONTRACT NO. 83-478