

BUXTON CIRCLE

SAN. MH.
ELEV. 630.56 (BENCH MARK)
INV. 621.61

LANE 60'

40' TO FIRE HYD.

8" WATER LINE
18" STIM. SEW.

LANARK




WICKHAM PLACE

Grading Plan Approved
as shown and/or noted
THOMAS P. GILLES, P.E.
Lake County Engineer

- By GJH Date 7/2/00
1. CONNECT Sump pump TO INLET BASIN.
 2. SWALE ROADSIDE DITCH TO INLET BASIN AS SHOWN.

This Permit Expires 6/27/01
PAINESVILLE TOWNSHIP
ZONING APPROVED
7560 Dgm
Zoning inspector

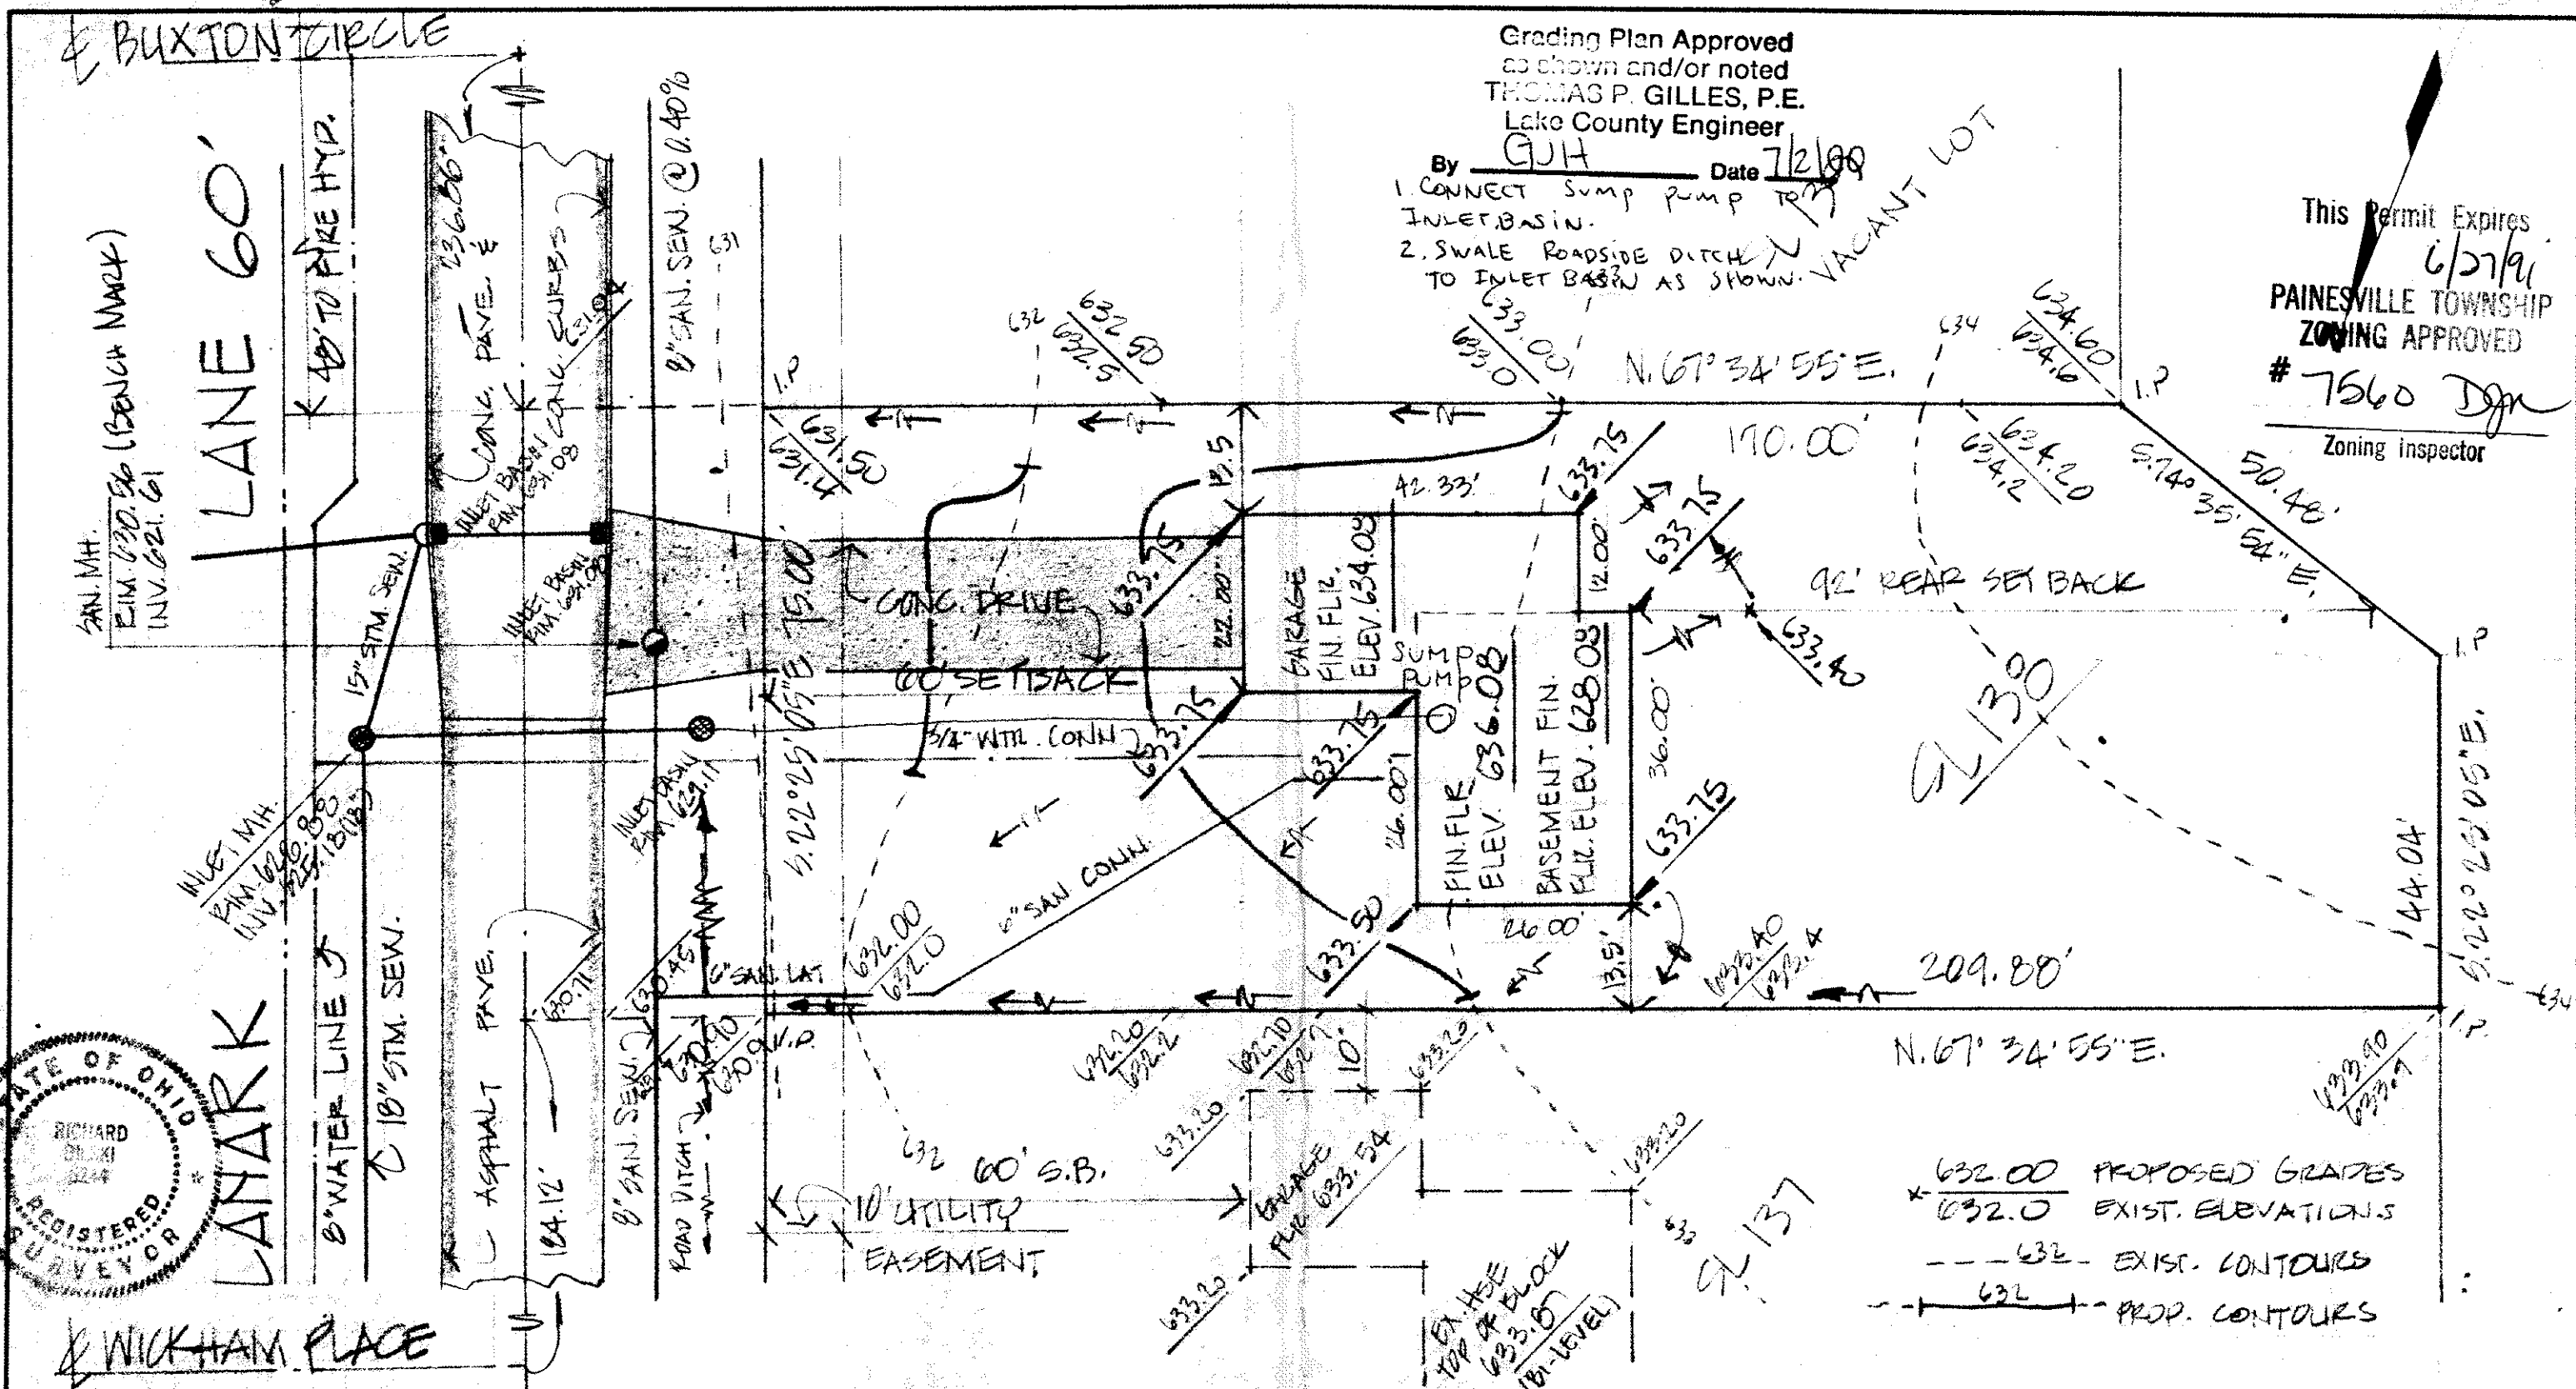

* 632.00 PROPOSED GRADES
* 632.0 EXIST. ELEVATIONS
--- 632 --- EXIST. CONTOURS
--- 632 --- PROP. CONTOURS

DESIGN CERTIFICATION

THIS PLAT WAS PREPARED BY ME, AND IS CORRECT TO THE BEST OF MY KNOWLEDGE AND BELIEF.

REG. SURVEYOR NO. 5244

AS BUILT CERTIFICATION

I HEREBY CERTIFY THAT THE CIRCLED GRADES ARE EXISTING FINISH GRADES CHECKED IN THE FIELD ON _____ AND THAT SURVEY IS CORRECT TO THE BEST OF MY KNOWLEDGE AND BELIEF.

REG. SURVEYOR NO. _____

CT Consultants, Inc.
Engineers • Architects • Planners
Willoughby • Mentor • Columbus • Lorain • North Canton • Steubenville

DATE JUNE 25, 1990
SCALE 1" = 20'
DRAWN BY CB
CHKD BY _____
JOB NO. 81-478
FB 707 PG 85

SITE PLAN FOR:
EDWARD H. TRESGER, INC.
8100 DEERWOOD BLVD., MENTOR, OHIO
BEING SUBLOT NO. 138 IN THE PINES SUBDIVISION
PHASE III-B IN PAINESVILLE TWP., OHIO