

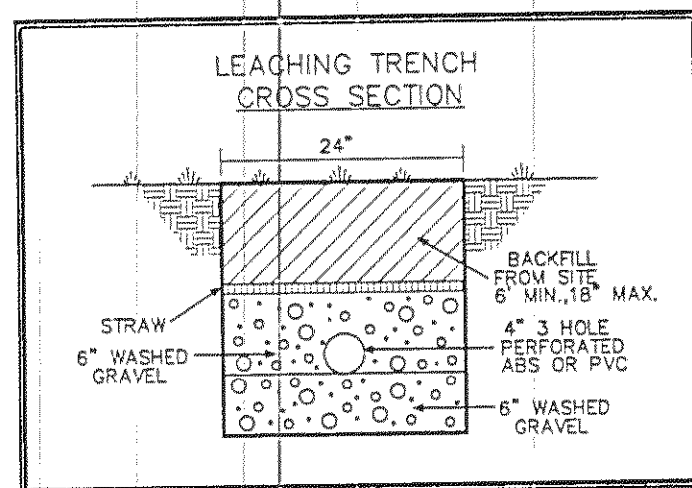


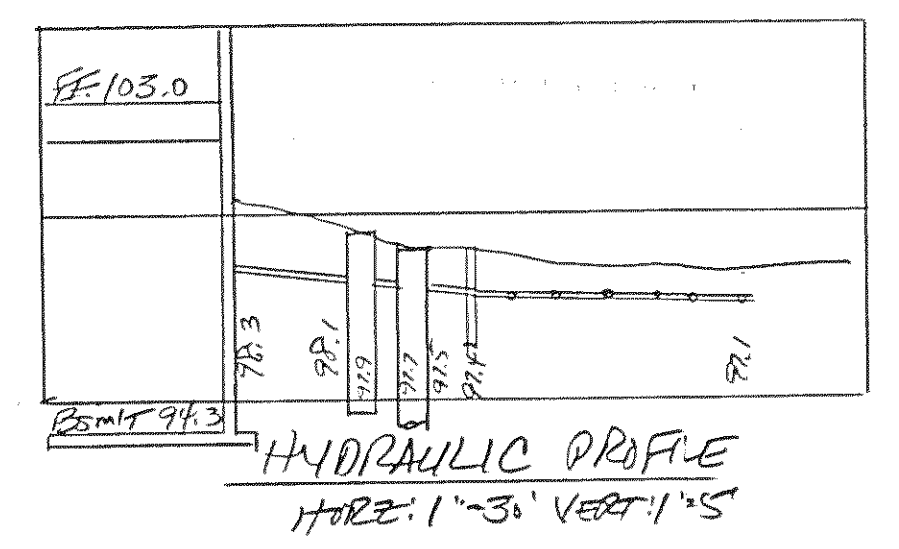

DONALD CRAWFORD
3A-5-12

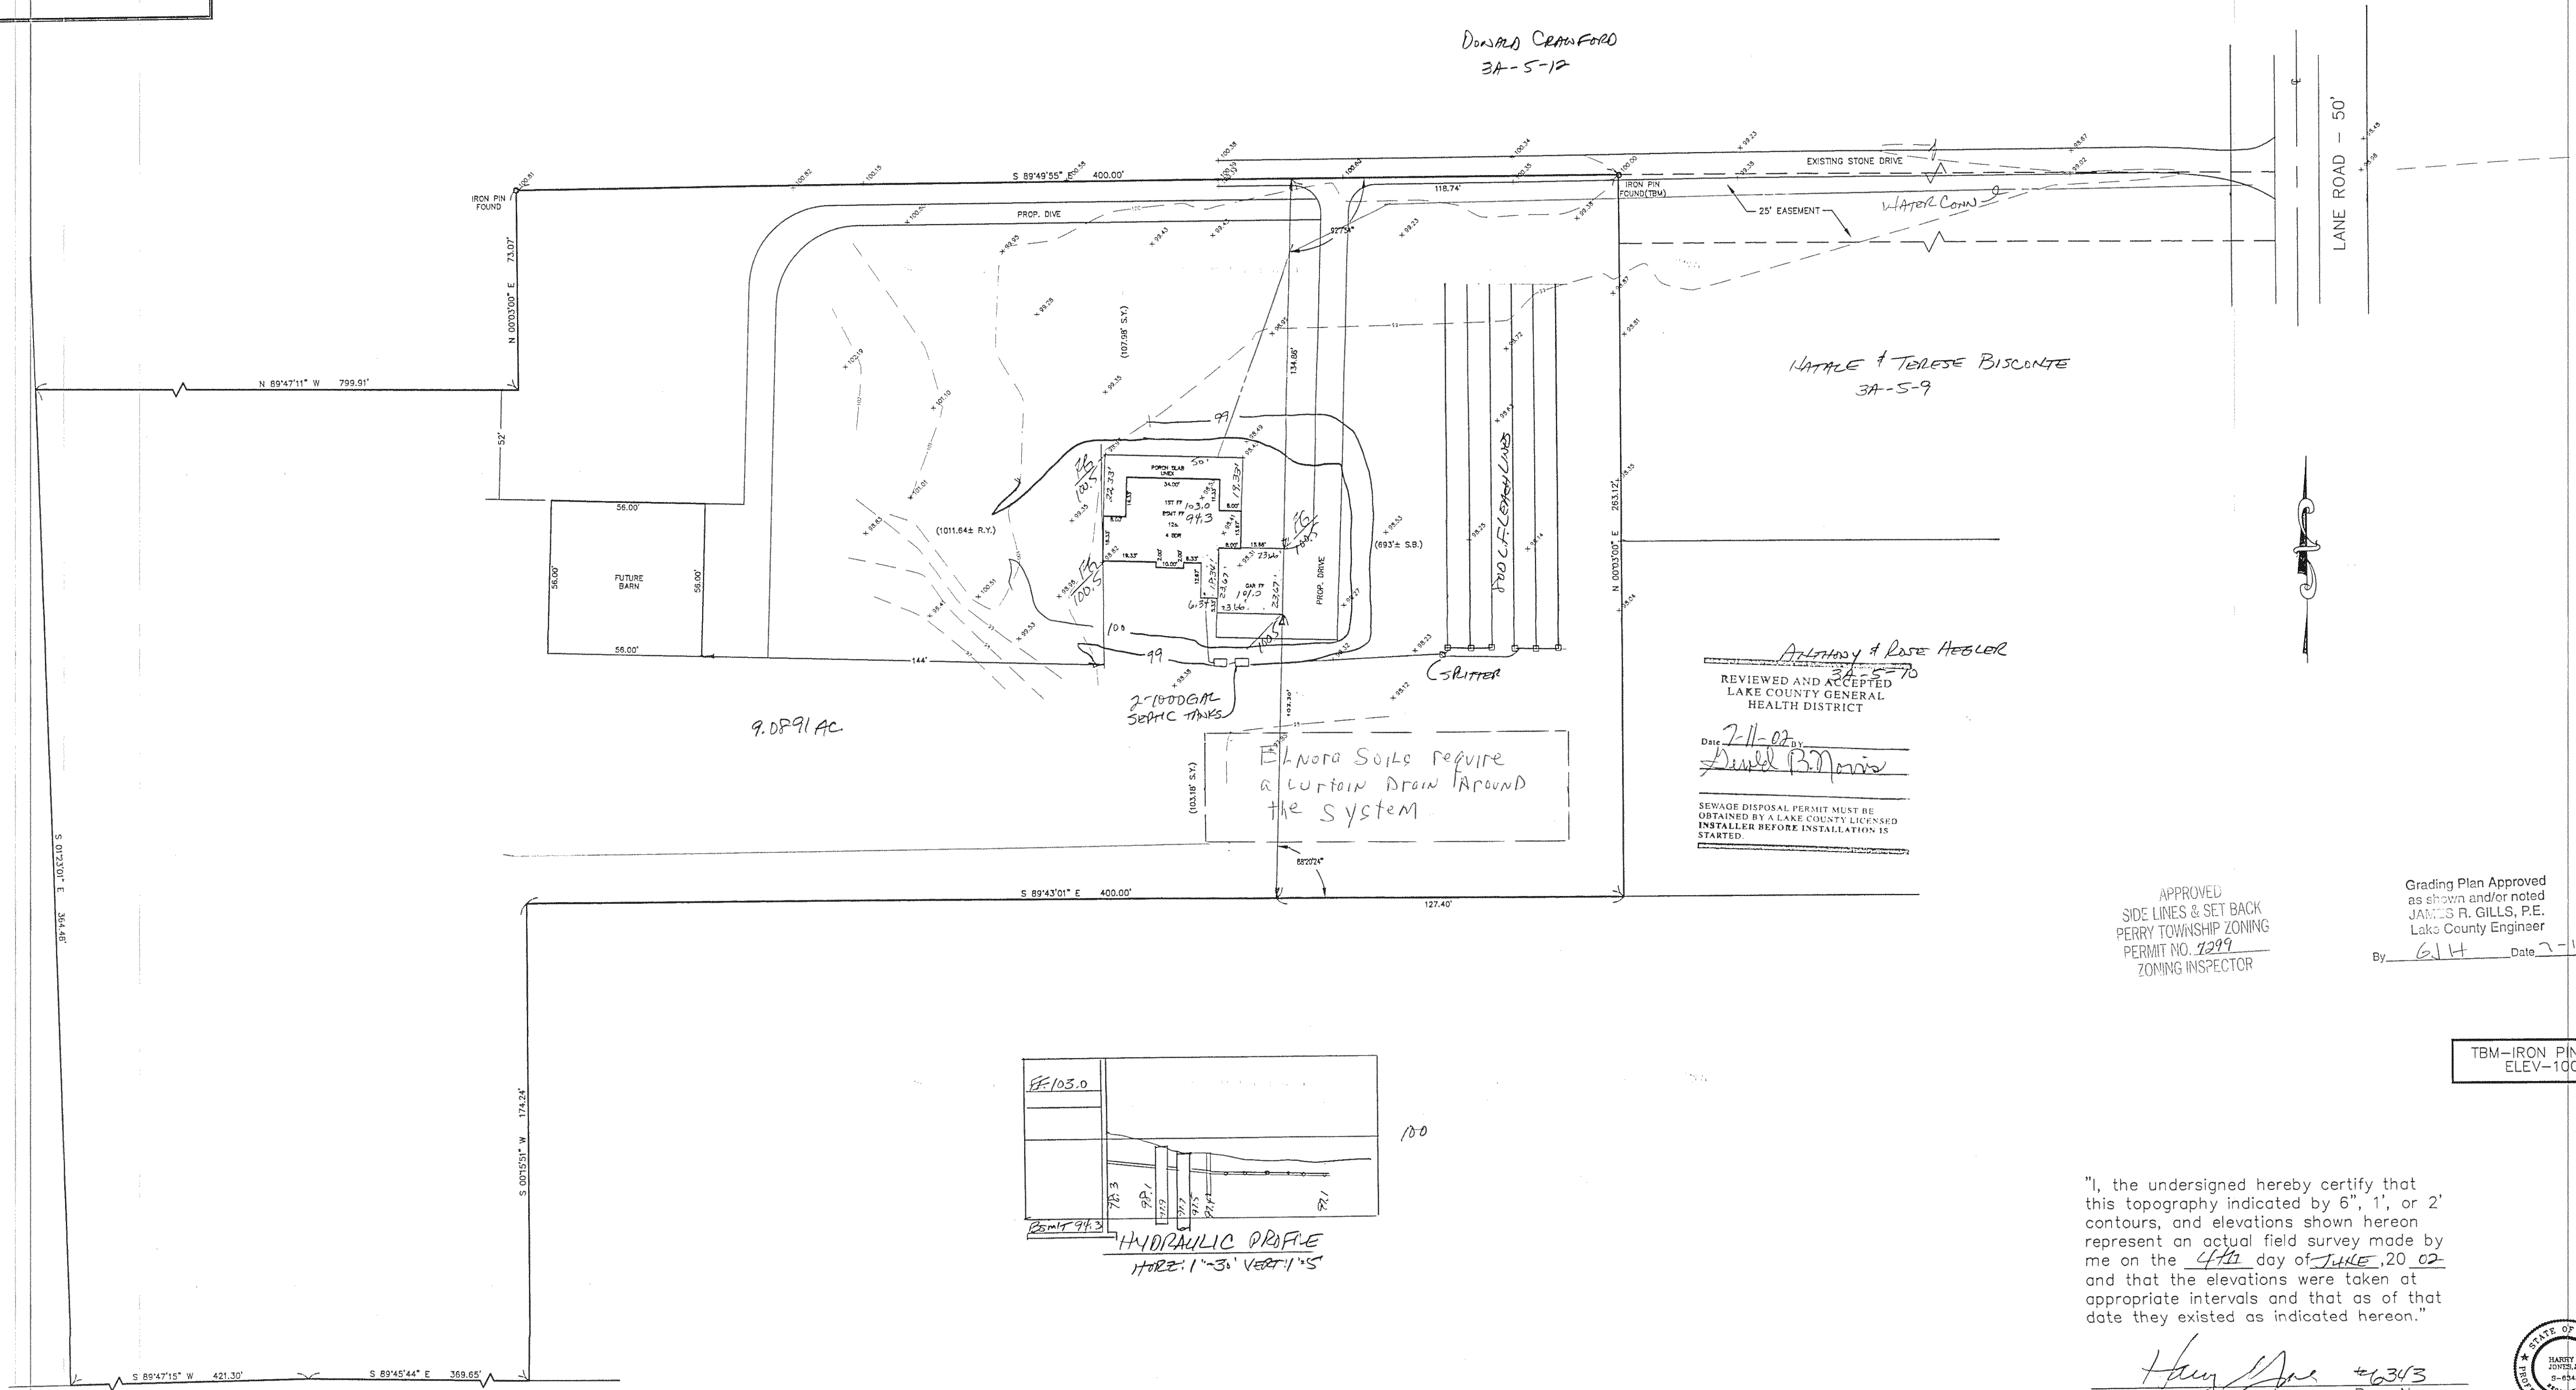

ALTHAM & ROSE HEGLER
REVIEWED AND ACCEPTED
LAKE COUNTY GENERAL
HEALTH DISTRICT

Date 7-11-02
David B. Morris

SEWAGE DISPOSAL PERMIT MUST BE
OBTAINED BY A LAKE COUNTY LICENSED
INSTALLER BEFORE INSTALLATION IS
STARTED


APPROVED
SIDE LINES & SET BACK
PERRY TOWNSHIP ZONING
PERMIT NO. 1299
ZONING INSPECTOR

Grading Plan Approved
as shown and/or noted
JAMES R. GILLS, P.E.
Lake County Engineer
By G.H. Date 7-16-02

TBM-IRON PIN FOUND
ELEV-100.00

"I, the undersigned hereby certify that
this topography indicated by 6", 1", or 2"
contours, and elevations shown hereon
represent an actual field survey made by
me on the 4th day of JUNE, 20 02
and that the elevations were taken at
appropriate intervals and that as of that
date they existed as indicated hereon."

Harry Jones #6343
Name Reg. No.

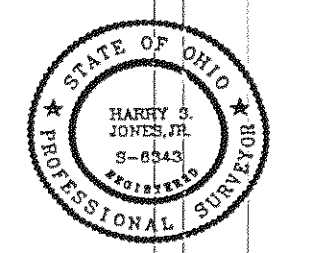

REV NO.	DESCRIPTION	DATE	BY	CHK'D
1	W/L	7-11-02	HT	HT

bj BABCOCK, JONES AND ASSOCIATES, INC
CIVIL ENGINEERS - SURVEYORS - LAND PLANNERS
PAINESVILLE OHIO 44077

DATE 6/5/02
DESIGN BY H.J.
DRAWN BY B.P.
APPROVED BY H.J.

SITE PLAN
TOWNSHIP OF PERRY COUNTY OF LAKE STATE OF OHIO

SCALE 1"=30"
JOB NO. 02-
SHEET 1