

By GJH Date 7/16/90
1. 12" DRIVE CULVERT
REQUIRED.

This Permit is for
 7-6-91
 PAINTED & TONED
 ZONING APPLIED
 # 7568
 Zoning Inspector


BEING 9/10, COLERIDGE DEV.
No. 3, LOT 53, TRACT 4 IN THE
TOWNSHIP OF PAINESVILLE,
COUNTY OF LAKE, STATE OF OHIO.

BENCHMARK - 682.38
INV. MH @ 9/11 & 9/13

U.S.G.S. = ELEV. + 594.2

I, the undersigned hereby certify that this topography, indicated by 1' contours, and elevations shown hereon represent an actual field survey made by me on 6-25-90 and that the elevations were taken at appropriate intervals and that as of that date they existed as indicated hereon.

J. M. Coffman P.S.
No 685

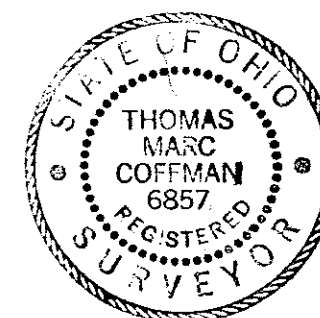

VILLAGE SURVEYING CO.
202 THIRD ST. FAIRPORT HARBOR, OH. 44077
(216) 357-1359