


100
10
C

Reviewed and Accepted _____
 LANE COUNTY GENERAL HEALTH DISTRICT
 Date 7-10-84
System installed by Curo
 JOEL EUCIA, R. S., M. P. H.,
 Health Commissioner
 BY SKM

SHED TO BE RELOCATED IF
DUPLICATION AREA IS TO
BE USED

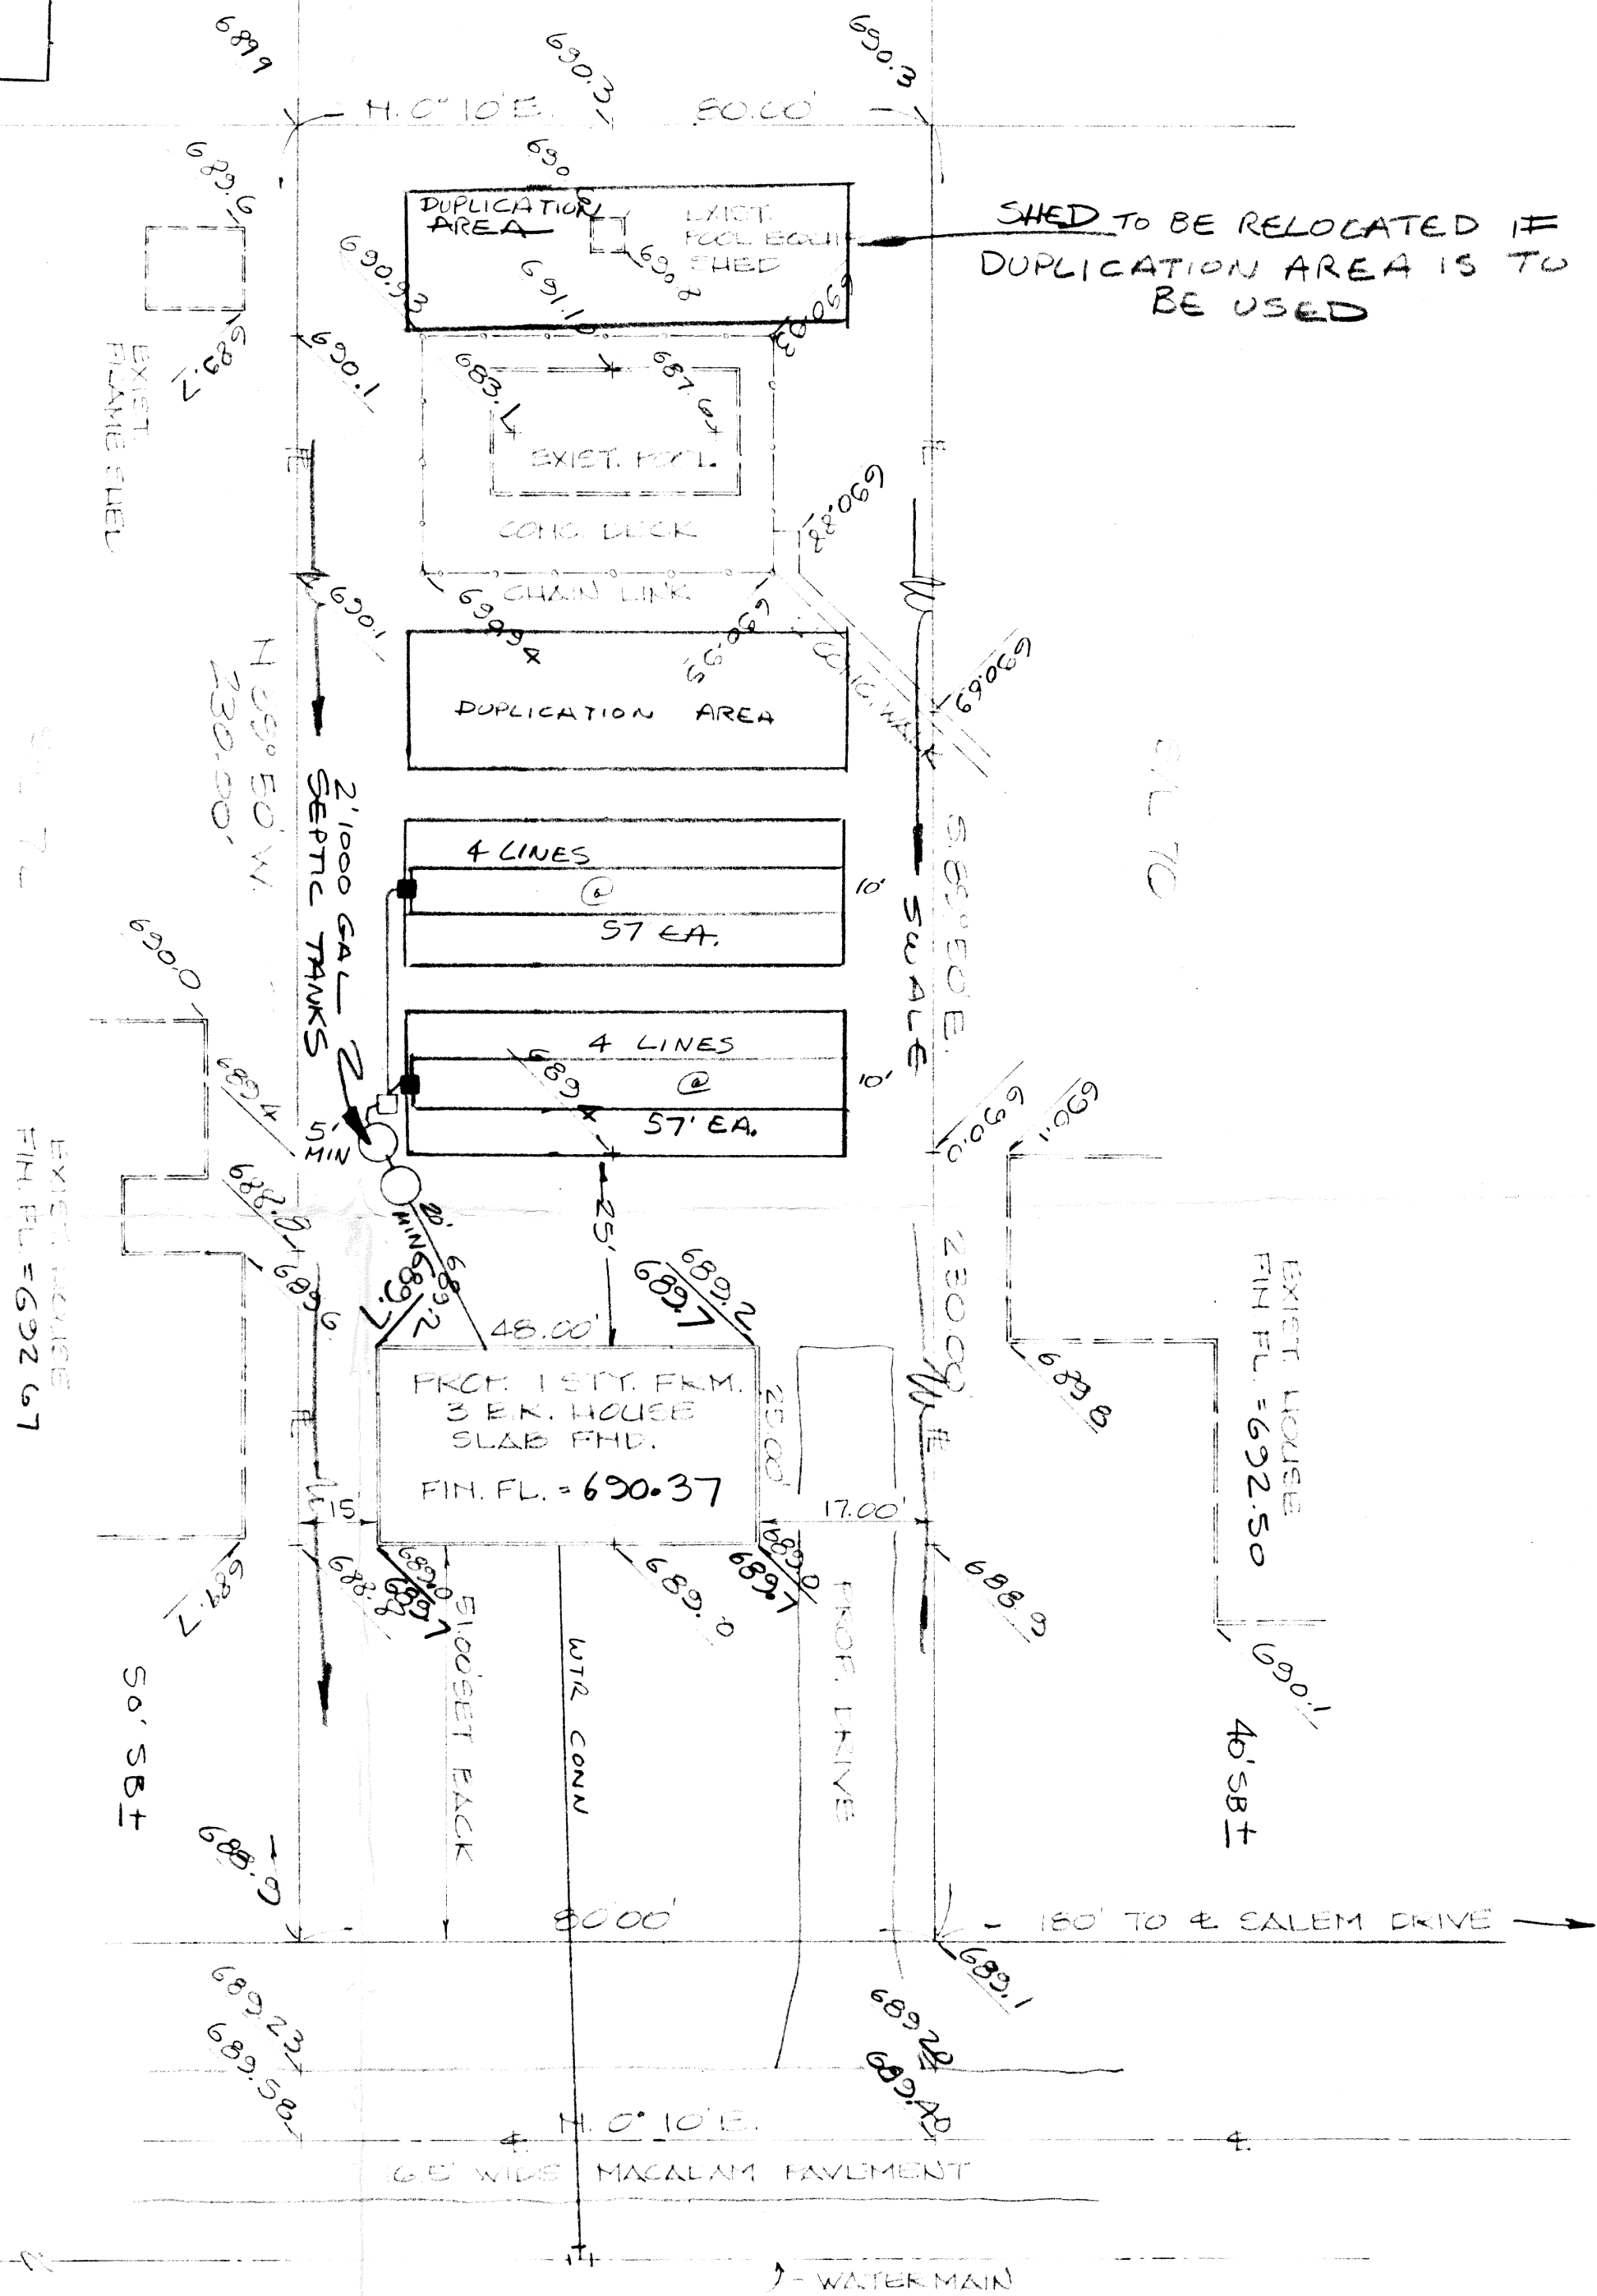

LEE ROAD 50'
(RECORDED IN PLAT VOL. I, PG. 96)

NORTH
SCALE 1"=20'

#5 687.8

688.7

WS 688.2	
WS 688.5	

EXIST GRADE

UNIST GRAD

#10	F4002	630.37
-----	-------	--------

30" MAX
SELECT
BACKFILL

4" RIGID PERFORATED PIPE

STEELE PLAY FOR GEORGE BELKNER

FIELDTOWN ACRES NO. 2 SUBDIVISION (PROPOSED)
 BAINESVILLE TOWNSHIP - LAKE COUNTY - OHIO

his term expires

JUL 8 1986

**PAINESVILLE TOWNSHIP
ZONING APPROVED**

6223A

RE: 1111, 1111
Zoning inspector 7/9/85

其四

1575244

BENCH MARK: TOP OF FIRE
 HYDRANT 123 FEET SOUTH
 OF SOUTHERLY PROPERTY
 LINE.
 ASSUMED ELEV = 623.00

Grading Plan Approved
as shown and/or noted
THOMAS P. GILLES, P.E.
Leflore County Engineer

By: TPG Date: 2-11-85

By dfm Date 7.11.85

DATE 7-2-85
SCALE 1"=20'
DRAWN BY TPEH
CHK'D BY
EED 52/ 89



COLPETZER · WOODS
CONSULTANTS, INC.
MENTOR, OHIO 44060

SHEET 1 OF 1

6105-7-6