

Grading Plan Approved
as shown and/or noted
THOMAS P. GILLES, P.E.
Lake County Engineer
By Joe Date 10 APR 79

PAINESVILLE TOWNSHIP
ZONING APPROVED
#4386 4-5-78
Thomas P. Gilles
Zoning Inspector

SITE PLAN

PAINESVILLE TOWNSHIP, LAKE COUNTY, OHIO

for: RYAN CLIENT HOMES OWNER

ADDRESS STREET CITY ZIP

SUBDIVISION NAME		LOT	TRACT
PARK ESTATES			
VOL. - PG.		VOLUME	PAGE
ST CARRIAGEWAY		PERM. PARCEL NO.	STREET
SUBLOT NO.	STREET		

LEGEND

SANITARY MANHOLE	---○---	WATER VALVE (GAS)	---○---
STORM MANHOLE	---●---	WATER METER (GAS)	---○---
INLET OR CATCH BASIN	---□---	AS BUILT ELEVATION	---○---
HYDRANT	---○---	INDICATES	---○---
EXISTING CONTOURS	---○---	DIRECTION OF	---○---
PROPOSED CONTOURS	---○---	SURFACE DRAINAGE	---○---
EXIST. ELEV.	100.0		
	100.0		
	PROP. ELEV.		

REMARKS

ALL BOUNDARY DATA SHOWN WAS OBTAINED FROM IDEEDS, RECORDED
SUBDIVISION PLAT OR OTHER PUBLIC RECORDS)
LOCATIONS AS SHOWN OF ADJACENT WELLS AND SEPTIC TANKS OBTAINED
FROM LAKE COUNTY HEALTH DEPARTMENT

DESIGN CERTIFICATION

THIS PLAT WAS PREPARED BY ME, AND IS CORRECT
TO THE BEST OF MY KNOWLEDGE AND BELIEF.

Thomas P. Gilles NAME SURVEYOR REGISTRATION NO. 4386

CHECK LIST

NO. OF BEDROOMS	WATER MAIN SIZE, LOCATION
DIMENSIONS	SAN. SEWER SIZE, % GR. LOC.
BEARINGS	SAN. MH. CAST. ELEV. INV. ELEV.
TIE TO NEAREST STREET	SAN. CONN. SIZE, LOC. DEPTH
SUBLOT NO. PARCEL NO.	STORM SEWER SIZE, % GR. LOC.
SURROUNDING OWNERS	STORM MH. CAST. ELEV. INV. ELEV.
BLDG. DIMENSIONS FIN. GR.	PAV'T TYPE, GRADE CURBS
BDDG. TIES FL'S, GRADES	GAS LINE LOC. SIZE PRESSURE
APRON TYPE WIDTH THICKNESS	SEPTIC TANK LOCATION & DUPLICATION AREA
SIDEWALK TYPE WIDTH THICKNESS	WELL LOCATION
CULVERT TYPE DIA. LENGTH	ISOLATION RADIUS FROM WELL
ROCK OUTCROPPINGS	


REVISIONS

NO.	DATE	BY	PLAN PREPARED BY:	
1.			DEBEVEC - SALO & ASSOCIATES, INC.	
2.			PAINESVILLE, OHIO	
3.			DRAWN BY	SCALE
4.			CHK'D.	DATE
5.			CREW CHIEF	APP'D.

"AS BUILT" CERTIFICATION

I, HEREBY CERTIFY THAT THE CIRCLED GRADES ARE EXISTING FINISH
GRADES CHECKED IN FIELD ON 19 BY
SURVEYING AND ARE CORRECT TO THE BEST OF MY KNOWLEDGE AND BELIEF.

REGISTERED SURVEYOR RES. NO.

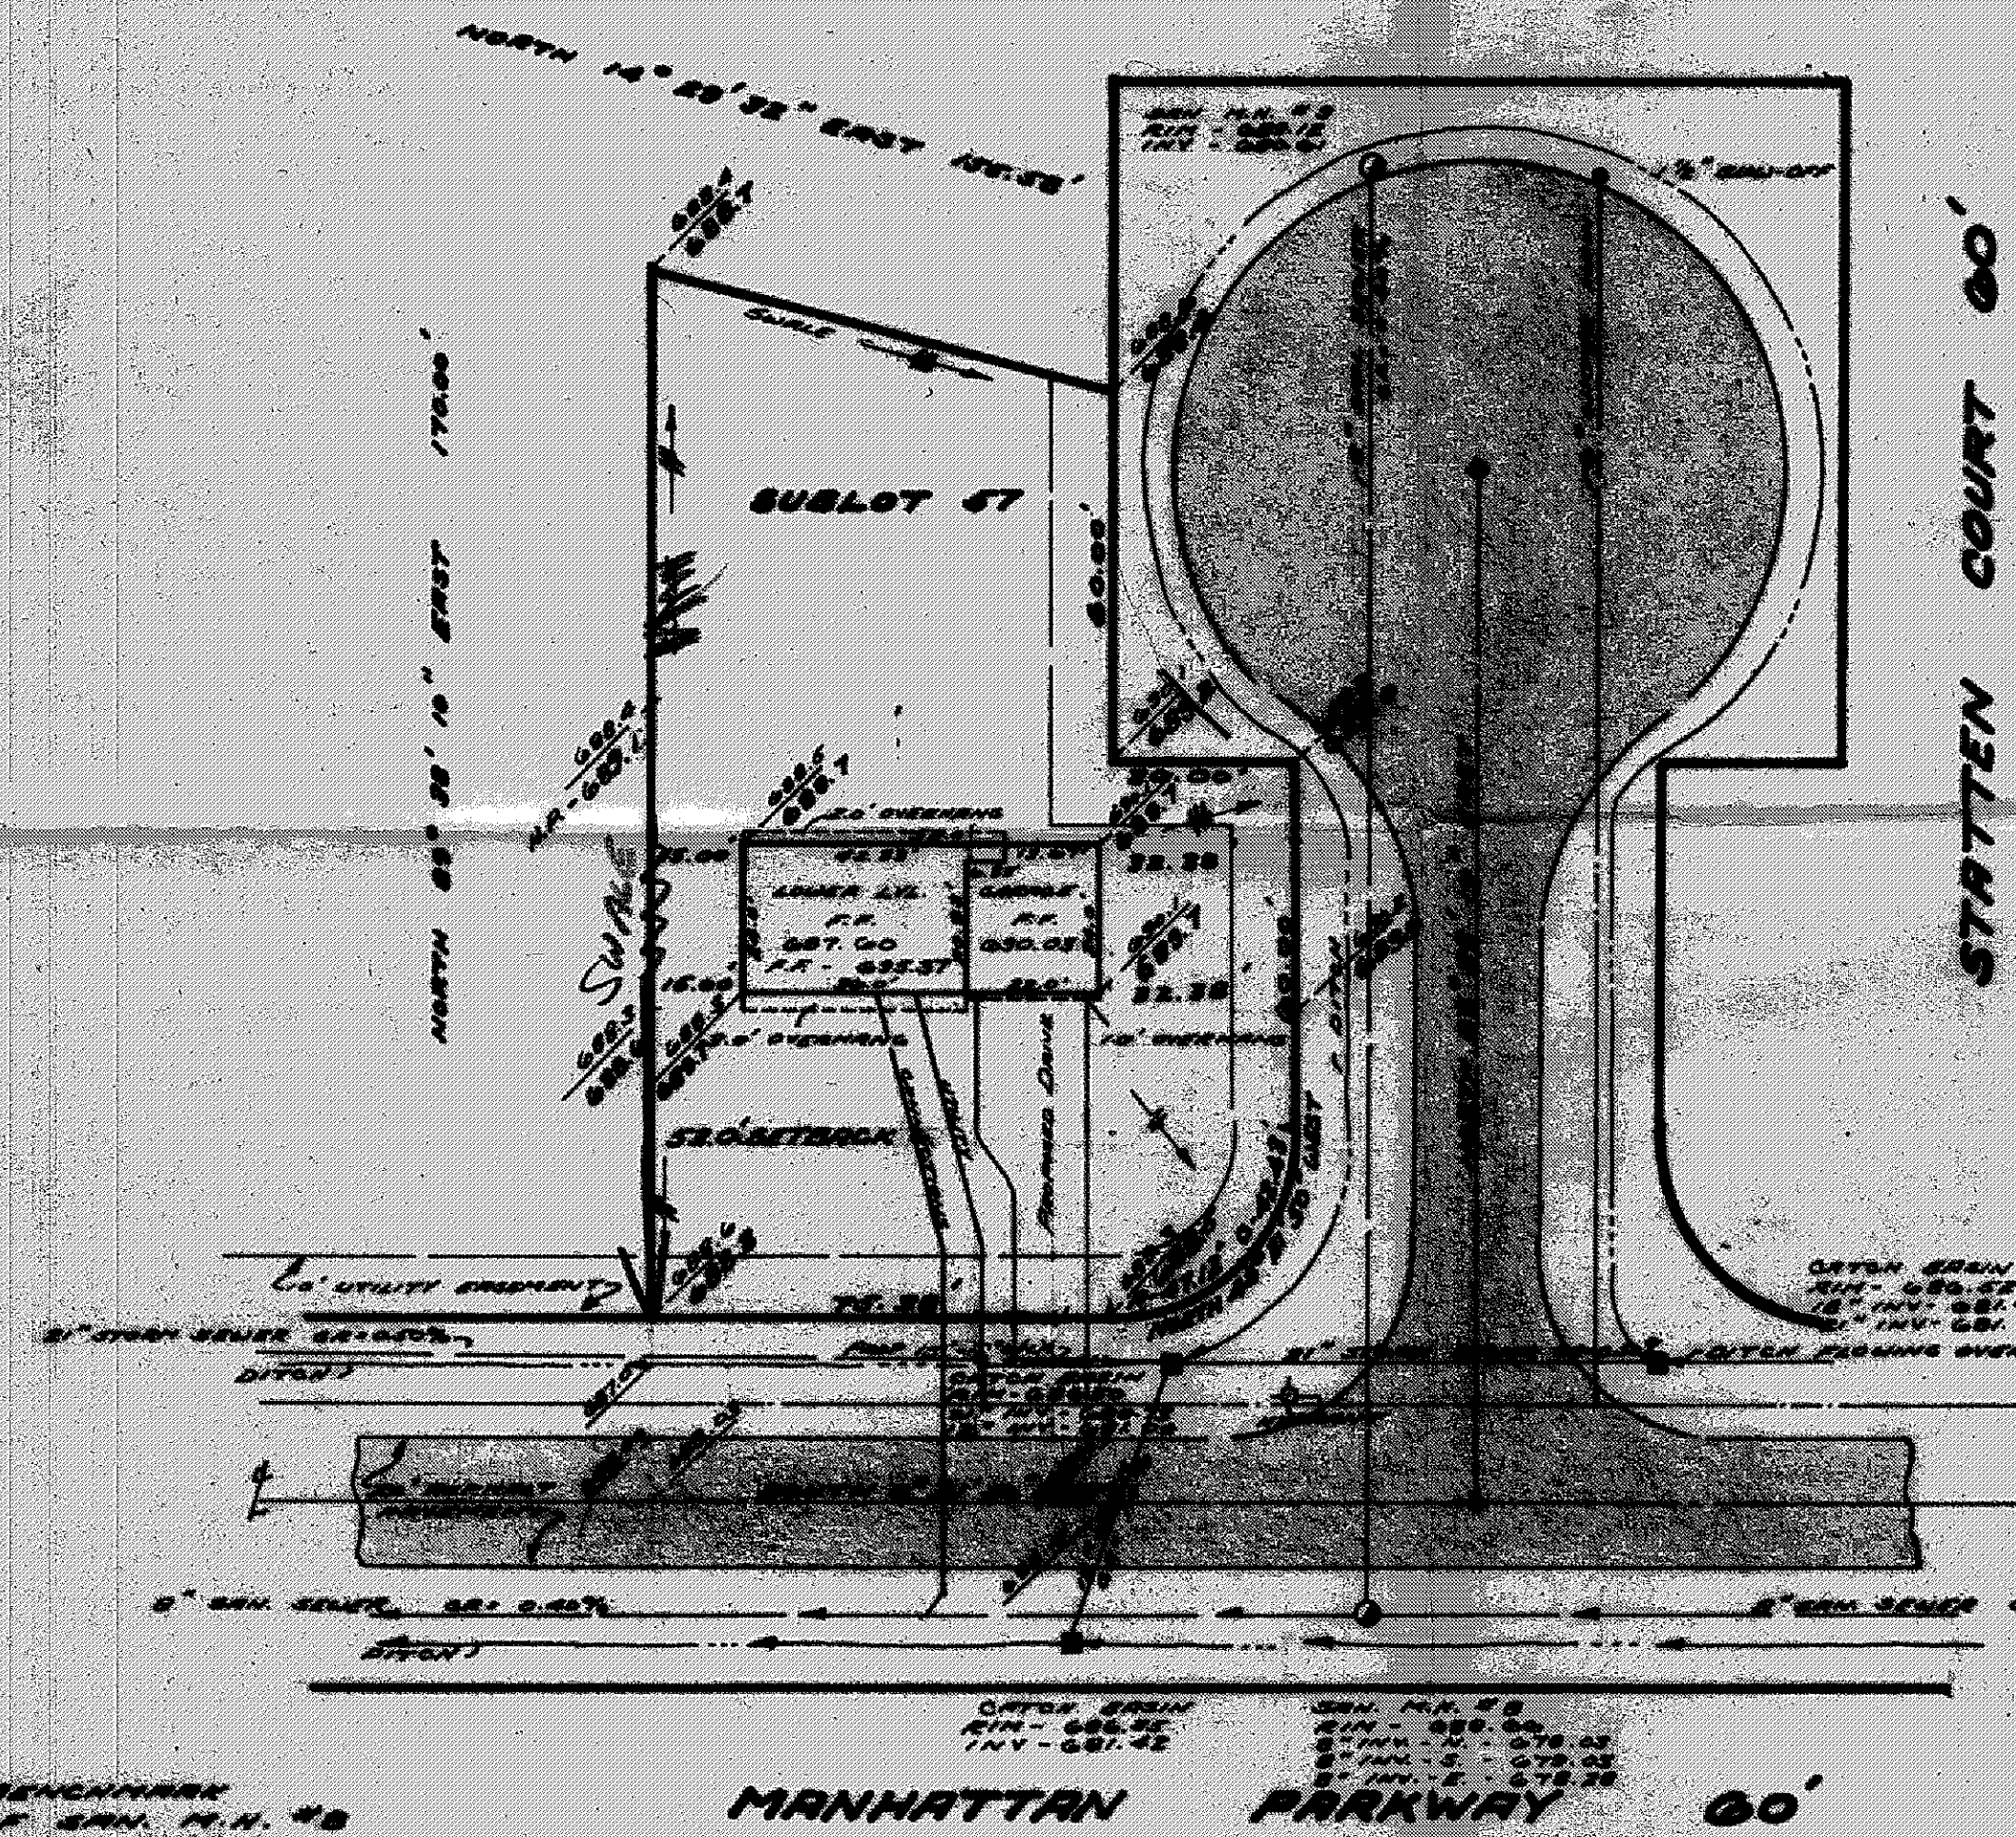

BENCHMARK
RIM OF SAN. M.H. #8
ELEV. - 688.60

MANHATTAN PARKWAY 60'