


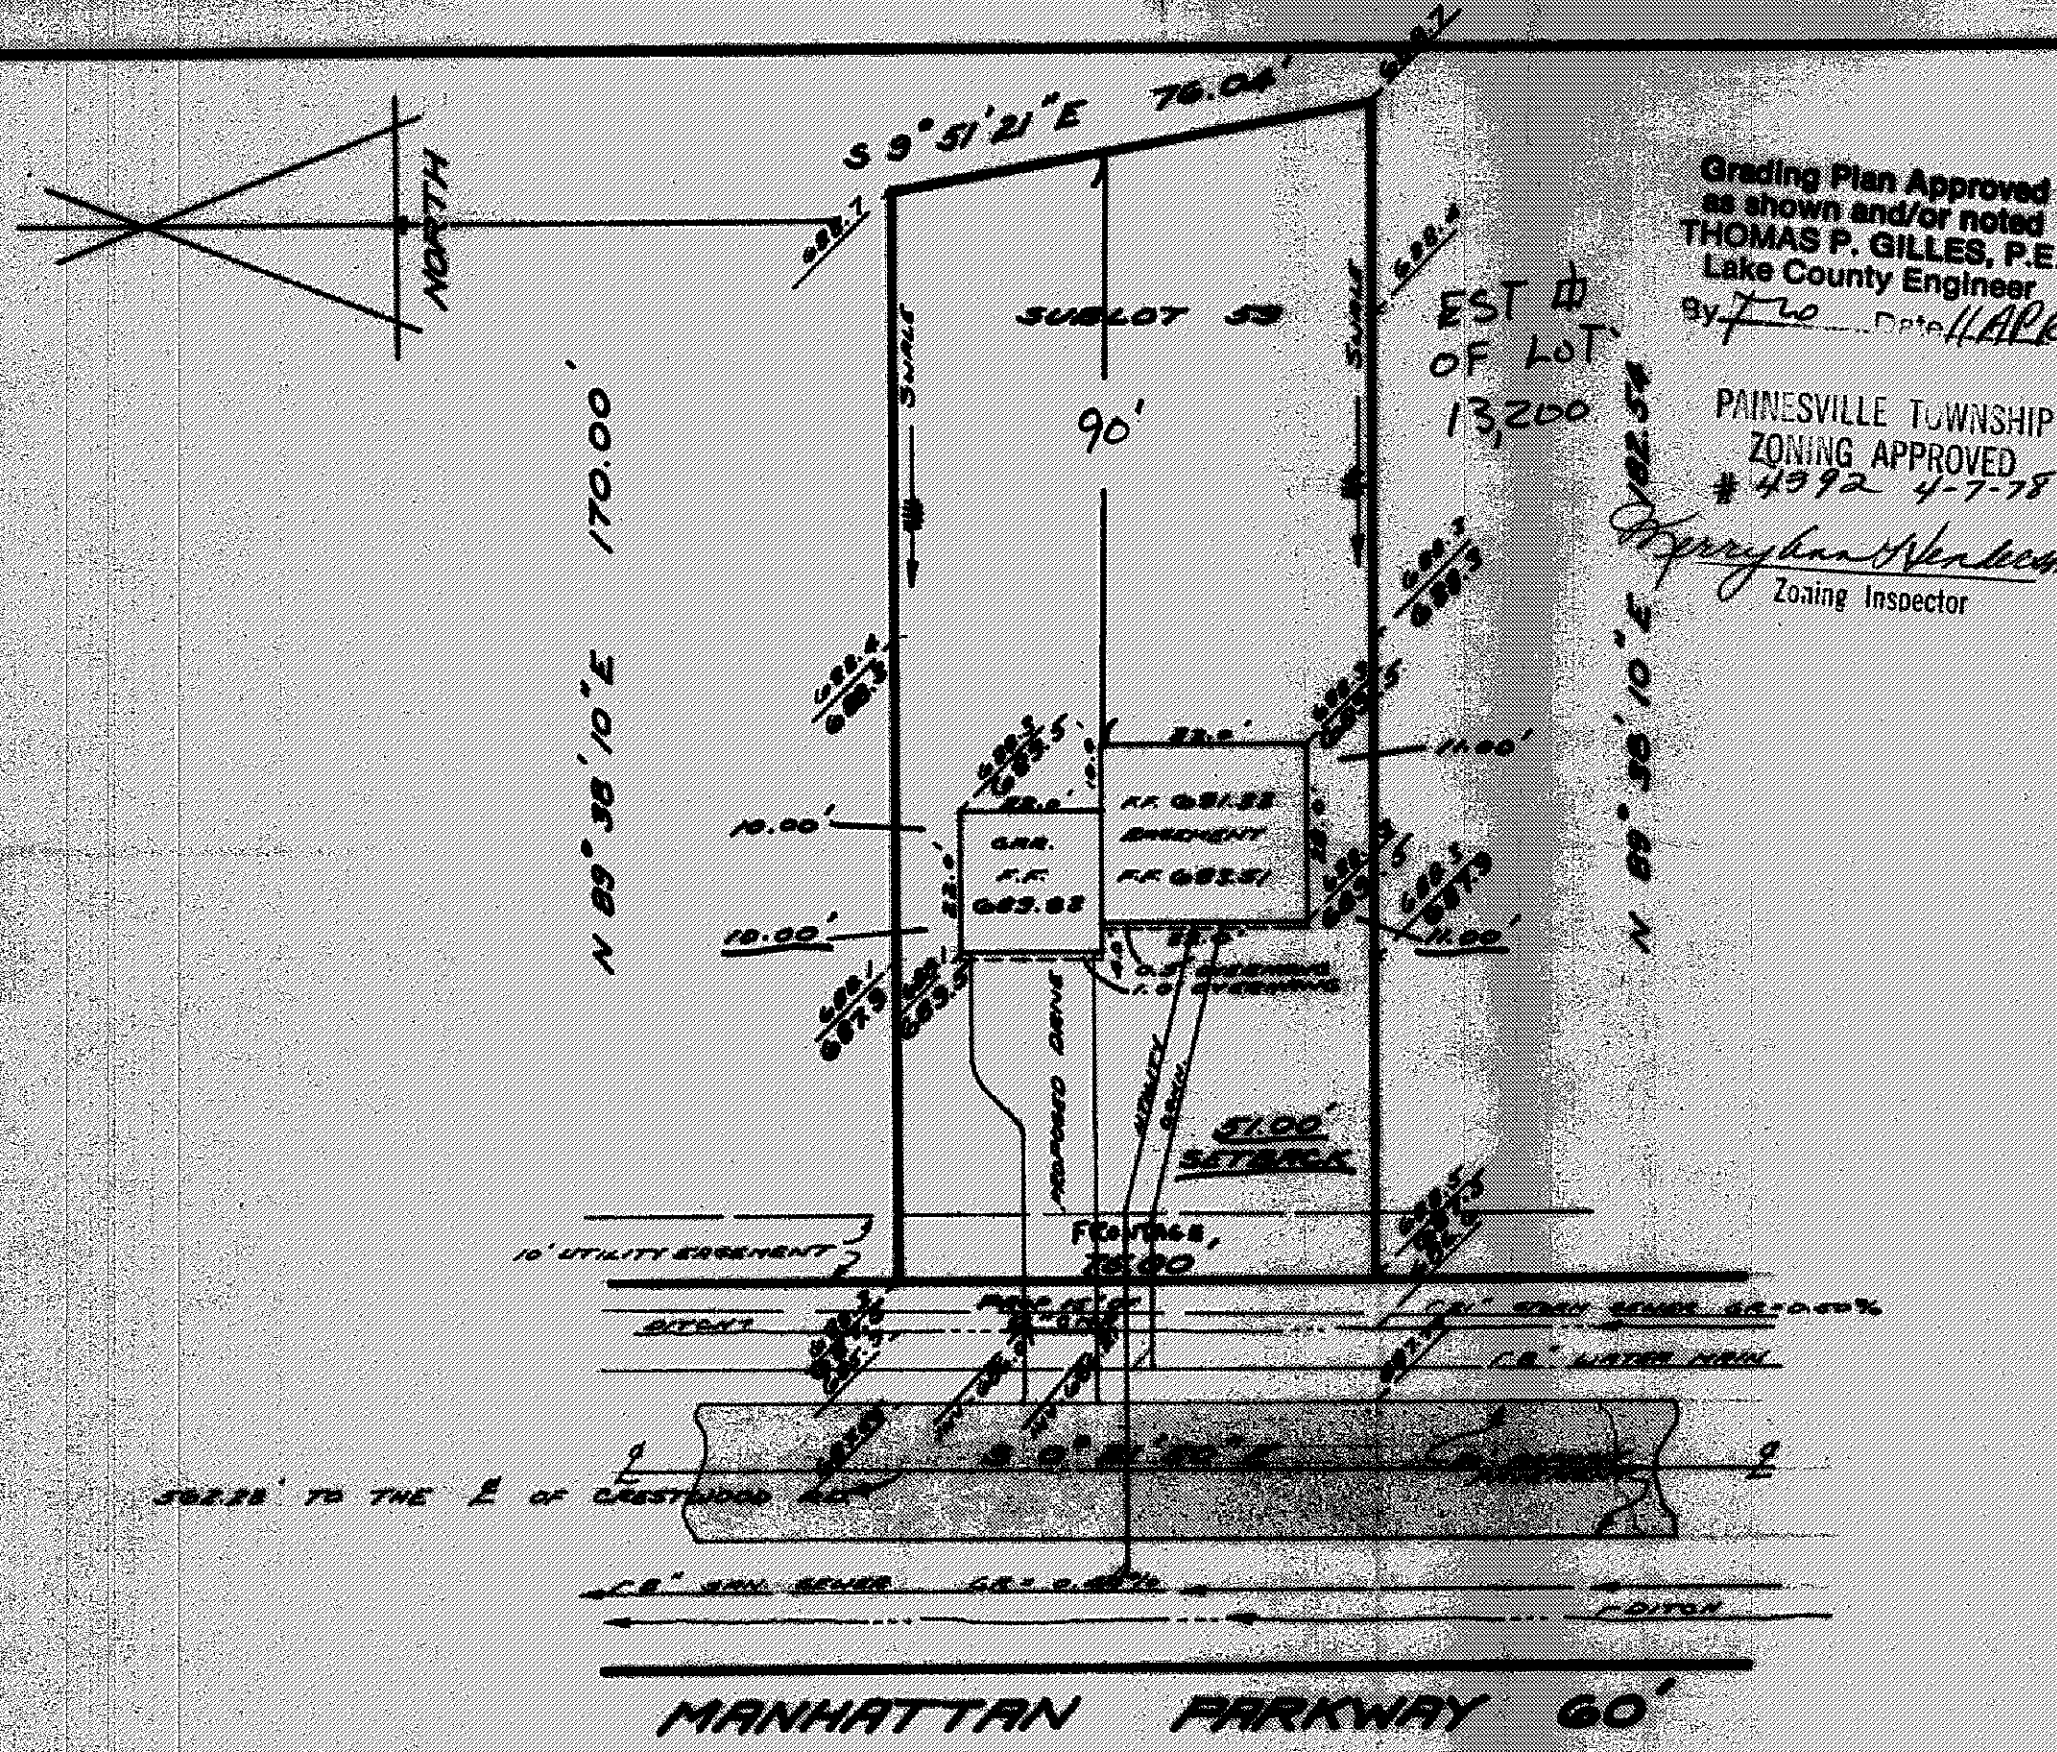

Grading Plan Approved
as shown and/or noted
THOMAS P. GILLES, P.E.
Lake County Engineer
By Joe Date 11 APR 78

PAINESVILLE TOWNSHIP
ZONING APPROVED
#4392 4-7-78
Harry Van der Veken
Zoning Inspector

SITE PLAN

PAINESVILLE TOWNSHIP, LAKE COUNTY, OHIO

for: RYAN HOMES
CLIENT OWNER

ADDRESS	STREET	CITY	ZIP
SUBDIVISION	NAME	LOT	TRACT
SUBLOT NO.	STREET	VOLUME	PAGE
SUBLOT NO.	STREET	PERM. PARCEL NO.	STREET

LEGEND

SANITARY MANHOLE	---○---	WATER VALVE (GAS)	---+---
STORM MANHOLE	---●---	WATER METER (GAS)	---+---
INLET OR CATCH BASIN	---■---	AS BUILT ELEVATION	100.0
HYDRANT	---○---	INDICATES DIRECTION OF SURFACE DRAINAGE	↓
EXISTING CONTOURS	---○---		
PROPOSED CONTOURS	---○---		
EXIST. ELEV.	100.0	PROP. ELEV.	100.0

REMARKS

ALL BOUNDARY DATA SHOWN WAS OBTAINED FROM (DEEDS, RECORDED SUBDIVISION PLAT OR OTHER PUBLIC RECORDS)

LOCATIONS AS SHOWN OF ADJACENT WELLS AND SEPTIC TANKS OBTAINED FROM LAKE COUNTY HEALTH DEPARTMENT

DESIGN CERTIFICATION

THIS PLAT WAS PREPARED BY ME, AND IS CORRECT TO THE BEST OF MY KNOWLEDGE AND BELIEF.

Edward J. Salo NAME SURVEYOR REGISTRATION NO. 4384

CHECK LIST

NO. OF BEDROOMS	WATER MAIN SIZE, LOCATION
DIMENSIONS	SAN. SEWER SIZE & GR. LOC.
SEARINGS	SAN. MH. CAST ELEV. INV. ELEV.
TIE TO NEAREST STREET	SAN. CONN. SIZE, LOC. DEPTH
SUBLOT NO. PARCEL NO.	STORM SEWER SIZE & GR. LOC.
SURROUNDING OWNERS	STORM MH. CAST ELEV. INV. ELEV.
BLDG. DIMENSIONS FIN. GR.	PAY'T TYPE GRADE CURBS
BLDG. TIES FLTR. GRADES	GAS LINE LOC. SIZE PRESSURE
APRON TYPE WIDTH THICKNESS	SEPTIC TANK LOCATION & DUPLICATION AREA
SIDEWALK TYPE WIDTH THICKNESS	WELL LOCATION
CULVERT TYPE DIA. LENGTH	ISOLATION RADIUS FROM WELL
ROCK OUTCROPPINGS	

BENCHMARK - RIM OF SAN. M.H.
IN FRONT OF S/L 62.
ELEV. - 687.58

"AS BUILT" CERTIFICATION

I, HEREBY CERTIFY THAT THE CIRCLED GRADES ARE EXISTING FINISH GRADES CHECKED IN FIELD ON 19 BY SURVEYING AND ARE CORRECT TO THE BEST OF MY KNOWLEDGE AND BELIEF.

REGISTERED SURVEYOR REG. NO.

REVISIONS			PLAN PREPARED BY:		
NO.	DATE	BY	DEBEVEC-SALO & ASSOCIATES, INC.		
1			130 EAST JACKSON ST. PAINESVILLE, OHIO		
2			DRAWN BY	SCALE	PHONE NO.
3			<u>2.2</u>	<u>1" = 30'</u>	<u>352-9250</u>
4			CHK'D.	DATE	DRAWING NO.
5				<u>3-31-78</u>	
			CREW CHIEF	APP'D.	<u>4980-53</u>