


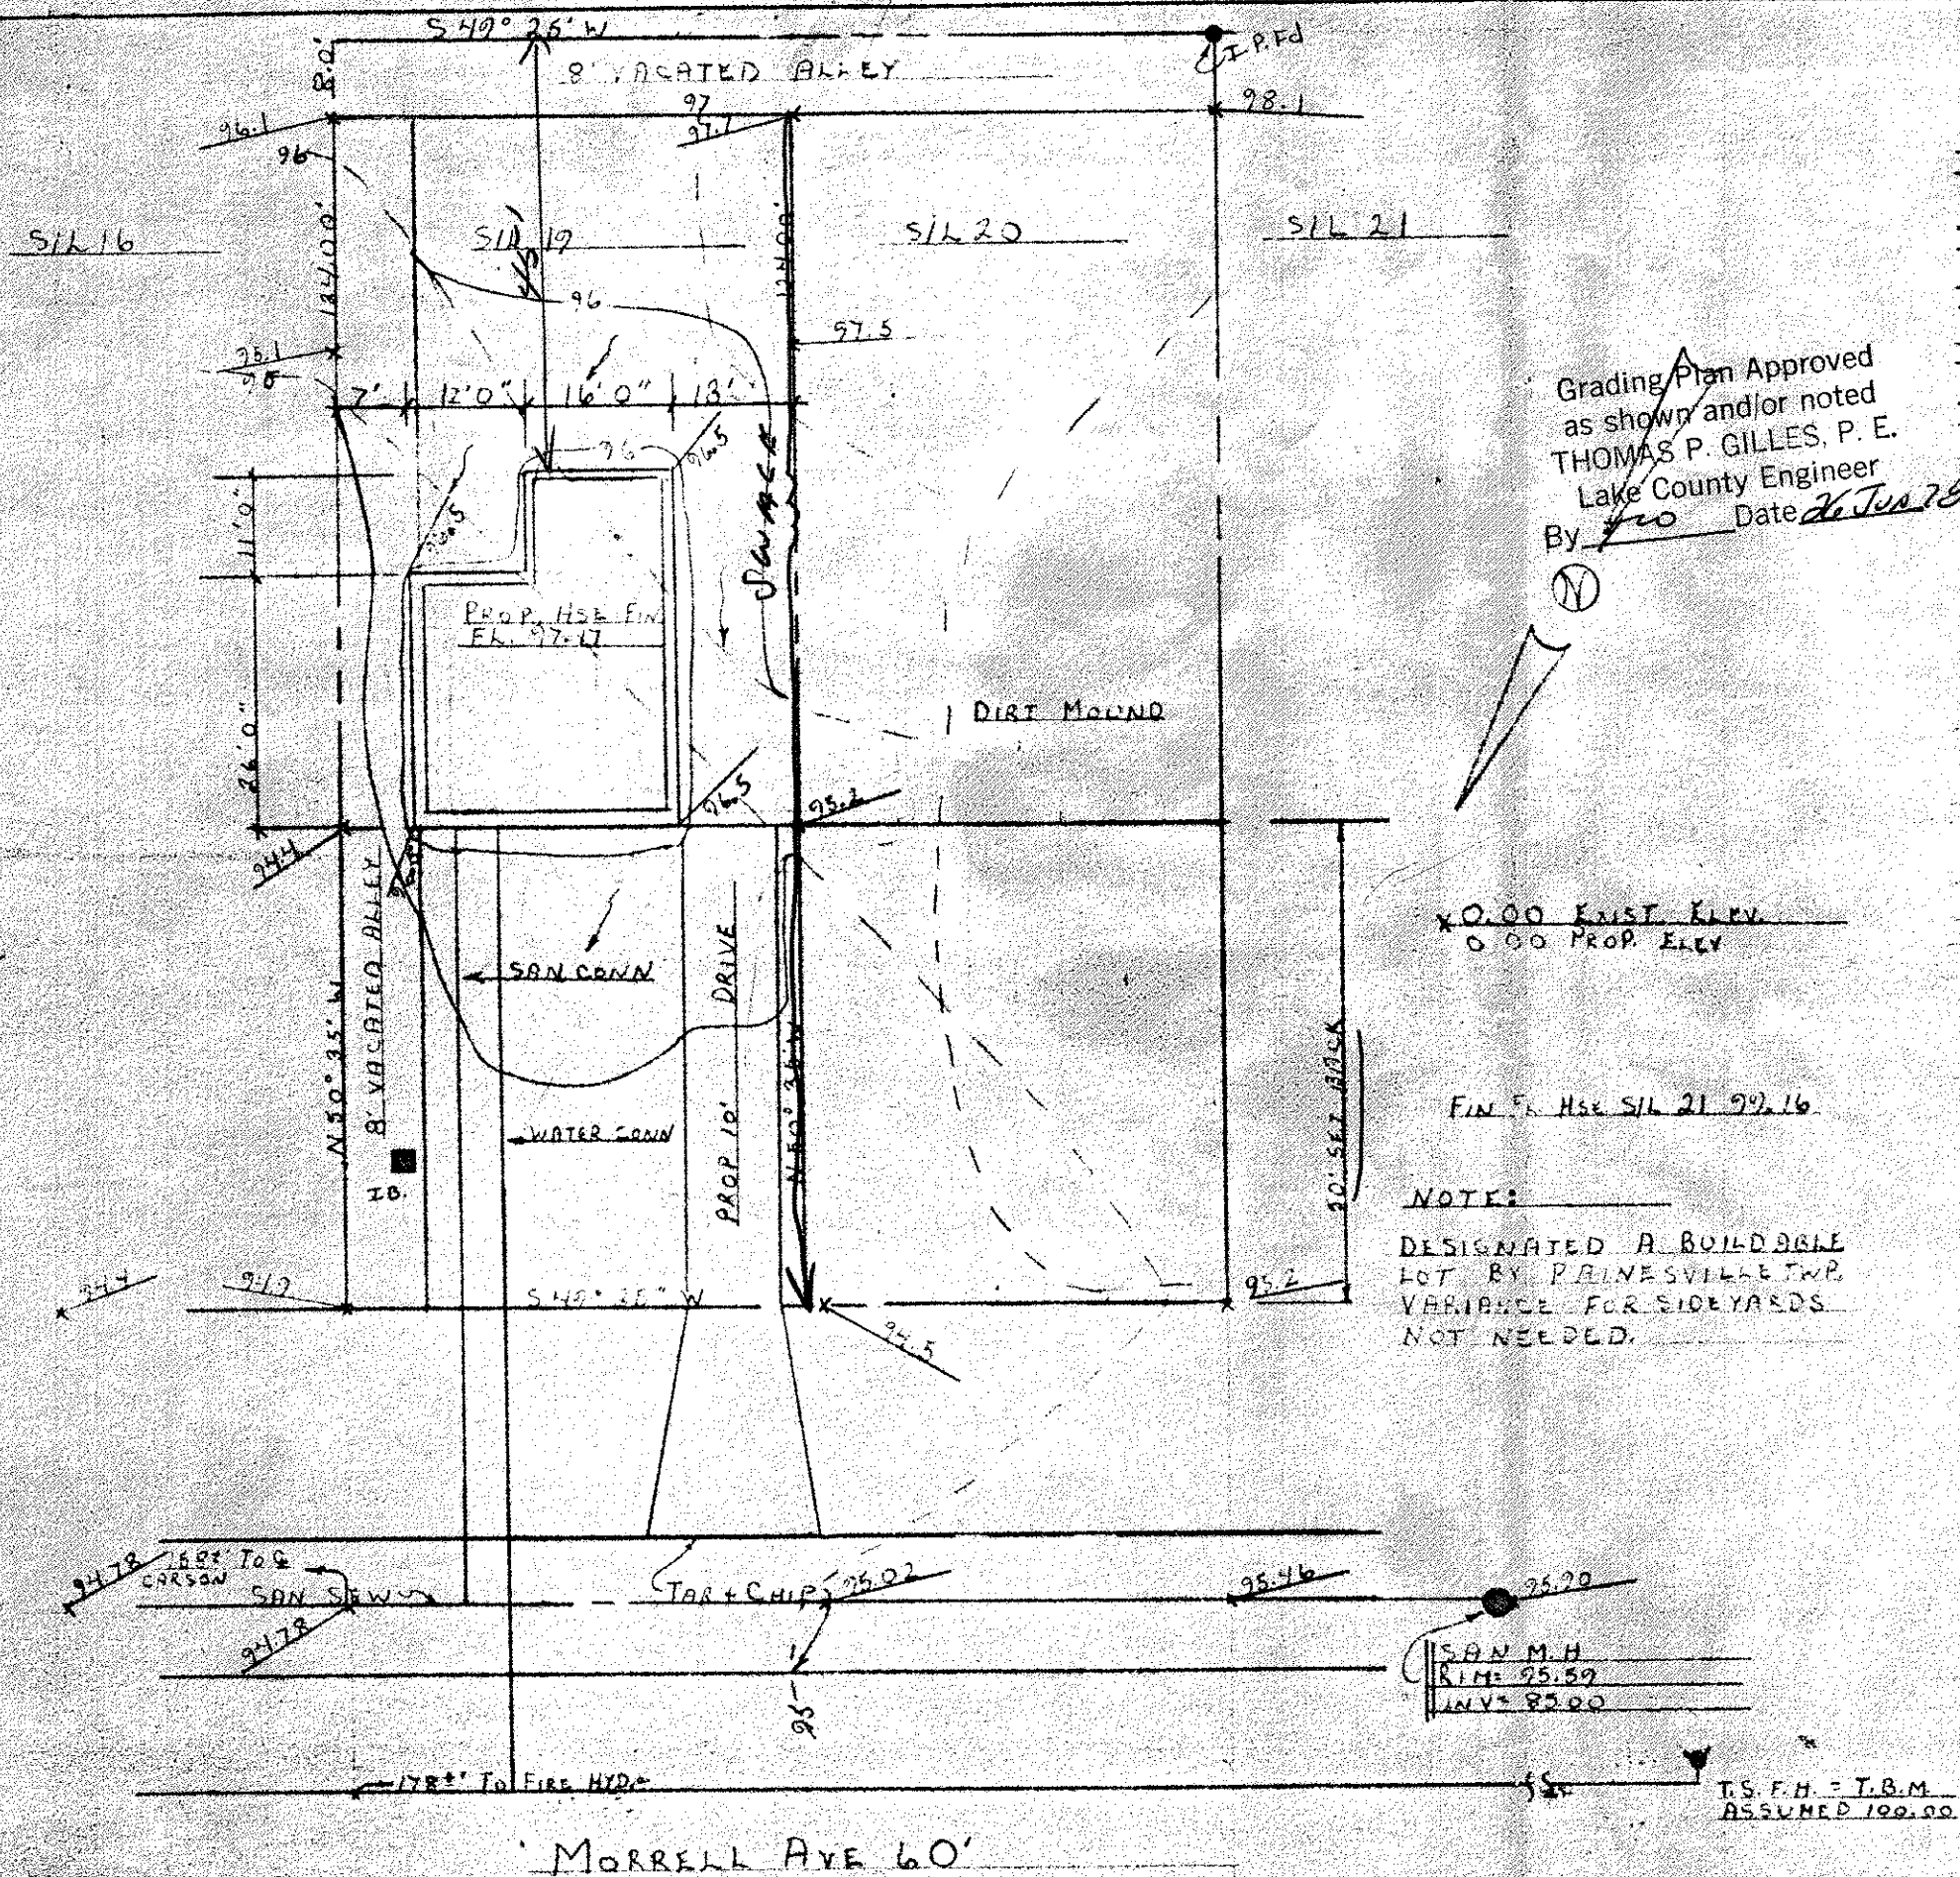

SITE PLAN FOR:

JACK MUNROE

8946 JACKSON STREET

MENTOR, OHIO

BEING SUBLOT 12 IN BLOCK 123

OF G. E. MEIGS RESUBDIVISION OF TRACT 4 IN

GRAND RIVER, OHIO

PAINESVILLE TOWNSHIP

ZONING APPROVED

4397 6-23-78

Debra Ann Henderson
Zoning Inspector

PREPARED BY:

WM. R. GRAY ASSOC. INC.

7547 MENTOR AVE

MENTOR, OHIO

SCALE: 1" = 20'

DATE: MAY 18, 1978

REVISED: MAY 22, 1978

10.00 EXIST. ELEV.
0.00 PROP. ELEV.

FIN. FL. HSE. SIL 21 99.16

NOTES:

DESIGNATED A BUILDABLE
LOT BY PAINESVILLE TWP.
VARIANCE FOR SIDEYARDS
NOT NEEDED.

CERTIFICATION:

I HEREBY CERTIFY THAT THIS PLAT
IS CORRECT TO THE BEST OF MY
KNOWLEDGE

BY: *Wm. R. Gray*

WM. R. GRAY, REG. SURV. #2752

