


SAN. MH. AT INTERSECTION
OF MORRELL & CARSON
AVENUES (TBM)
RIM. = 100.00
INV. = 88.84


MORRELL AVENUE 60'

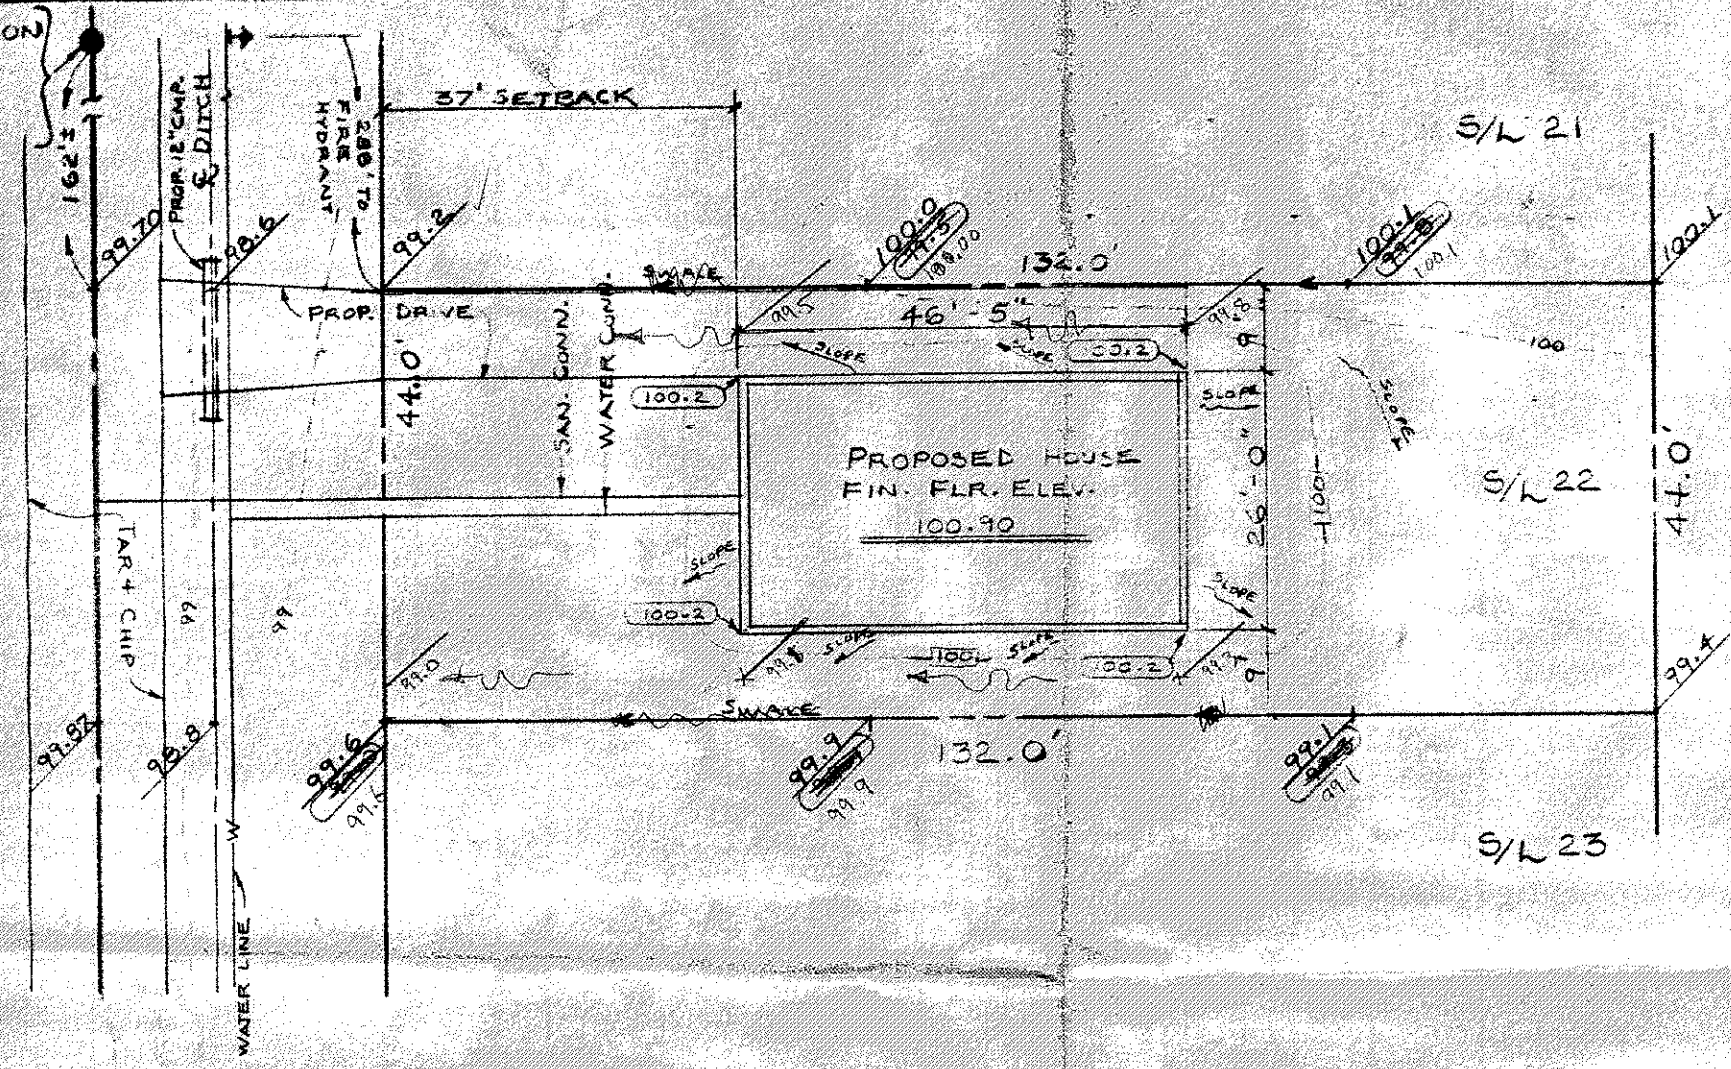

PAINESVILLE TOWNSHIP
ZONING APPROVED

Appeals # 4164 5-12-77
Mary Ann Neiderman
Zoning Inspector

Grading Plan Approved
as shown and/or noted
THOMAS P. GILLES, P.E.
Lake County Engineer
By D.J.L. Date 5/12/77

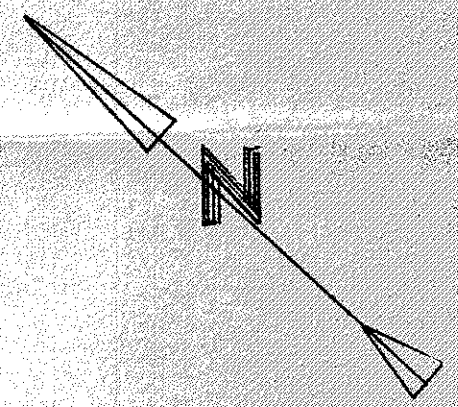

SITE PLAN FOR :

WAYNE HAWKINS
6587 ELMWOOD DRIVE
MENTOR, OHIO 44060
BEING SUBLLOT NUMBER
22 TRACT 4 IN GRAND RIVER
VILLAGE, OHIO

PREPARED BY:

WM. R. GRAY ASSOC. INC.
7547 MENTOR AVENUE
MENTOR, OHIO
SCALE : 1" = 20'
DATE : APRIL 22, 1977

CERTIFICATION :

I HEREBY CERTIFY THAT THIS
PLAT IS CORRECT TO THE
BEST OF MY KNOWLEDGE.
BY: Wm. R. Gray
WM. R. GRAY REG. SURV. # 2752

