


Grading Plan Approved
as shown and for noted
THOMAS E. GILLES, P.E.
Lake County Engineer

By *J. M. Gilles* Date *3/17/76*
#3845 3-17-76

STROTHER AVE. 60'

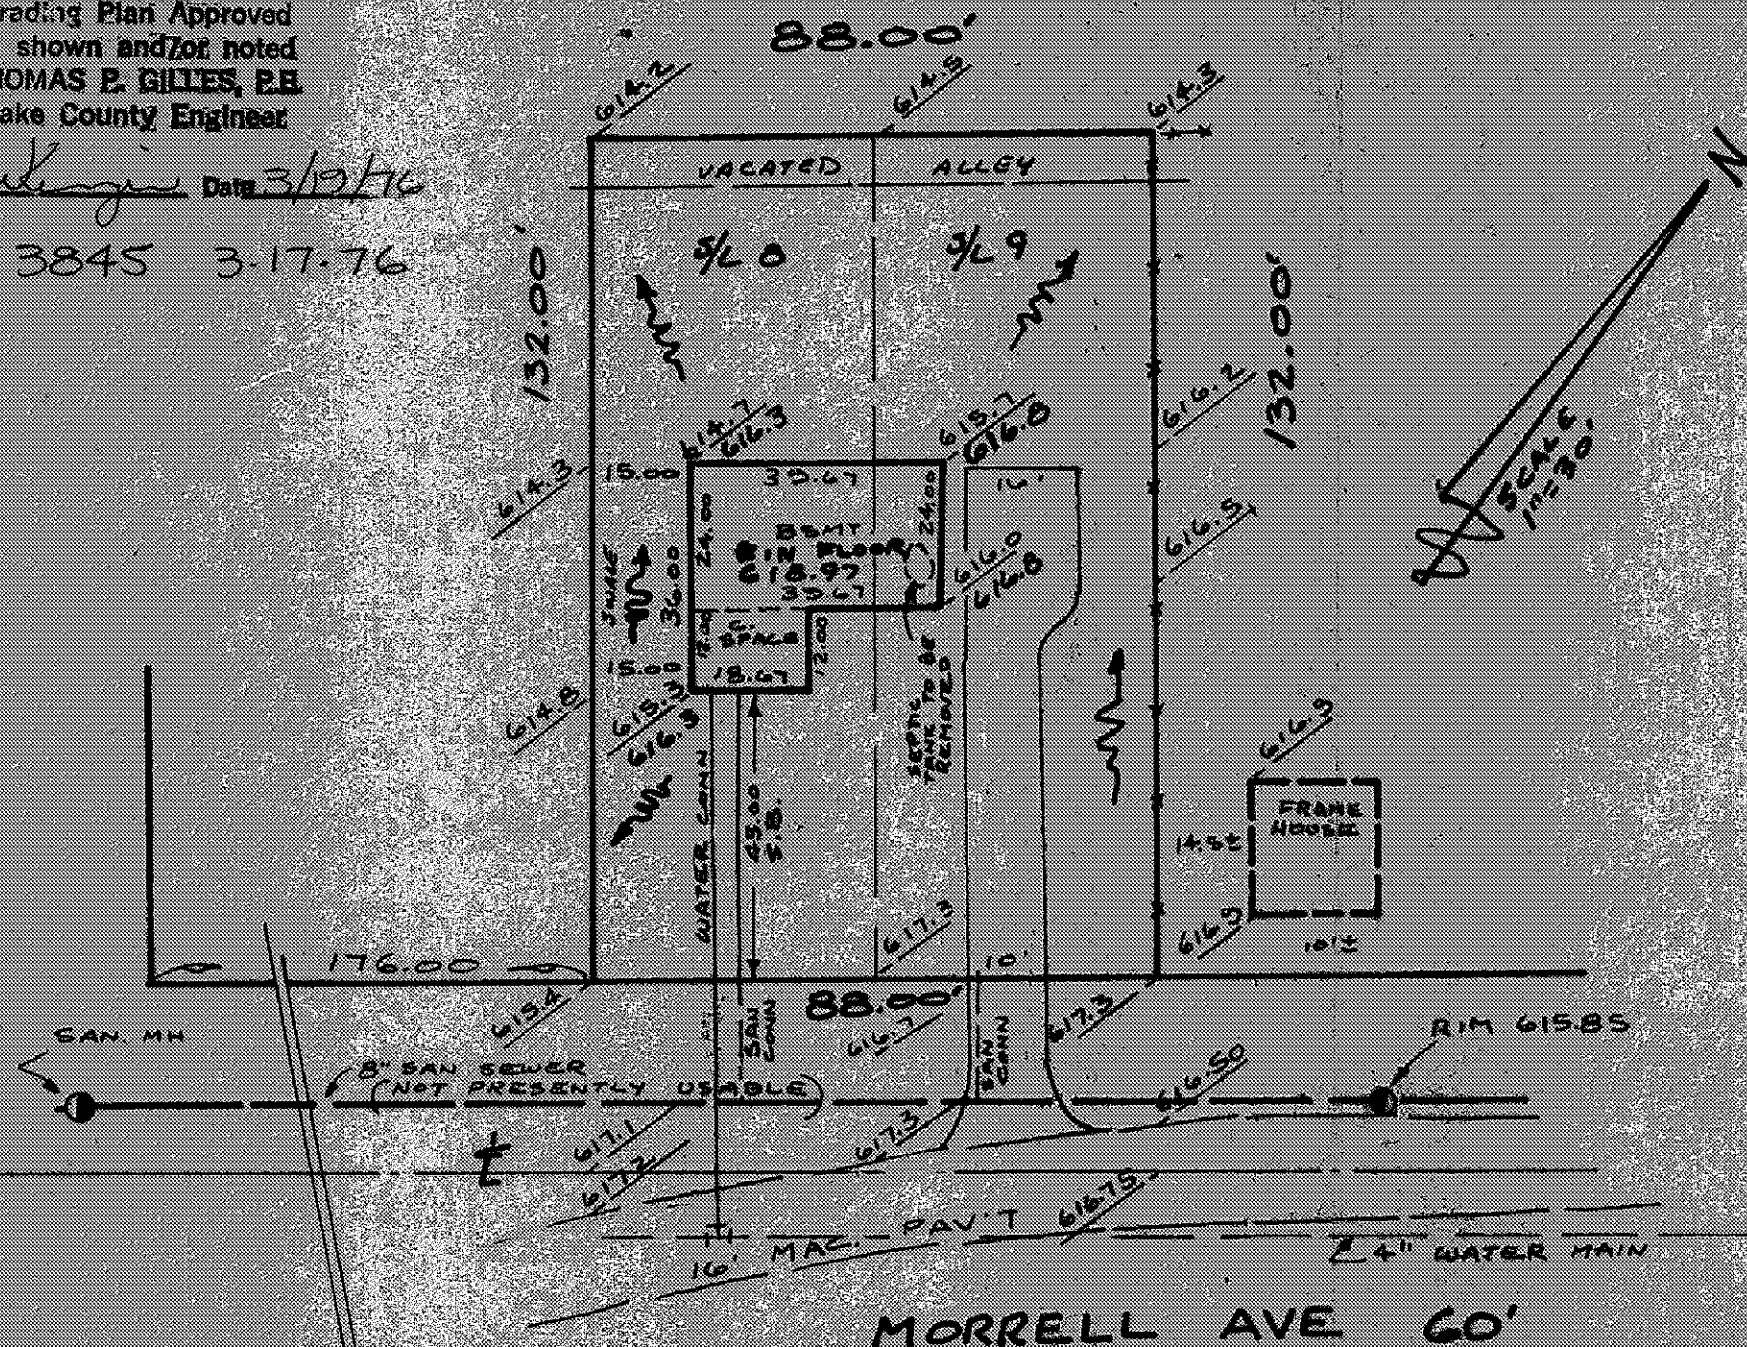

"AS BUILT" CERTIFICATION
I, HEREBY CERTIFY THAT THE CIRCLED GRADES ARE EXISTING FINISH
GRADES CHECKED IN FIELD ON *19* BY *ME*
SURVEYING AND ARE CORRECT TO THE BEST OF MY KNOWLEDGE AND BELIEF.

REGISTERED SURVEYOR

REG. NO.

SITE PLAN

PAINESVILLE **LAKE COUNTY, OHIO**
TOWNSHIP

for: **LOUIS MORVATH**
CLIENT OWNER

ADDRESS	STREET	CITY	ZIP
<i>Q.E. MEIGGS</i>			
SUBDIVISION	A. 37	NAME	
<i>8.3</i>	VOL. - PG.	<i>MORRELL</i>	
SUBLOT NO.	STREET	PERM. PARCEL NO.	STREET

LEGEND

SANITARY MANHOLE	-----○	WATER VALVE (GAS)	-----○
STORM MANHOLE	-----●	WATER METER (GAS)	-----○
INLET OR CATCH BASIN	-----■	AS BUILT ELEVATION	100.0
HYDRANT	-----○	INDICATES	
EXISTING CONTOURS	-----	DIRECTION OF	
PROPOSED CONTOURS	-----	SURFACE DRAINAGE	
EXIST. ELEV.	100.0	PROP. ELEV.	100.0

REMARKS

ALL BOUNDARY DATA SHOWN WAS OBTAINED FROM (DEEDS, RECORDED
SUBDIVISION PLAT OR OTHER PUBLIC RECORDS)
LOCATIONS AS SHOWN OF ADJACENT WELLS AND SEPTIC TANKS OBTAINED FROM
LAKE COUNTY HEALTH DEPARTMENT

DESIGN CERTIFICATION

THIS PLAT WAS PREPARED BY ME, AND IS CORRECT
TO THE BEST OF MY KNOWLEDGE AND BELIEF.

NAME *Robert J. Blake* SURVEYOR REGISTRATION NO.

CHECK LIST

NO. OF BEDROOMS	WATER MAIN SIZE, LOCATION
DIMENSIONS	SAN. SEWER SIZE % GR. LOC.
BEARINGS	SAN. MH. CAST, ELEV. INV. ELEV.
TIE TO NEAREST STREET	SAN. CONN. SIZE, LOC. DEPTH
SUBLOT NO. PARCEL NO.	STORM SEWER SIZE % GR. LOC.
SURROUNDING OWNERS	STORM MH. CAST ELEV. INV. ELEV.
BLDG. DIMENSIONS FIN. GR.	PAVT TYPE GRADE CURBS
BLDG. TIES FLTR. GRADES	GAS LINE LOC. SIZE PRESSURE
APRON TYPE WIDTH THICKNESS	SEPTIC TANK LOCATION & DUPLICATION AREA
SIDEWALK TYPE WIDTH THICKNESS	WELL LOCATION
CULVERT TYPE DIA. LENGTH	ISOLATION RADIUS FROM WELL
ROCK OUTCROPPINGS	

REVISIONS

NO.	DATE	BY
1	19 MAR 76	RL
2		
3		
4		
5		

PLAN PREPARED BY:

DEBEVEC-SALO & ASSOCIATES, INC.

130 EAST JACKSON ST. PAINESVILLE, OHIO

DRAWN BY <i>DE</i>	SCALE <i>1"=30'</i>	PHONE NO.
CHK'D. <i>DE</i>	DATE <i>MAR 12 76</i>	DRAWING NO.
CREW CHIEF	APP'D	<i>4620</i>