

SITE PLAN

PAINESVILLE TWP. LAKE COUNTY, OHIO

for: KNEZ BUILDERS

CLIENT _____ OWNER _____
ADDRESS _____ STREET _____ CITY _____ ZIP _____

MISTY MEADOWS
SUBDIVISION **26-25** NAME _____ TRACT _____ STREET _____
VOL.-Pg. _____ LOT _____
24 SUBLOT NO. _____ MEADOWLARK DR. VOL.-Pg. _____ PERM. PARCEL NO. _____

LEGEND

SANITARY MANHOLE --- ---
STORM MANHOLE --- ---
INLET OR CATCH BASIN --- ---
HYDRANT --- ---
EXISTING CONTOURS --- ---
PROPOSED CONTOURS --- ---

AS BUILT ELEVATION
INDICATES DIRECTION OF SURFACE DRAINAGE

EXIST. ELEV. \rightarrow 100.0
100.0 \pm 2' PROP. ELEV.

REMARKS

ALL BOUNDARY DATA SHOWN WAS OBTAINED FROM (DEEDS, RECORDED SUBDIVISION PLAT OR OTHER PUBLIC RECORDS)

LOCATIONS AS SHOWN OF ADJACENT WELLS AND SEPTIC TANKS OBTAINED FROM LAKE COUNTY HEALTH DEPARTMENT

DESIGN CERTIFICATION

THIS PLAT WAS PREPARED BY ME, AND IS CORRECT TO THE BEST OF MY KNOWLEDGE AND BELIEF.

NAME Harry S. Jones, Jr. SURVEYOR REGISTRATION NO. #6343

CHECK LIST

NO. OF BEDROOMS _____
DIMENSIONS _____
BEARINGS _____
TIE TO NEAREST STREET _____
SUBLOT NO. PARCEL NO. _____
SURROUNDING OWNERS _____
BLDG. DIMENSIONS FIN GR. _____
BLDG. TIES FL'R. GRADES _____
APRON TYPE WIDTH THICKNESS _____
SIDEWALK TYPE WIDTH THICKNESS _____
CULVERT TYPE DIA. LENGTH _____
ROCK OUTCROPPINGS _____

WATER MAIN SIZE, LOCATION _____
SAN. SEWER SIZE & GR. LOC. _____
SAN. MH. CAST. ELEV. INV. ELEV. _____
SAN. CONN. SIZE, LOC. DEPTH _____
STORM SEWER SIZE & GR. LOC. _____
STORM MH. CAST. ELEV. INV. ELEV. _____
PAVT TYPE GRADE CURBS _____
GAS LINE LOC. SIZE PRESSURE _____
SEPTIC TANK LOCATION & DUPLICATION AREA _____
WELL LOCATION _____
ISOLATION RADIUS FROM WELL _____

REVISIONS			PLAN PREPARED BY:		
NO.	DATE	BY	BABCOCK JONES & ASSOCIATES, INC.		
1			PAINESVILLE, OHIO		
2			DRAWN BY T.R.	SCALE 1"=20'	PHONE NO. 440-367-1811
3			CHK'D. H.J.	DATE 8/31/98	DRAWING NO. 93-130-24
4			CREW CHIEF K.J.	APP'D H.J.	
5					

"AS BUILT" CERTIFICATION
I, HEREBY CERTIFY THAT THE CIRCLED GRADES ARE EXISTING
FINISH GRADES CHECKED IN THE FIELD ON _____, 19____
AND ARE CORRECT TO THE BEST OF MY KNOWLEDGE AND BELIEF.

REGISTERED SURVEYOR _____ REG. NO. _____

TBM-TOP HYDRANT S/L 22
ELEV.=621.07


C1: R=230.00' C2: R=30.00'
A=53.81' A=41.11'
C=53.69' C=37.97'
N61°24'28"W S86°02'13"W

Grading Plan Approved
as shown and/or noted
THOMAS P. GILLES, P.E.
Lake County Engineer

By 6JH Date 9.8.98



APPROVED
PAINESVILLE TOWNSHIP
ZONING DEPARTMENT
19980260
D. H. Hest

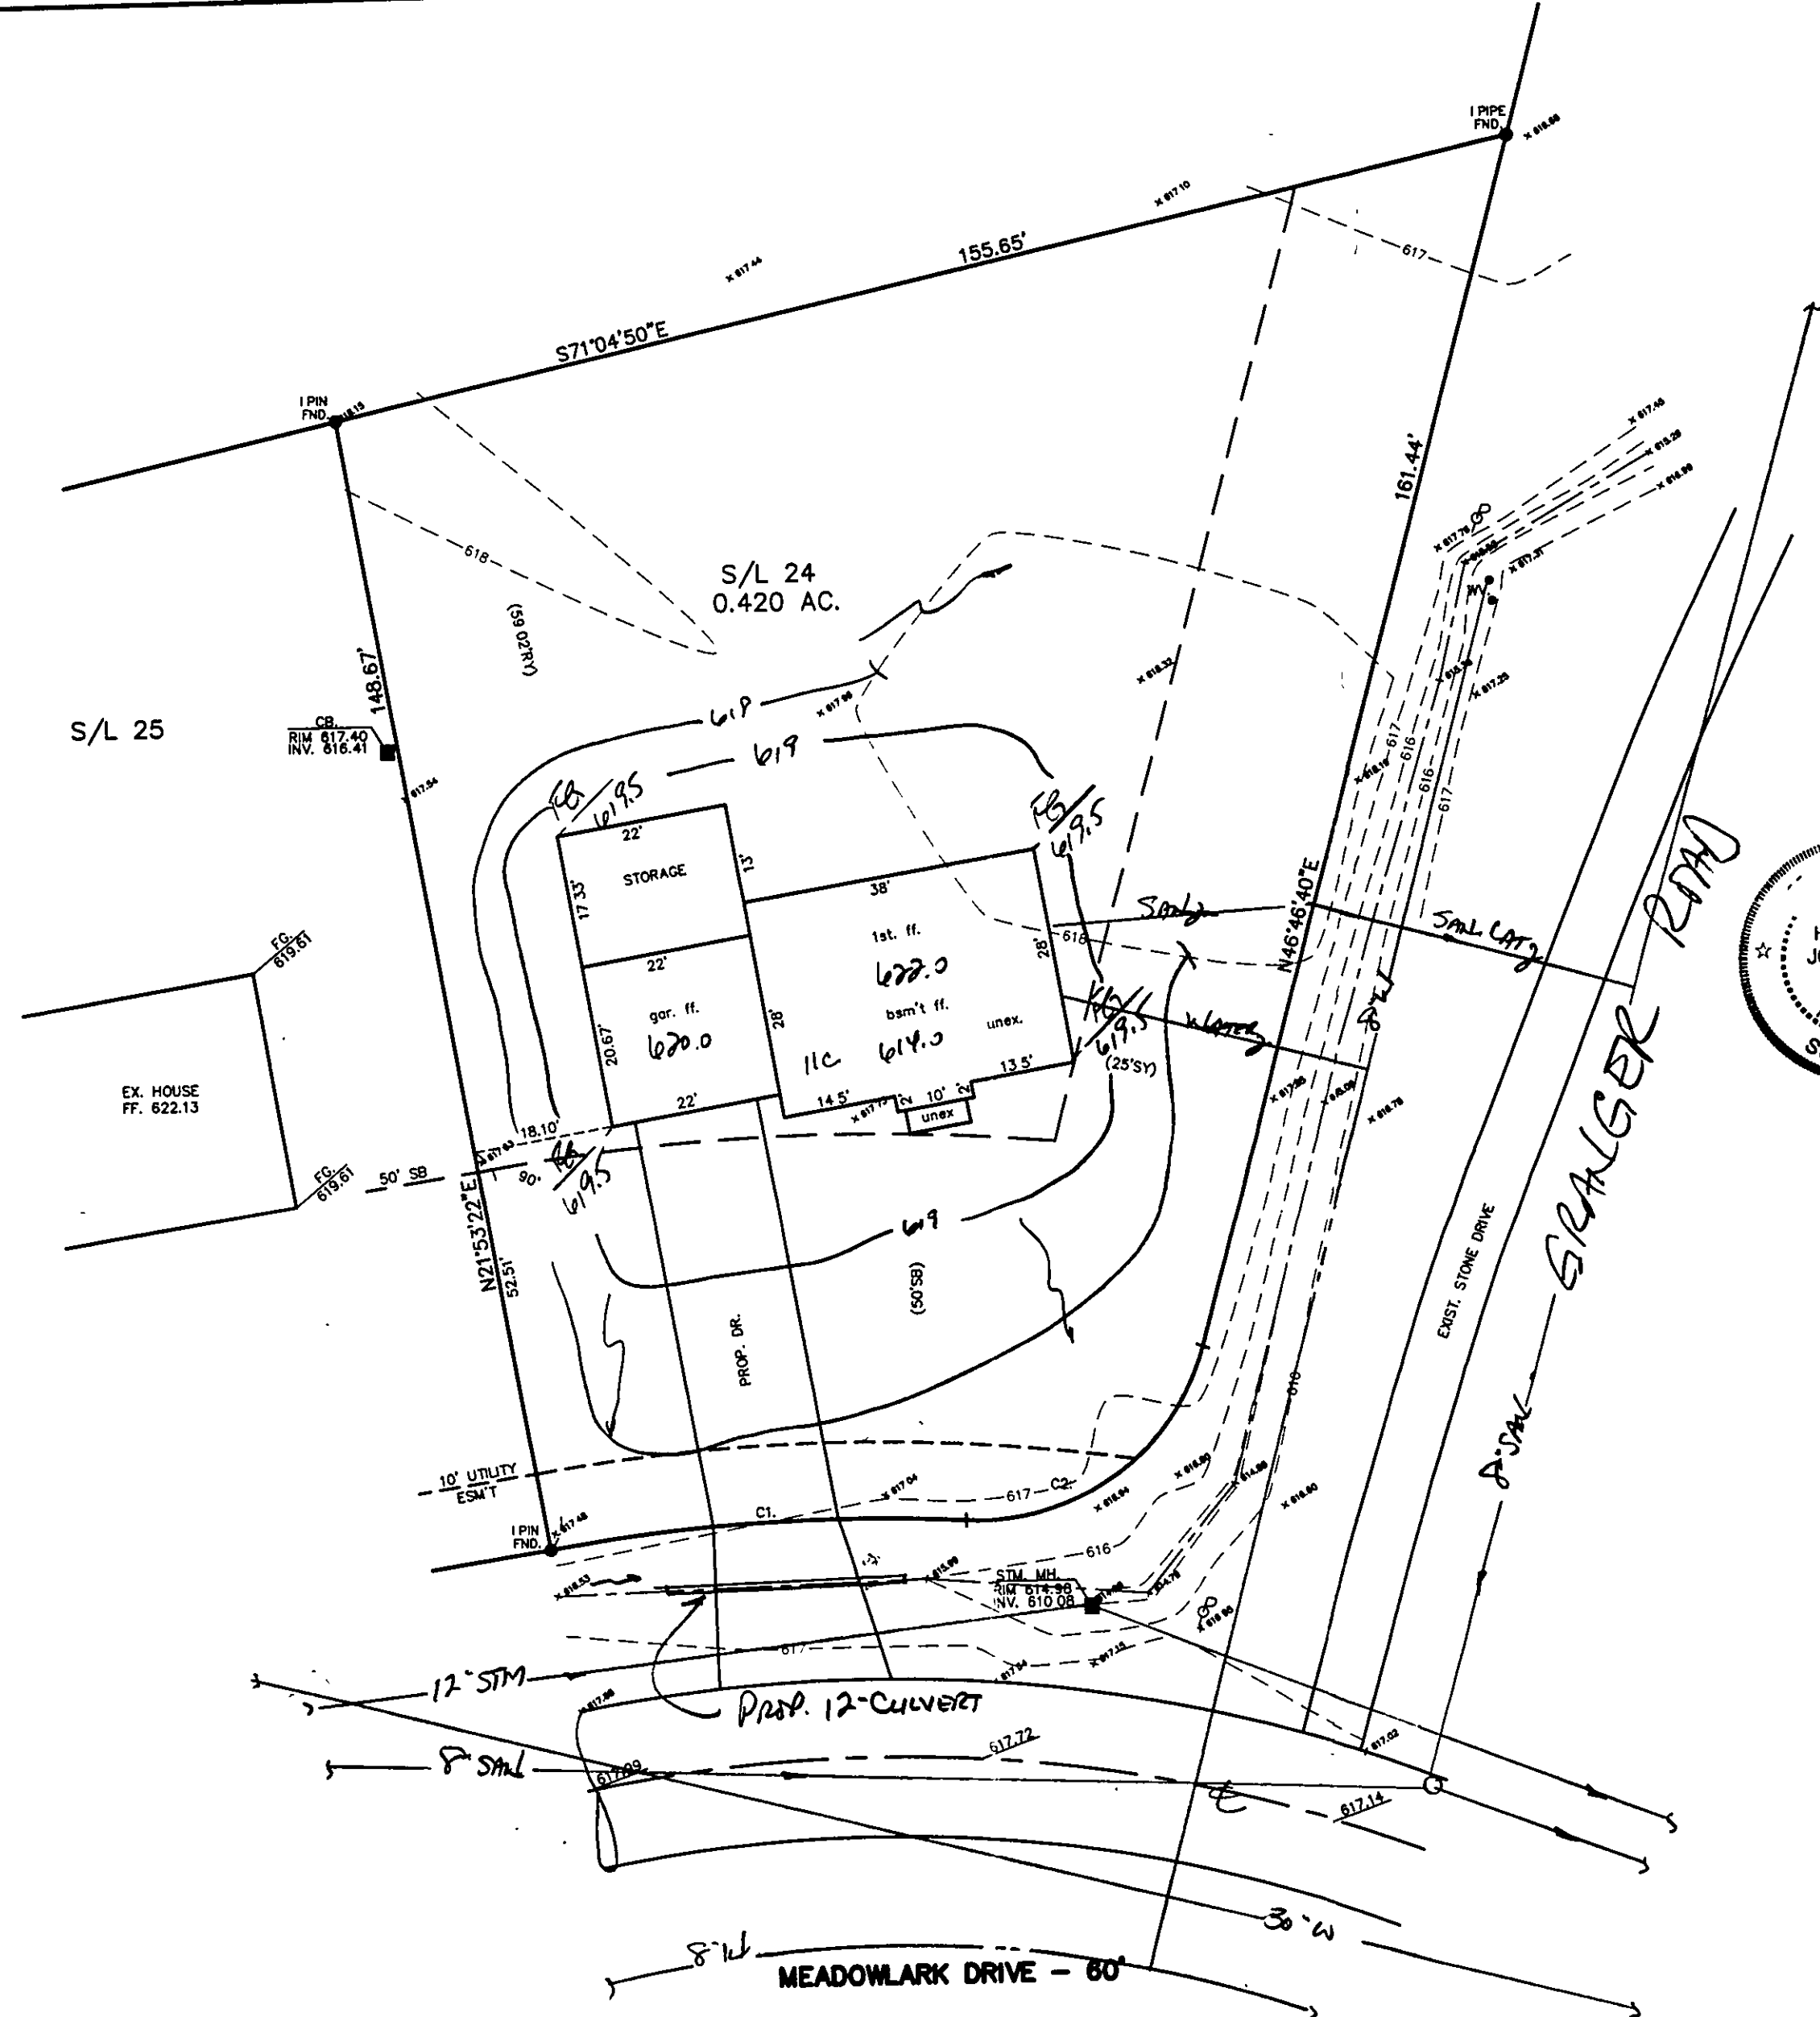

SAN. MH.
RIM 617.67
INV. 616.41

(TBM)